
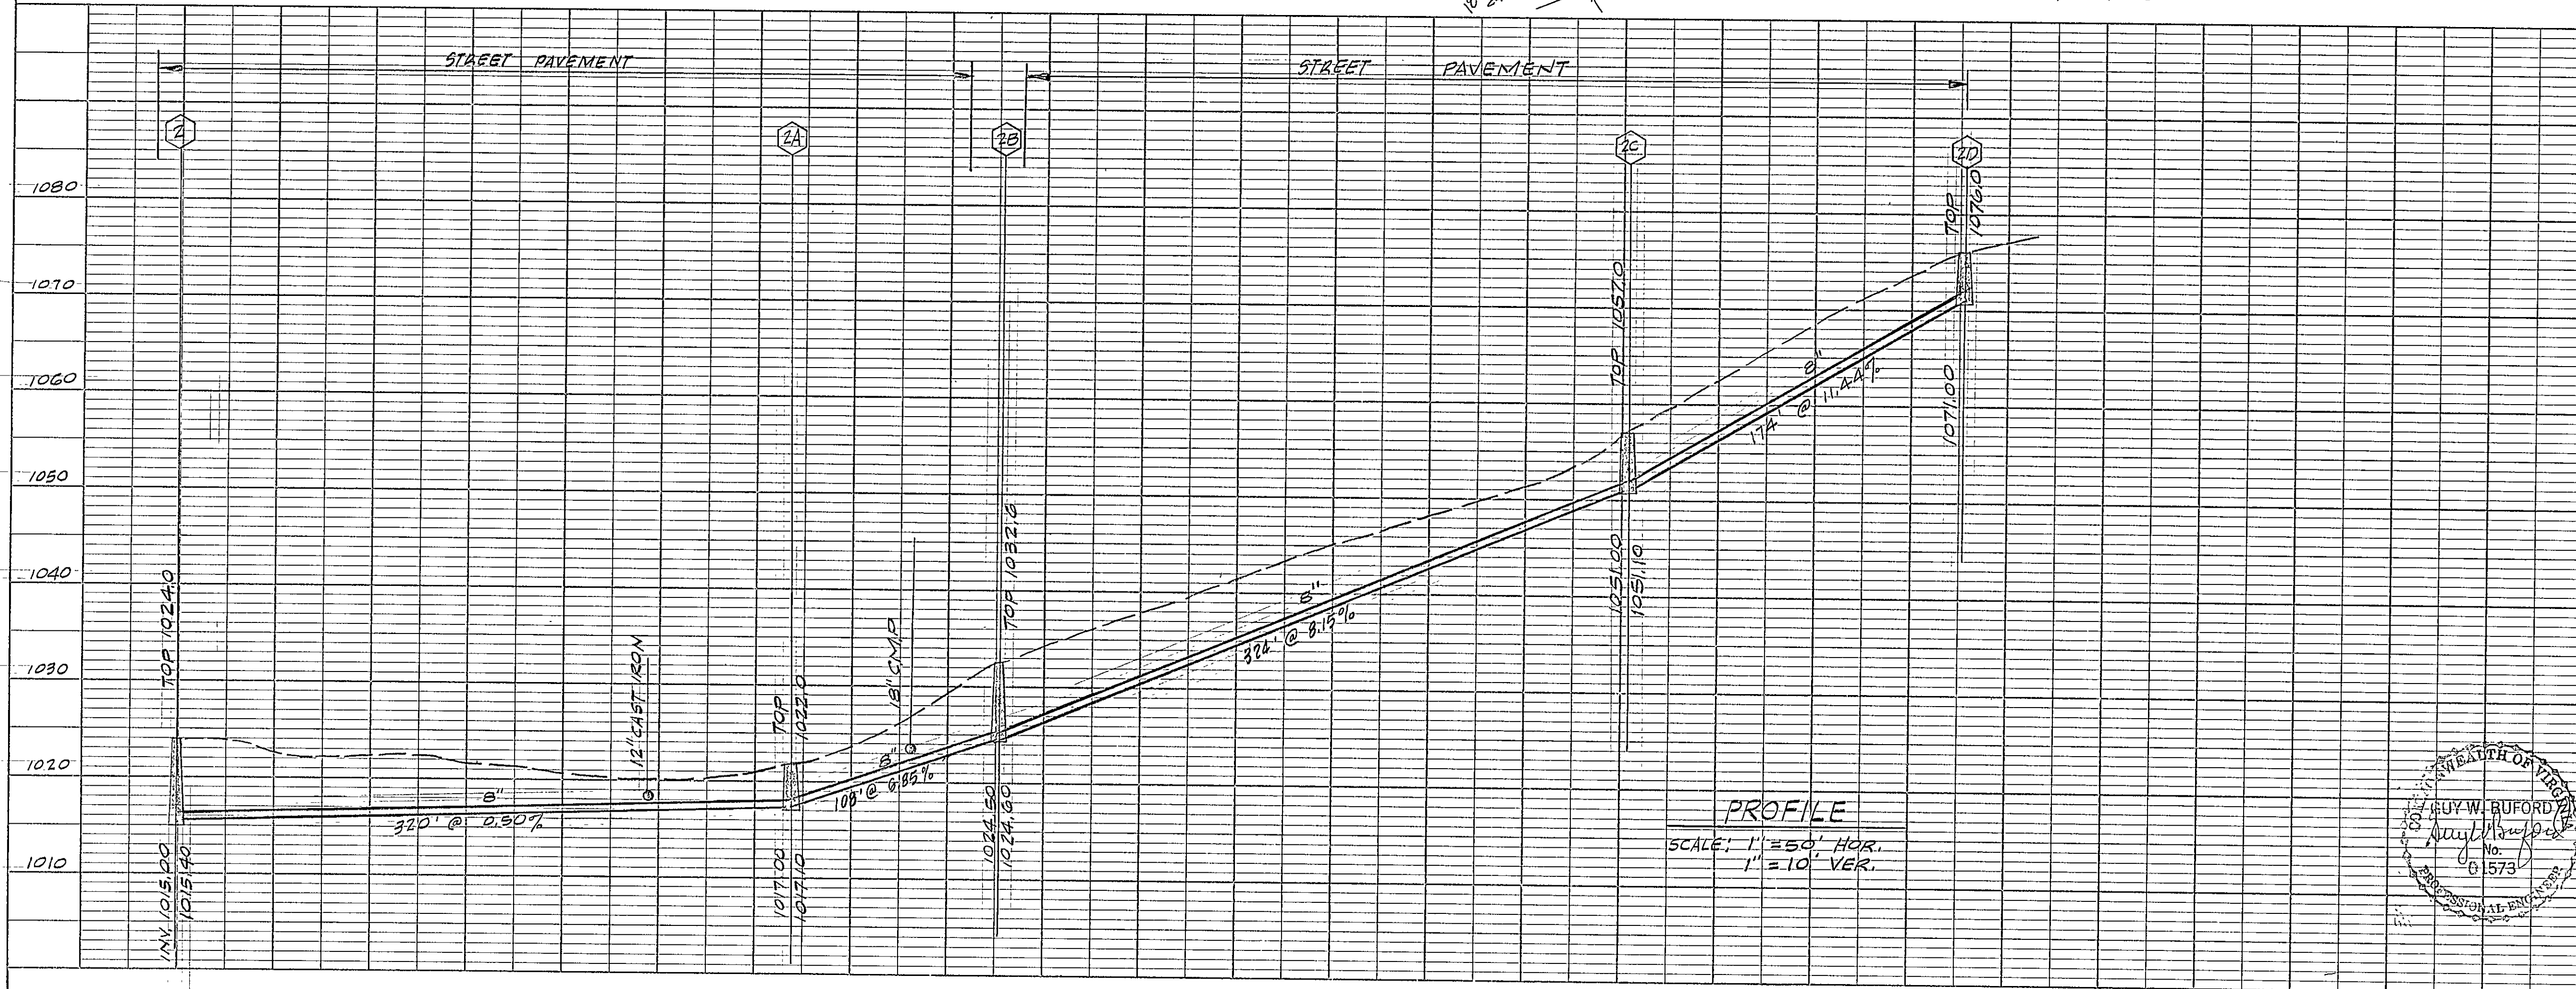
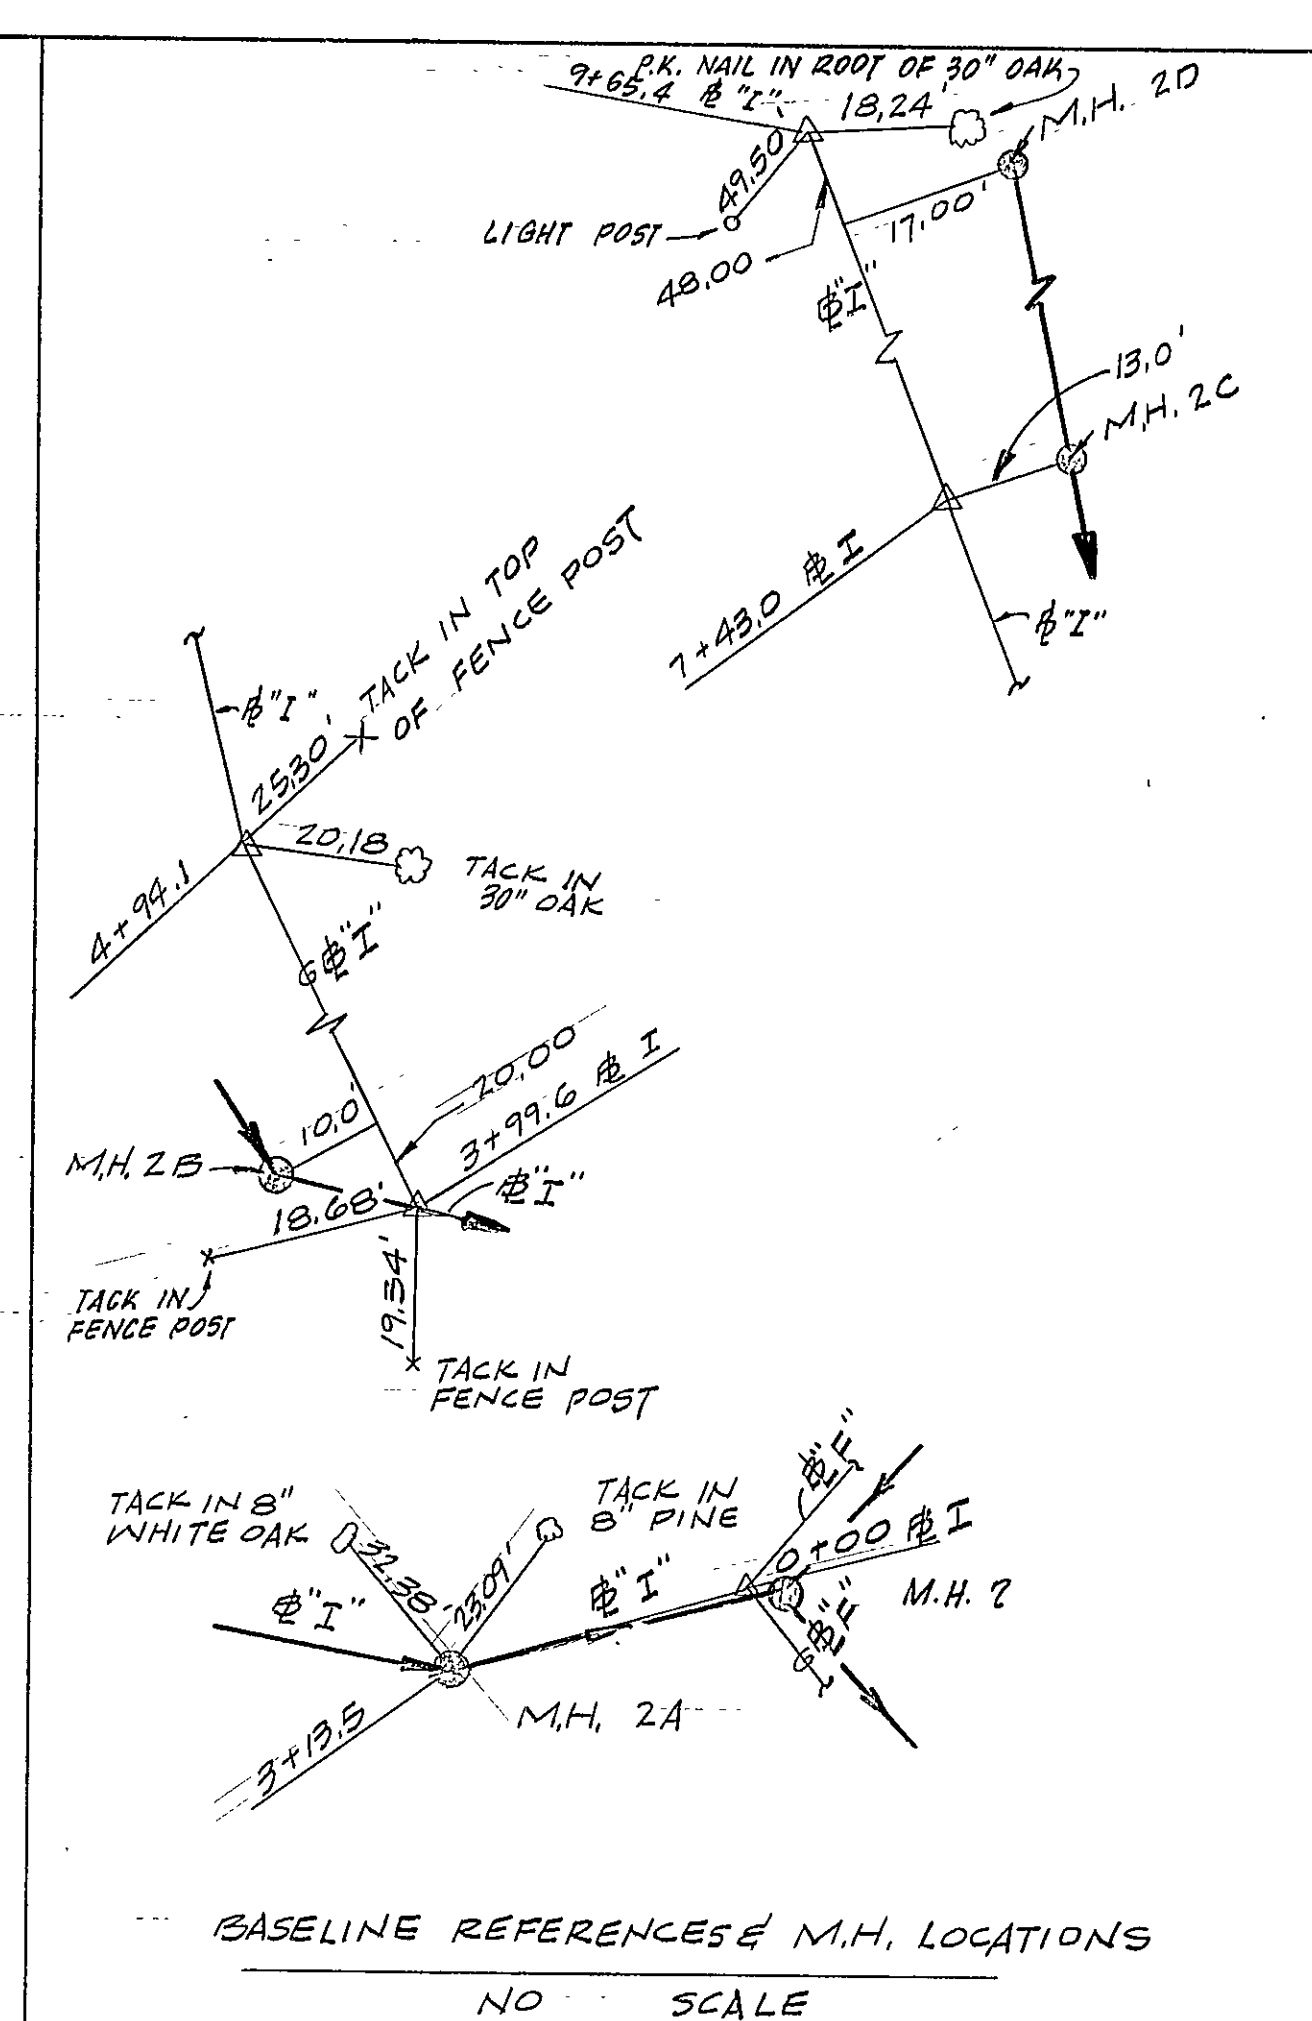


PLAN	SURVEYED	DATE
NOTE BOOK	BY	
NO.		

PROFILE	SURVEYED	DATE
NOTE BOOK	BY	
NO.		

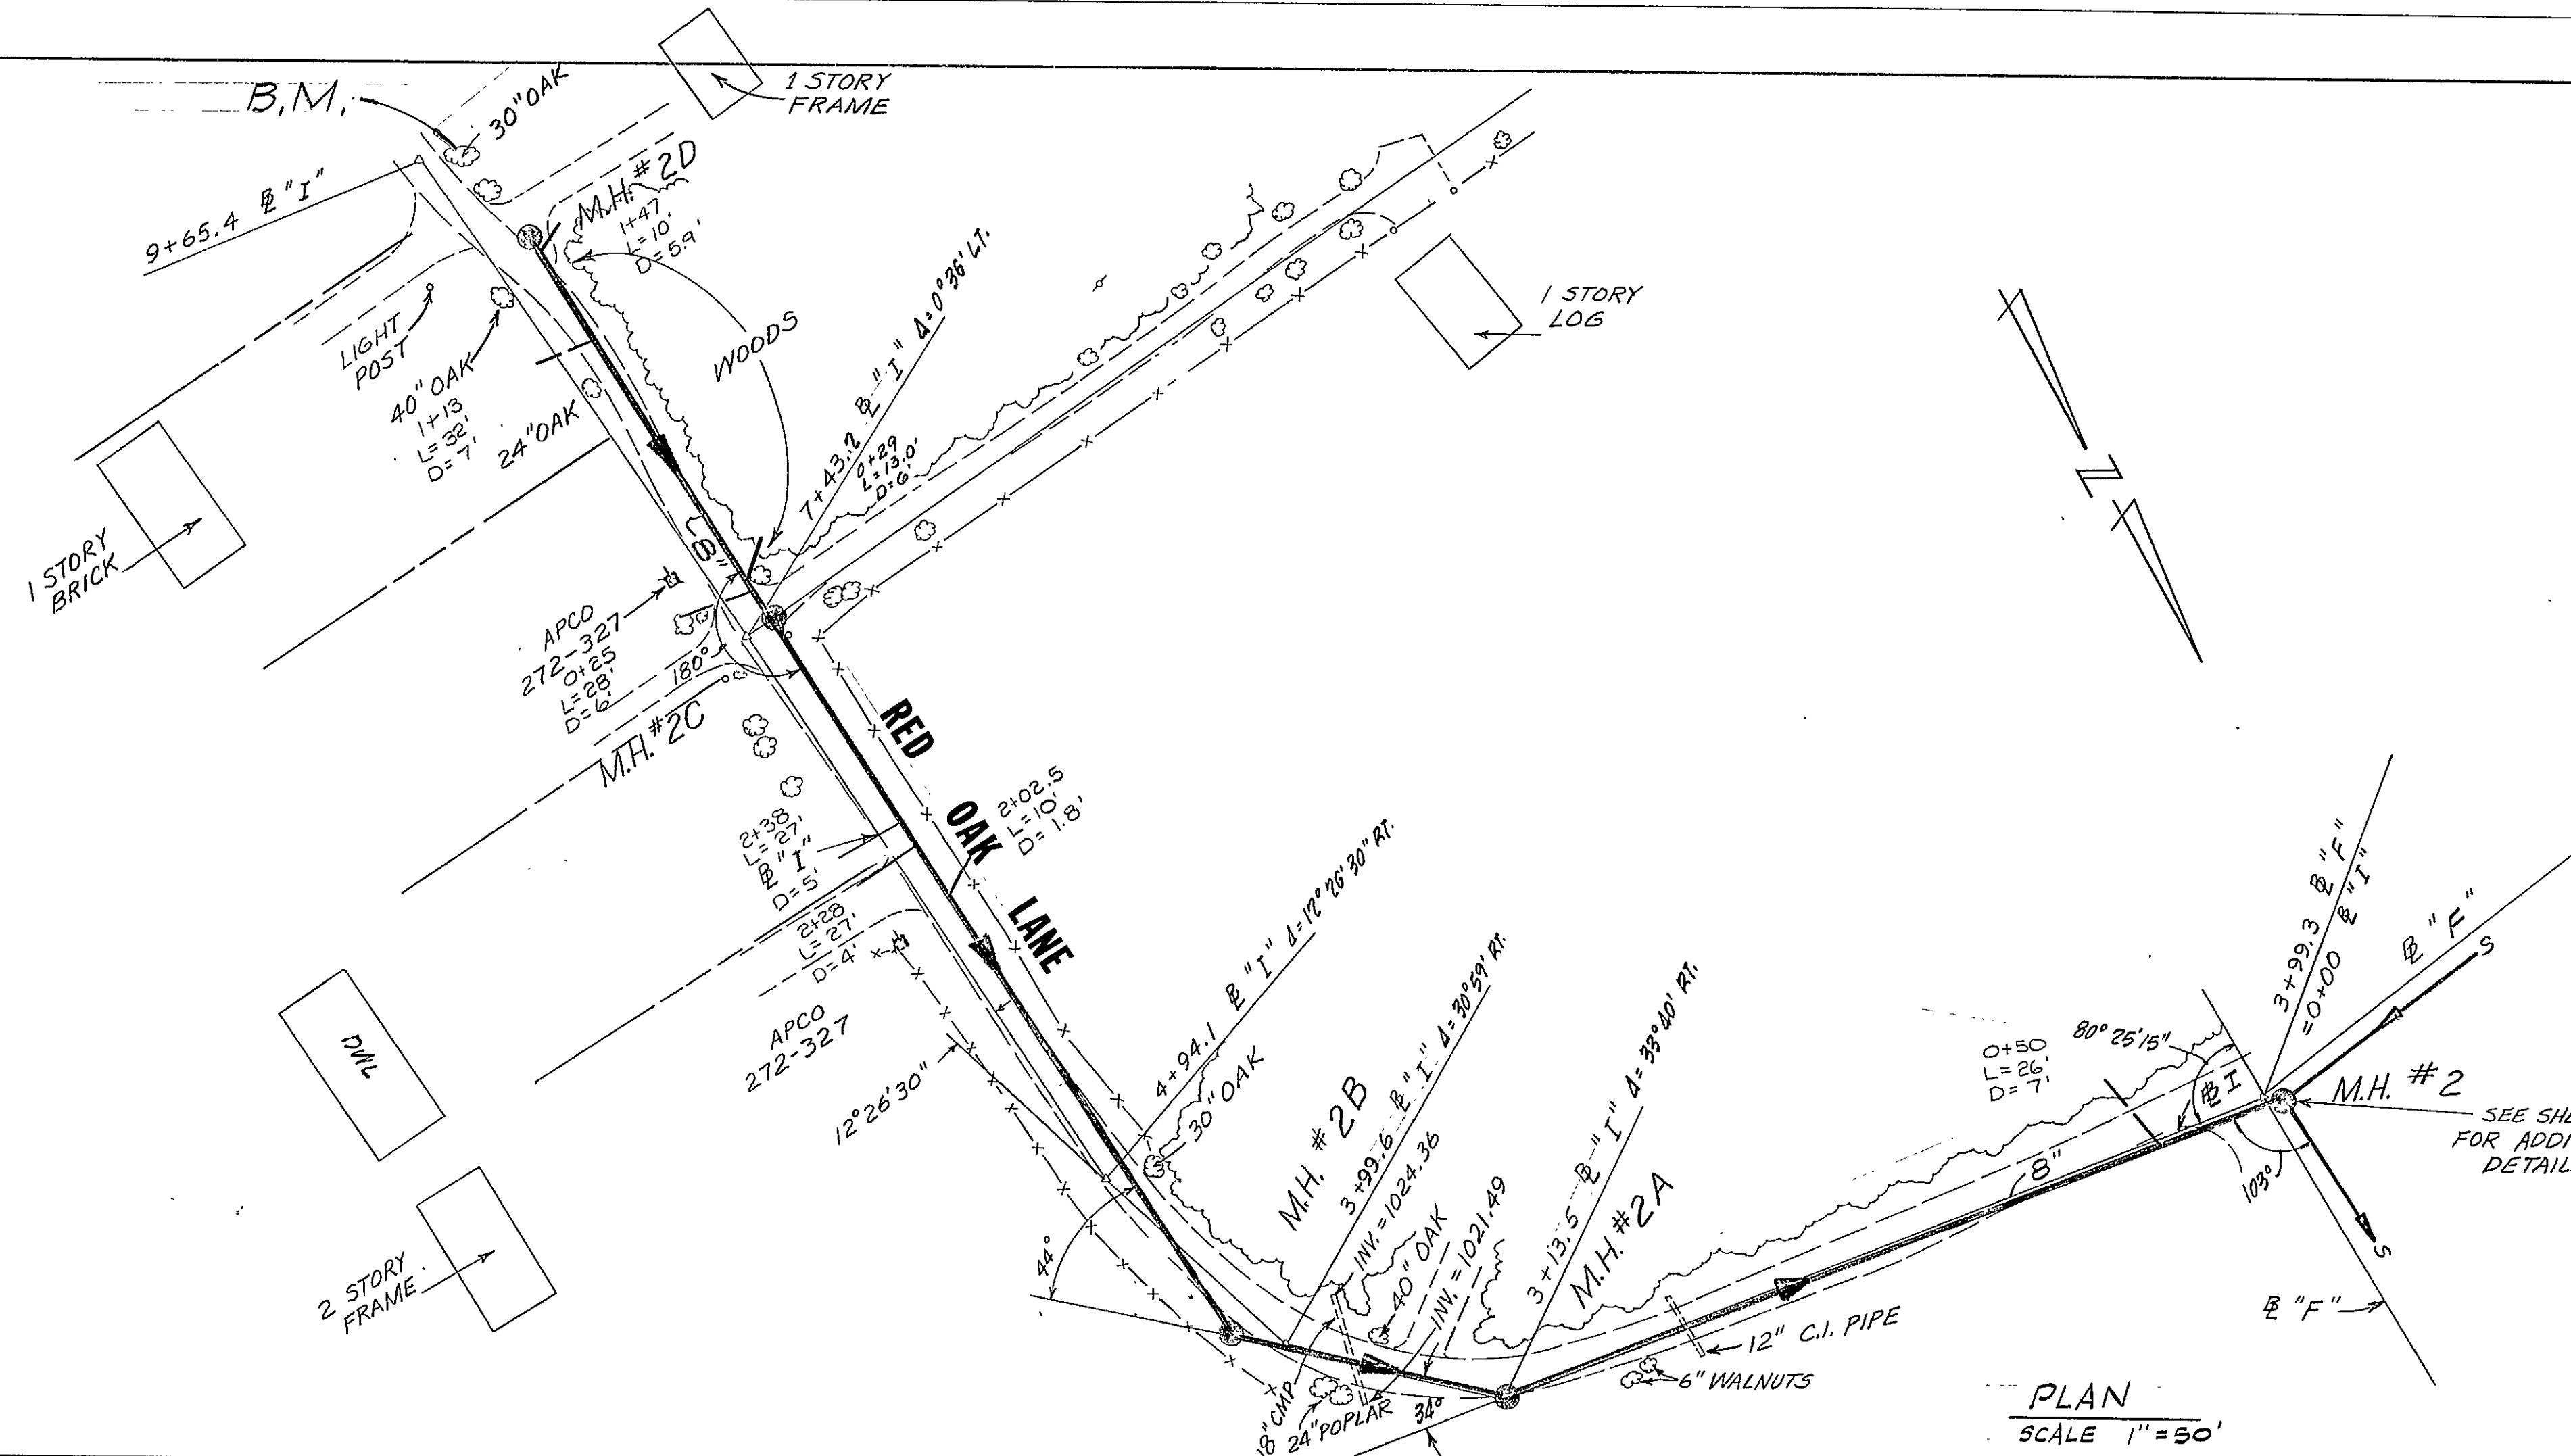

AS BUILT

PLAN & PROFILE
OF
**CRAVENS-BARNHART
SEWAGE COLLECTION SYSTEM**

PROJECT II
LINE I

CITY OF ROANOKE, VIRGINIA

SCALE: AS NOTED DATE: 17 OCT. 1980

BURODY, LUMSDEN & ASSOCIATES, P. C.
CERTIFIED LAND SURVEYORS
ROANOKE, VIRGINIA

PLAN NO. 5899 SHEET 7 OF 7