
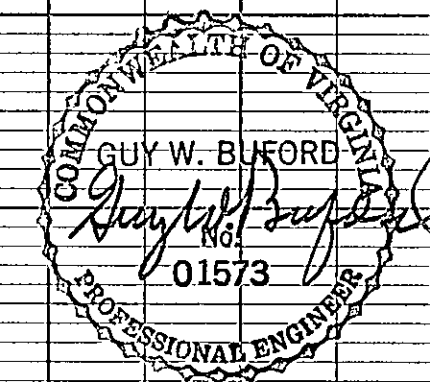
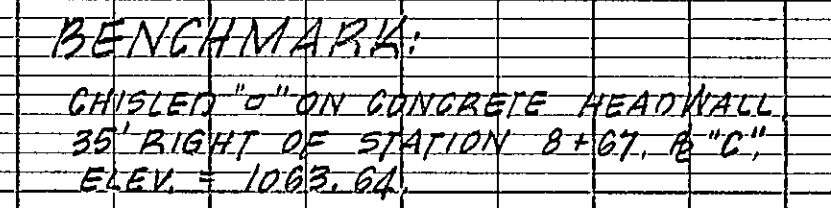


PROFILE		BY	DATE
SURVEYED _____			
PLOTTED _____			
GRADES CHECKED _____			
B. M. NOTED _____			
STRUCTURE NOTATIONS CHK'D _____			
NO. _____			

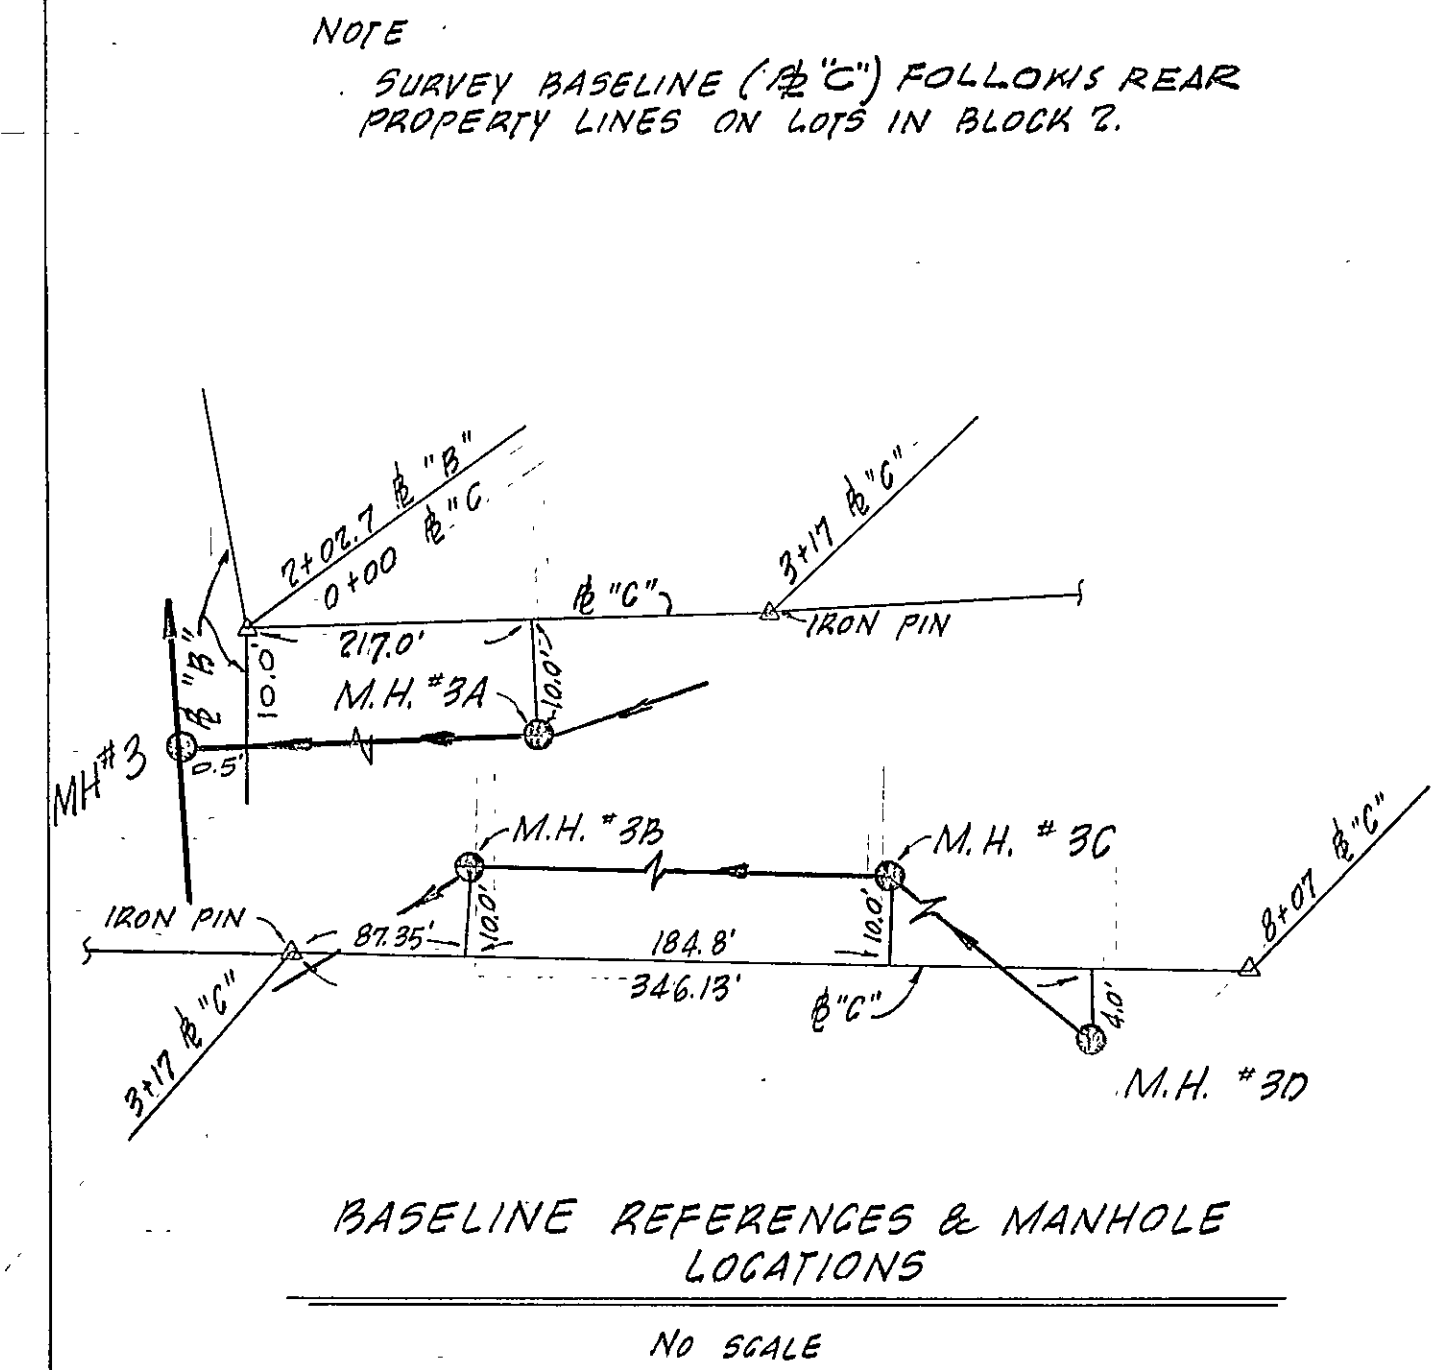

AS BUILT

PLAN & PROFILE
OF

CRAVENS-BARNHART

SEWAGE COLLECTION SYSTEM

PROJECT III
LINE C

CITY OF ROANOKE, VIRGINIA

SCALE: AS NOTED DATE: 21 NOV. 1980

U-FORD T. LUMSDEN & ASSOCIATES,
CERTIFIED LAND SURVEYORS
ROANOKE, VIRGINIA