
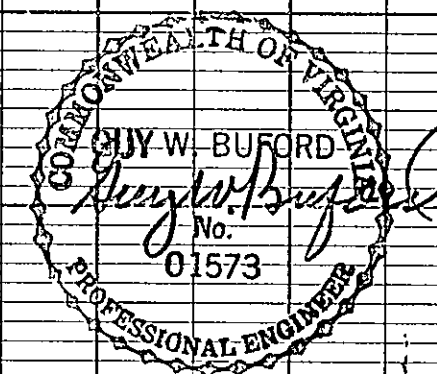


PROFILE	BY	DATE
SURVEYED		
PLOTTED		
GRADES CHECKED		
B. M. NOTED		
STRUCTURE NOTATIONS CHECKED		
NO		

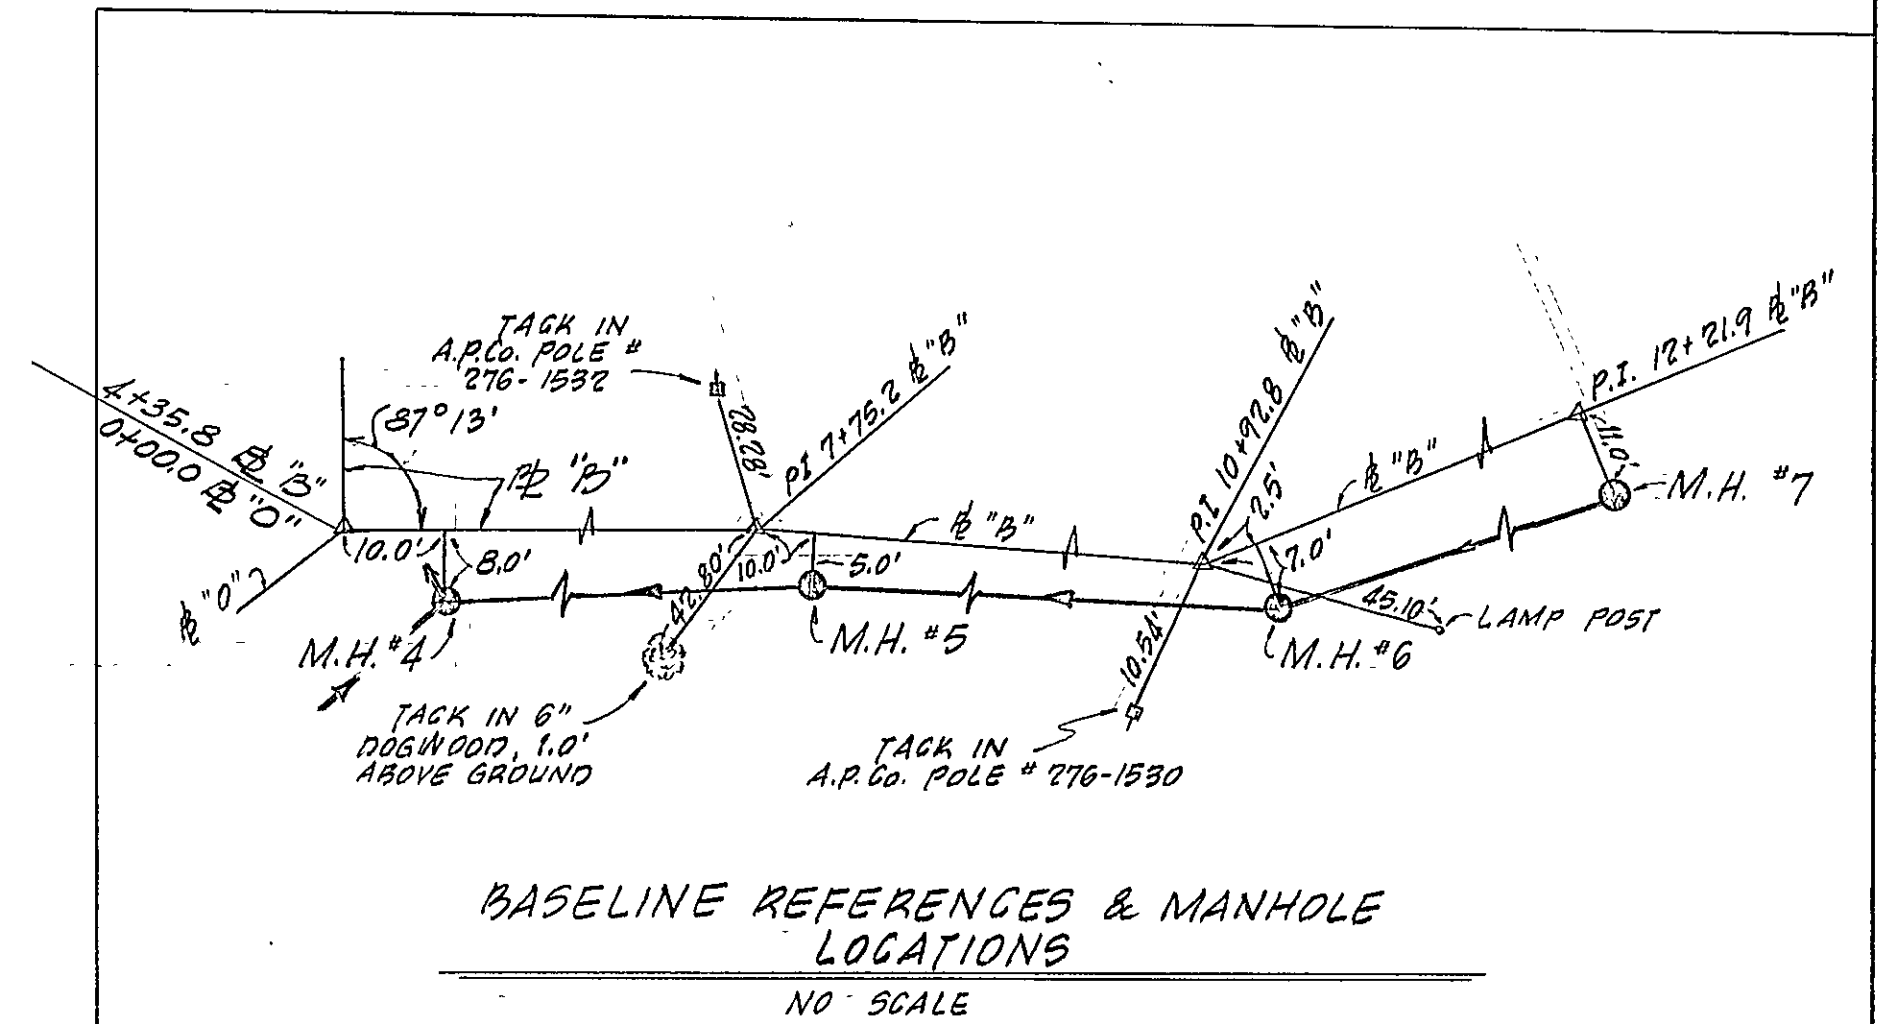

AS BUILT
AS BUILT

PLAN & PROFILE
OF

CRAVENS-BARNHART
SEWAGE COLLECTION SYSTEM

PROJECT III
LINE B

CITY OF ROANOKE, VIRGINIA

SCALE: AS NOTED DATE:

BUFFORD T. LUMSDEN & ASSOCIATES
CERTIFIED LAND SURVEYORS
ROANOKE, VIRGINIA