


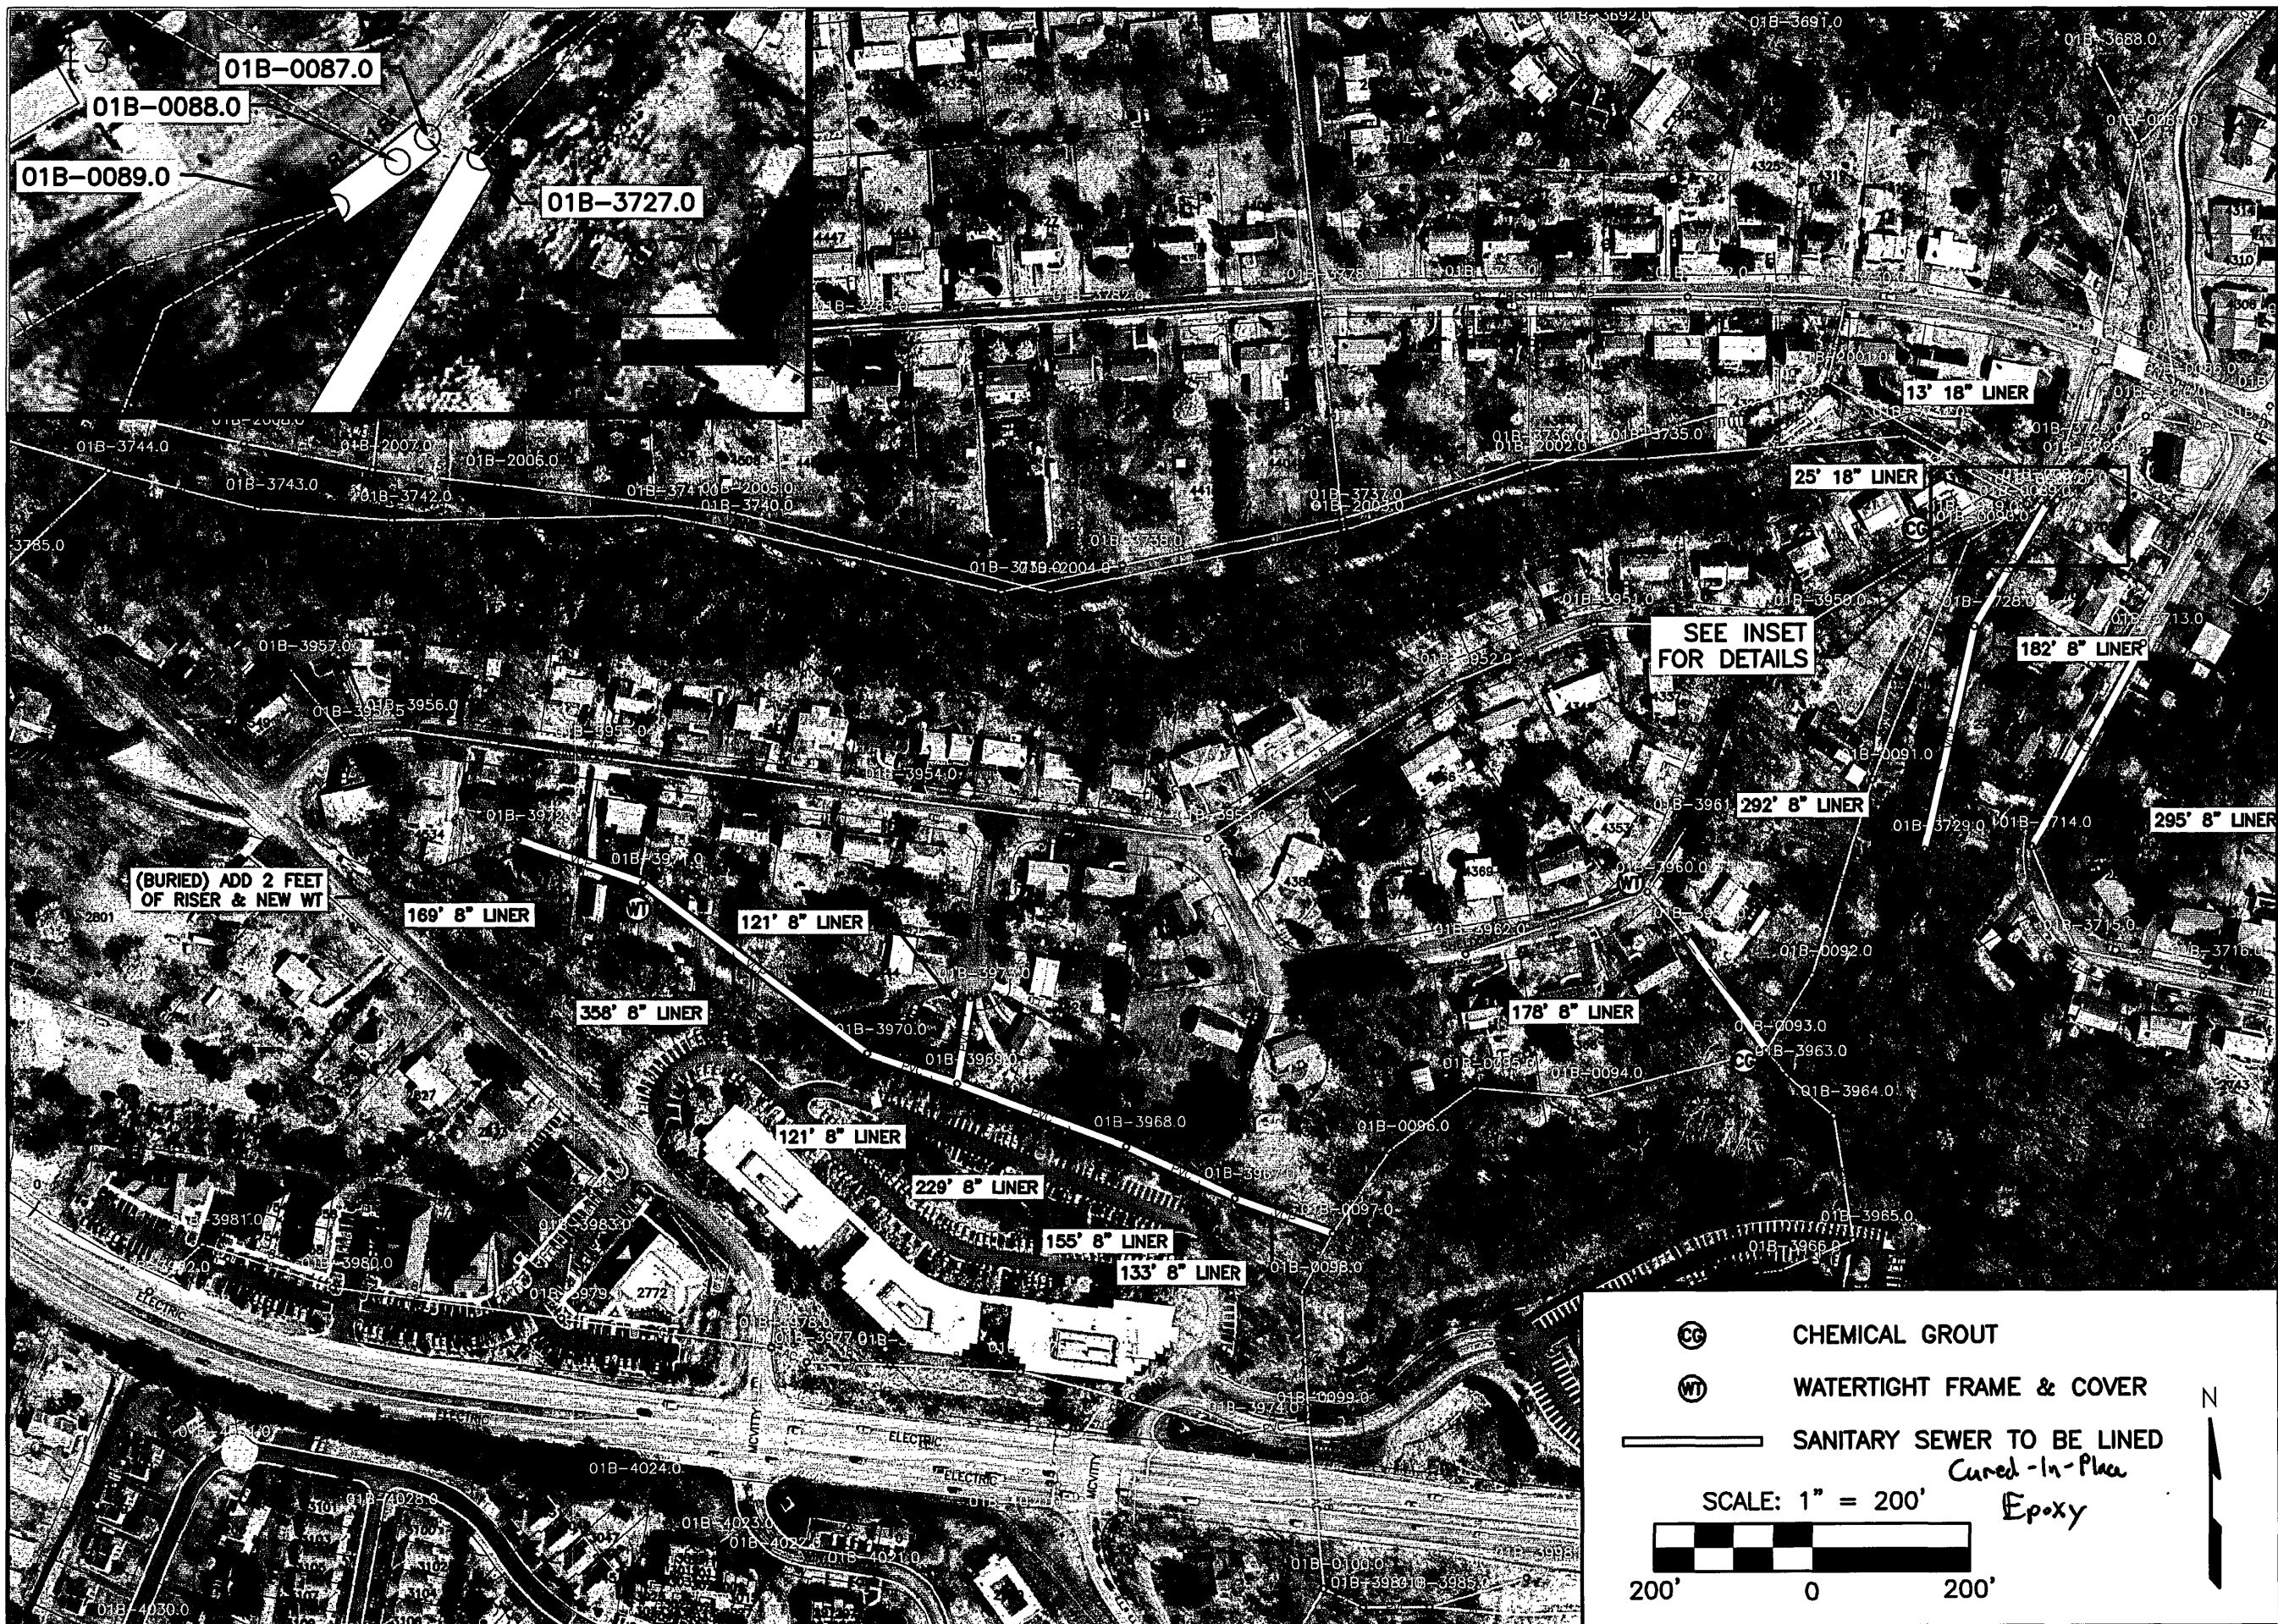

PROJECT		WWWA LINER PROJECTS 2009	
TITLE		AS-BUILT CRESTHILL-KIRKWOOD DRIVE SSR 10/01/10	
COMM. NO.		209050.00	
DRAWN	CHECKED	DWG. REFERENCE NO.	
BSH	WM	CRESTHILL_KIRKWOOD_DRIVE.DWG	
SHEET TITLE		DATE	
12-09		REV.	