


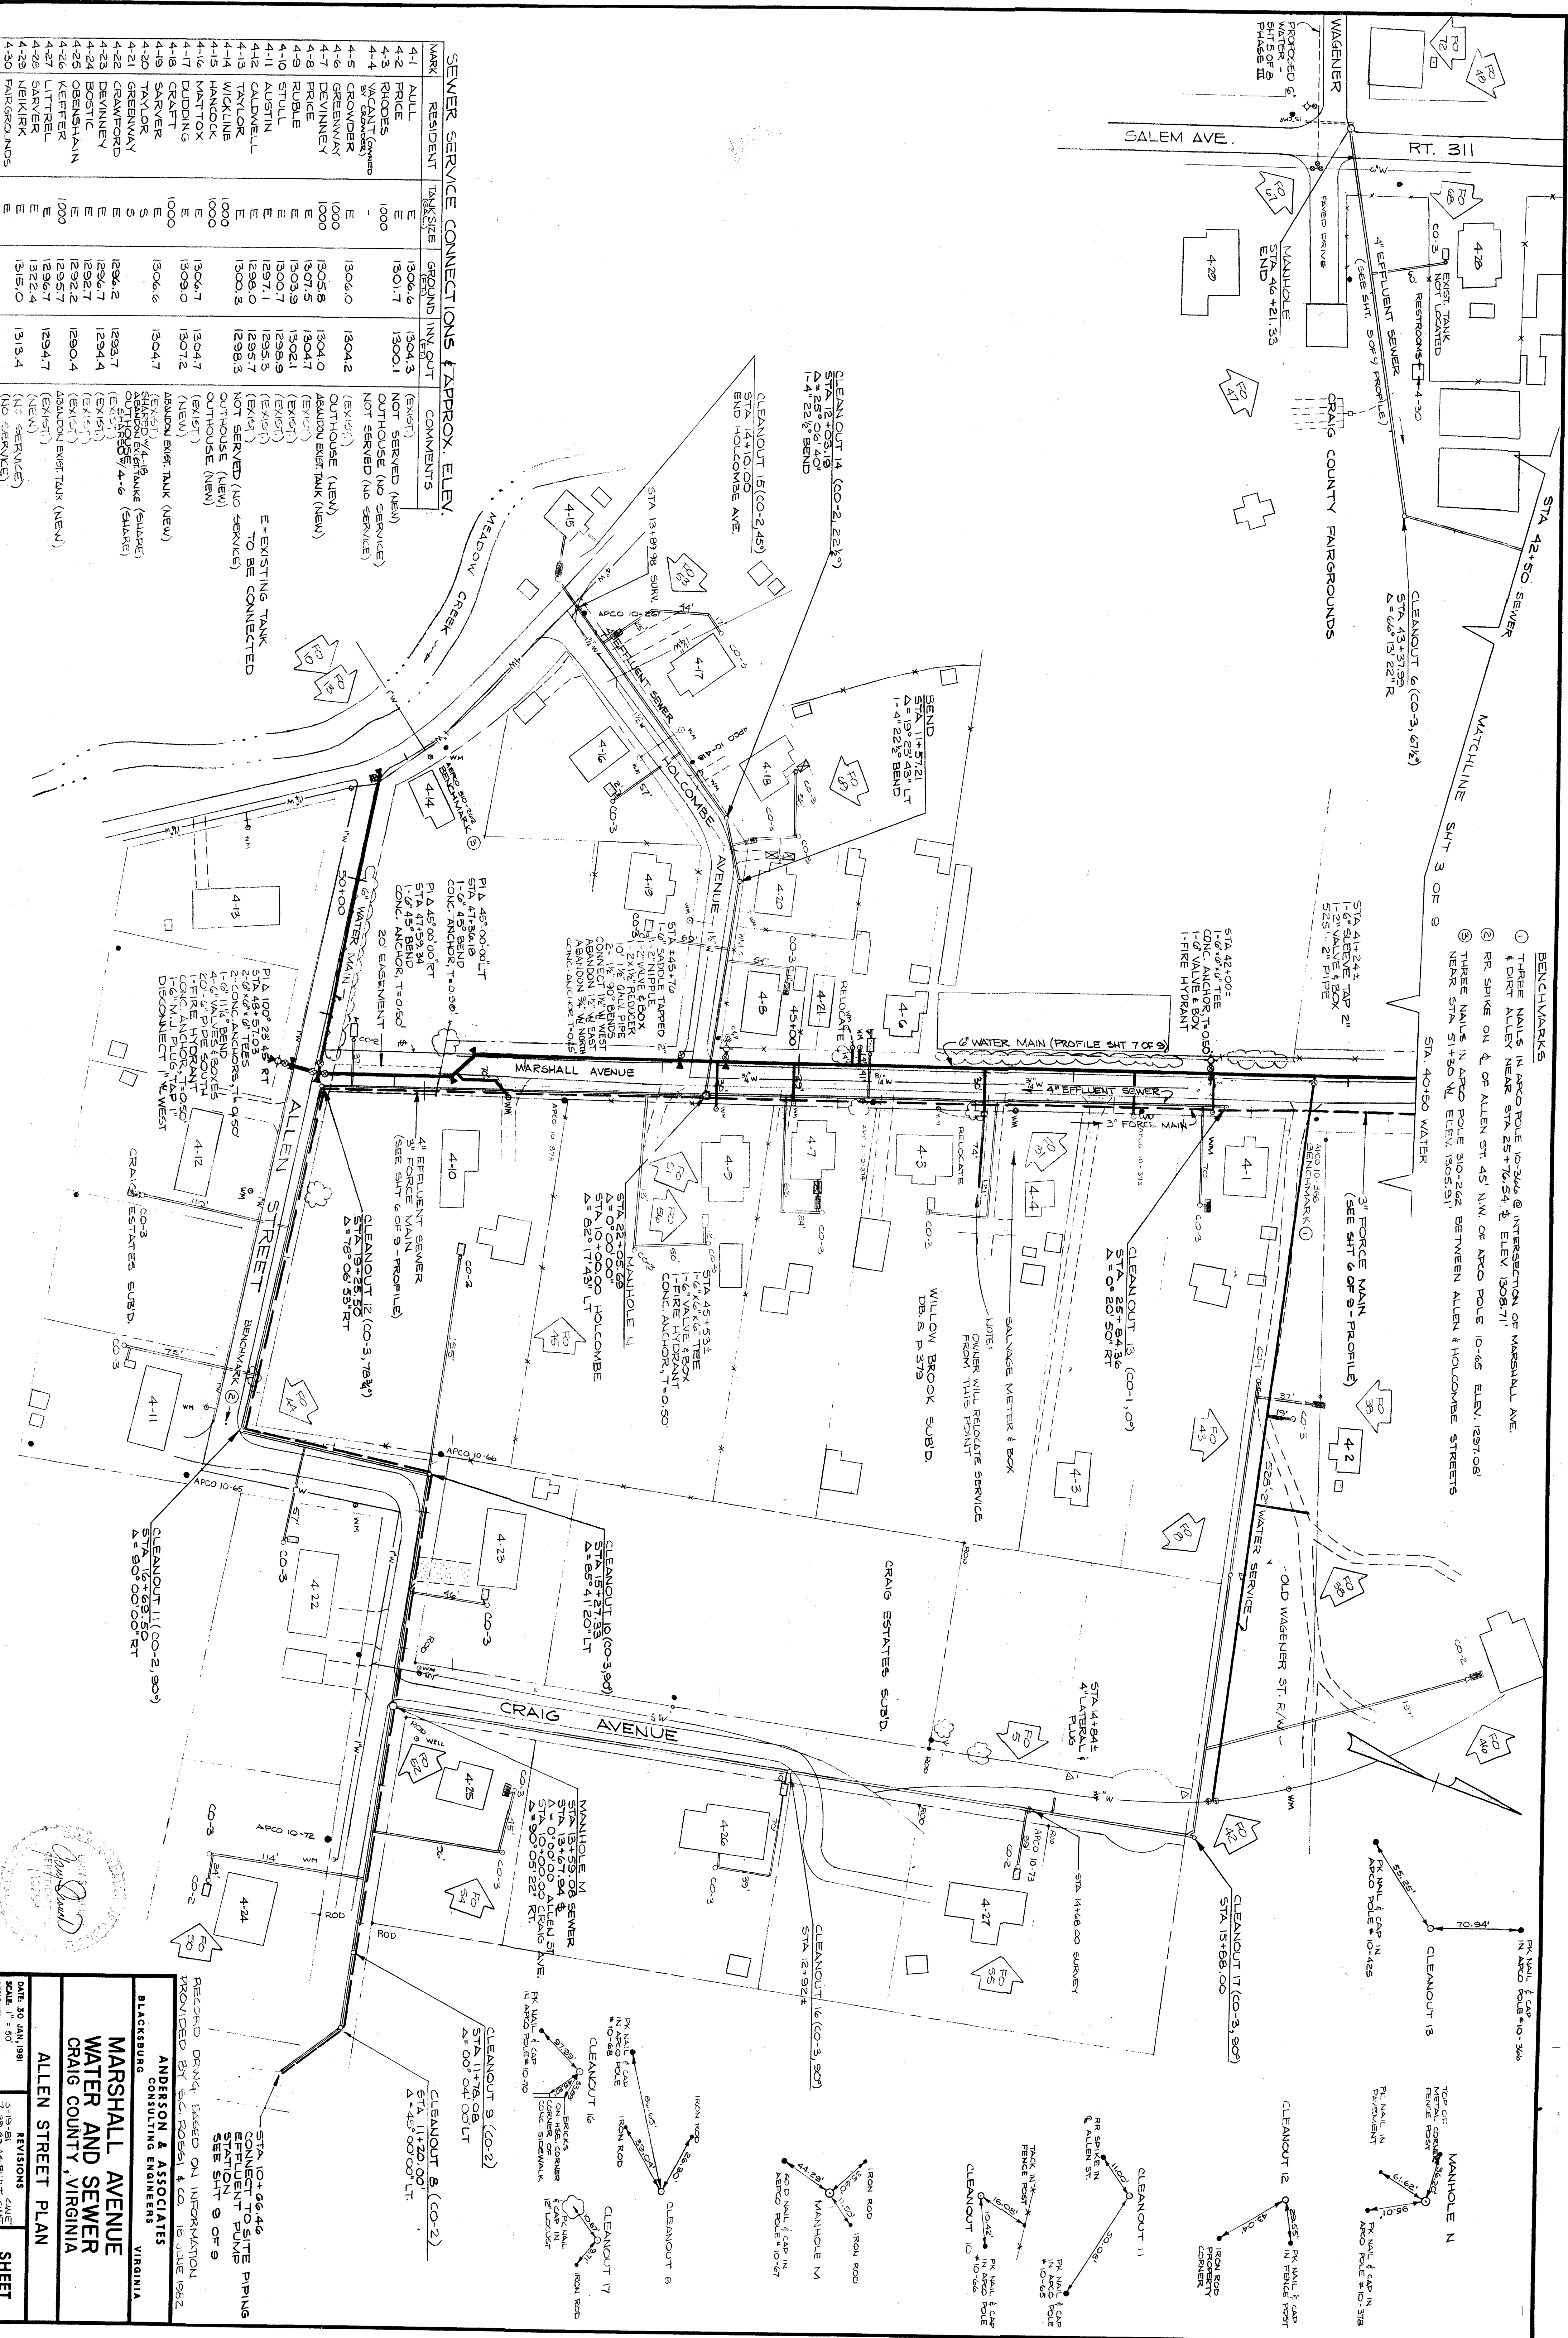

MARK	RESIDENT	TANK SIZE	GROUND ELEV.	INK. OUT	COMMENTS
4-1	AULL	E	1306.6	1304.3	(EXIST)
4-2	PRICE	E	1301.7	1300.1	NOT SERVED (NEW)
4-3	RICHES	1000			OUTHOUSE (NO SERVICE)
4-4	VACANT CORNER	-			NOT SERVED (NO SERVICE)
4-5	CROWDER	E	1306.0	1304.2	(EXIST)
4-6	DEVINNEY	1000			OUTHOUSE (NEW)
4-7	DEVINNEY	E	1305.8	1304.0	(EXIST)
4-8	PRICE	E	1307.5	1304.7	(EXIST)
4-9	RUBLE	E	1303.9	1302.1	(EXIST)
4-10	STULL	E	1300.7	1298.9	(EXIST)
4-11	AUSTIN	E	1297.1	1295.3	(EXIST)
4-12	CAULWELL	E	1295.7	1293.0	(EXIST)
4-13	TAYLOR	E	1300.3	1298.3	NOT SERVED (NO SERVICE)
4-14	HANCOCK	1000			OUTHOUSE (NEW)
4-15	WICKLINE	E	1304.7	1304.7	(EXIST)
4-16	MATTOX	E	1309.0	1307.2	(EXIST)
4-17	DUDDING	E	1306.6	1304.7	(EXIST)
4-18	CRAFT	1000			ADDITION EFF. TANK (NEW)
4-19	SARVER	E	1304.7	1304.7	(EXIST)
4-20	TAYLOR	S	1296.2	1293.7	SHARED EFF. TANK (SHARED)
4-21	GREENWAY	E	1294.7	1294.4	SHARED EFF. TANK (SHARED)
4-22	CRAWFORD	E	1293.2	1290.4	SHARED EFF. TANK (SHARED)
4-23	DEVINNEY	E	1295.7	1293.0	(EXIST)
4-24	BOSTIC	E	1296.7	1294.7	(EXIST)
4-25	OBENSHAIN	E	1292.4	1290.4	(EXIST)
4-26	KEFFER	1000			ADDITION EFF. TANK (NEW)
4-27	LITTELL	E	1296.7	1294.7	(EXIST)
4-28	SARVER	E	1322.4	1294.7	(EXIST)
4-29	NEIKIRK	E	1315.0	1313.4	(NO SERVICE)
4-30	PARROTT	E			(NO SERVICE)

- BENCHMARKS**
- ① THREE NAILS IN ARCO POLE 10-346 @ INTERSECTION OF MARSHALL AVE. & DIRT ALLEY NEAR STA 25+76.54 ELEV. 1308.71'
 - ② RR SPIKE ON E. OF ALLEN ST. 45' N.W. OF ARCO POLE 10-65 ELEV. 1297.06'
 - ③ THREE NAILS IN ARCO POLE 310-262 BETWEEN ALLEN & HOLCOMBE STREETS NEAR STA 51+30.11 ELEV. 1305.91'

DATE 30 JAN, 1991
DESIGNED: GSC, GMS
DRAWN: GSC
CHECKED: GSC

REVISIONS
1-23-92 AS-BUILT CANS

**MARSHALL AVENUE
WATER AND SEWER
CRAIG COUNTY, VIRGINIA**

ALLEN STREET PLAN

**ANDERSON & ASSOCIATES
BLACKSBURG CONSULTING ENGINEERS
VIRGINIA**

RECORDED PERMITS BASED ON INFORMATION
PROVIDED BY S.C. ROBERT & CO. 16 JULY 1992

SHEET
4 OF 9