
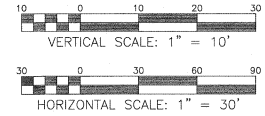


# SANITARY SEWER SCHEDULE:


- (A) PUBLIC S.S. MANHOLE W/ STD LID  
TOP= 1097.50  
INV. IN= 1093.60 (LATERAL)  
INV. IN= 1093.60 (LATERAL)  
INV. OUT= 1093.50
- (A) (B) 142 LF OF 8" SDR-35 PVC AT 0.98%  
PUBLIC S.S. MANHOLE W/ STD LID  
TOP=1097.26  
INV. IN= 1092.10  
INV. OUT= 1092.00
- (B) (E) 146 LF OF 8" SDR-35 PVC AT 1.03%  
EX. PUBLIC S.S. MANHOLE W/ STD LID  
EX. TOP= 1097.73  
NEW INV. IN= 1090.50  
L.S. INV. IN= 1096.00  
EX. INV. OUT= 1089.55

NOTES:  
1. S.C. TO CONFORM & COORDINATE ALL BUILDING  
TIE-IN LOCATIONS WITH M.E.P. AND ARCHITECTURAL  
DRAWINGS PRIOR TO CONSTRUCTION OF LATERALS.  
2. S.C. TO CONFORM ALL TIE-IN LOCATIONS TO  
EXISTING LINES PRIOR TO CONSTRUCTION AND NOTIFY  
THE ENGINEER OF ANY DISCREPANCIES.

## PROPOSED PUBLIC SANITARY PROFILE

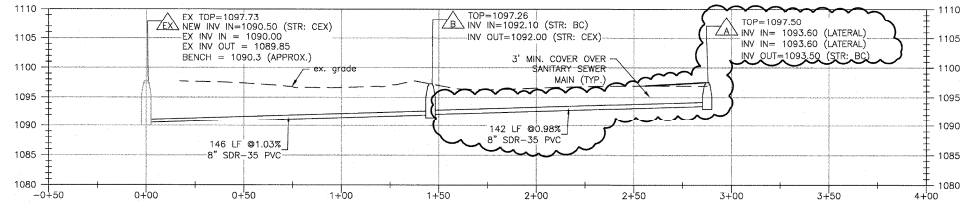

## PROPOSED PUBLIC WATERLINE PROFILE

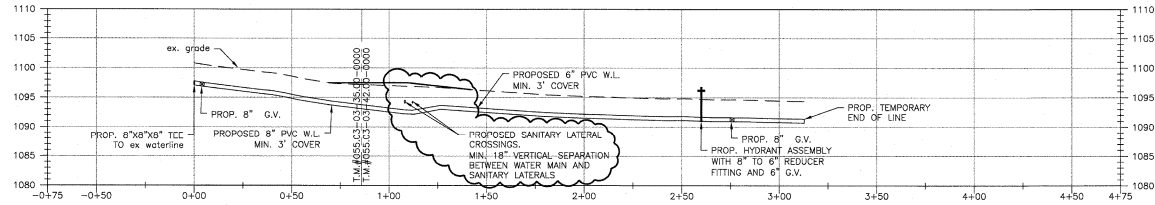

THIS PLAN DOES NOT SHOW 2" WATER METER  
EVERYTHING INSTALLED BY PLANDC  
Main Excavation  
Red Man



**BALZER & ASSOCIATES**  
PLANNERS / ARCHITECTS  
ENGINEERS / SURVEYORS  
Roanoke / Richmond  
Shenandoah Valley  
New River Valley / Lynchburg  
www.balzer.cc  
1208 Corporate Circle  
Roanoke, VA 24018  
540.772.9590



## CROSSMILL LANE WATER & SEWER EXTENSION

### UTILITY PROFILES

DRAWN BY: AAB  
DESIGNED BY: CPB  
CHECKED BY: CPB  
DATE: 6/28/2022  
SCALE: AS SHOWN  
REVISIONS:  
10/9/2022  
12/9/2022 PRF1

**C4**  
PROJECT NO. 04210083.00