
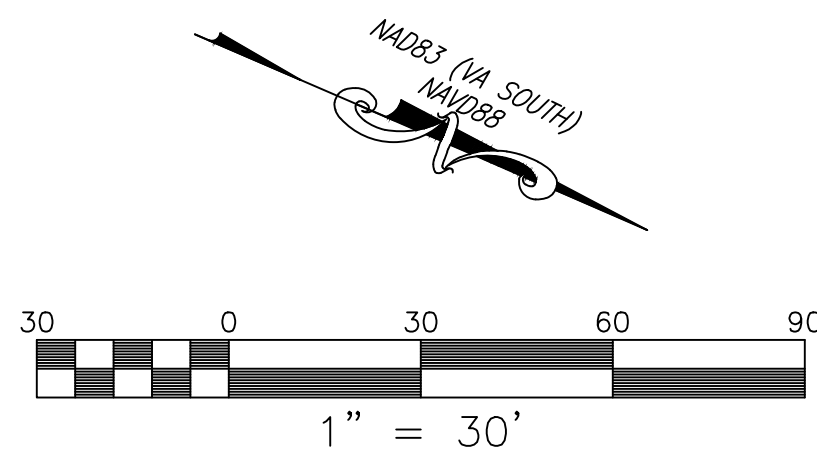
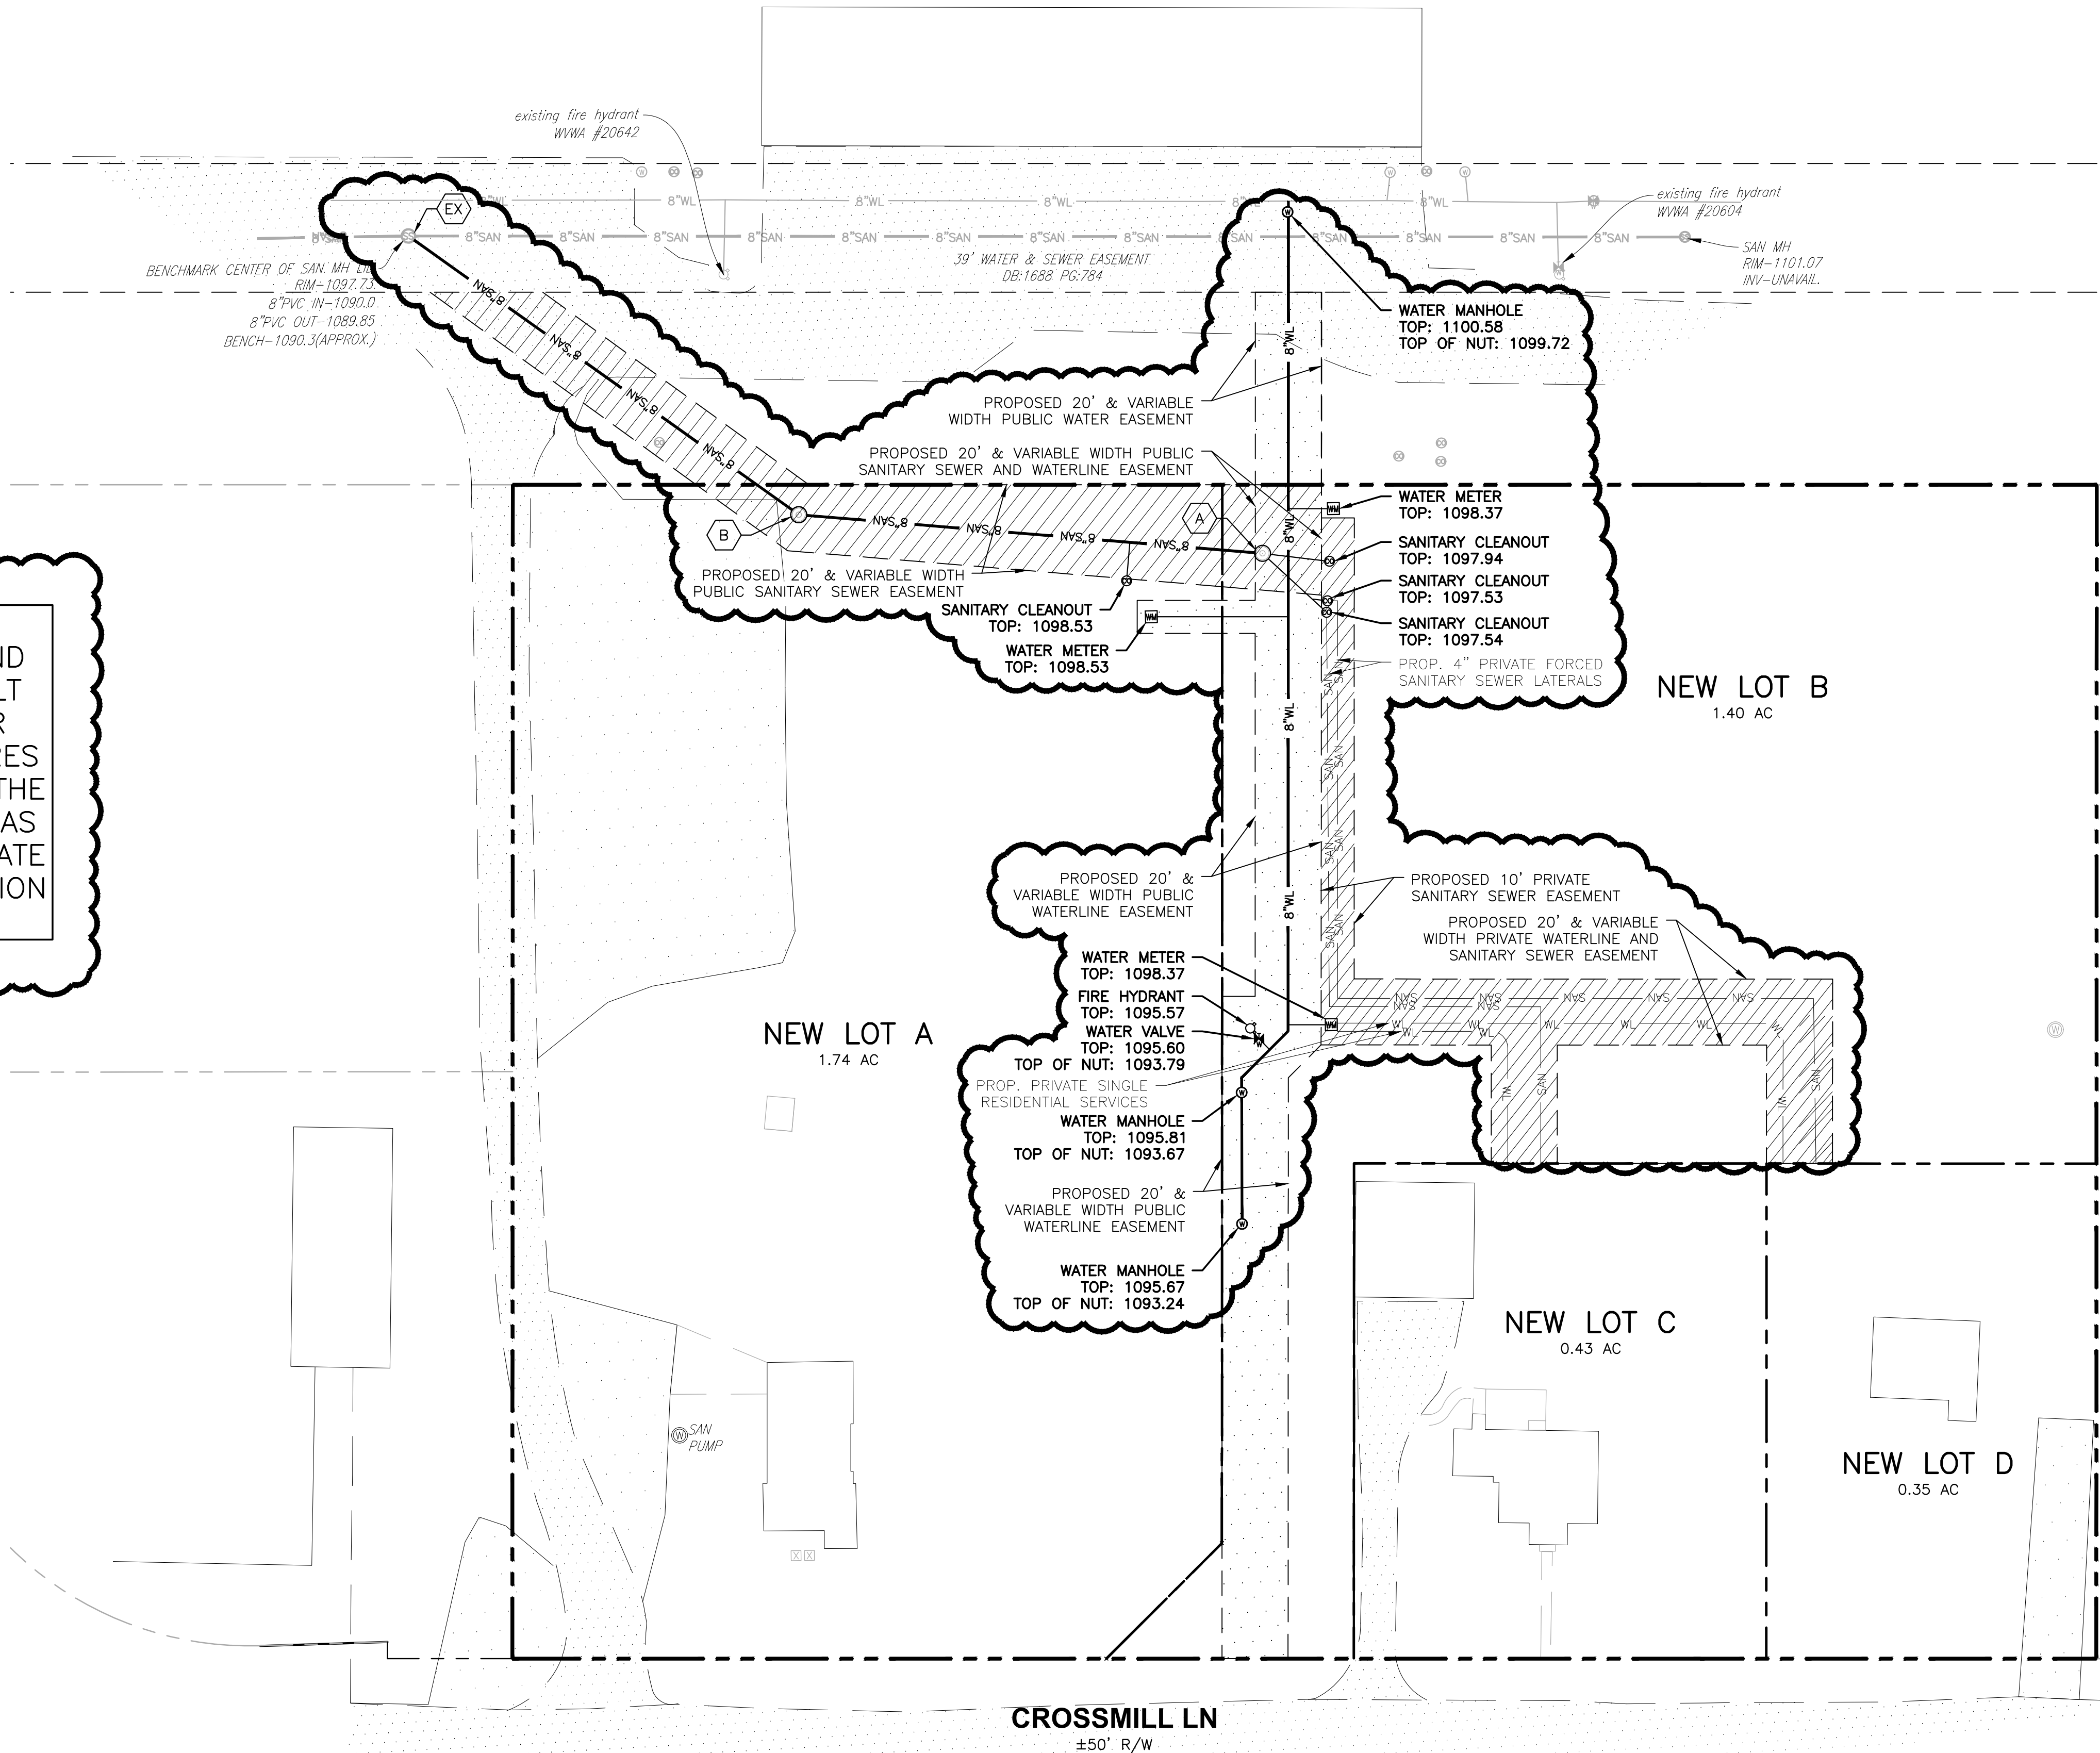
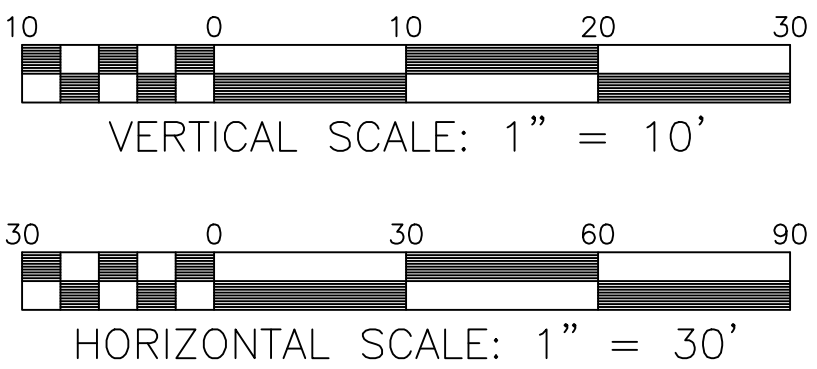


SANITARY SEWER SCHEDULE:

- (A) PUBLIC S.S. MANHOLE W/ ST'D LID
TOP= ~~1097.56~~ 1098.53
INV. IN= ~~1093.66~~ (LATERAL) 1094.13
INV. IN= ~~1093.66~~ (LATERAL) 1094.03
INV. OUT= ~~1093.66~~ 1093.93
- (A) (B) 141
~~142~~ LF OF 8" SDR-35 PVC AT ~~0.98%~~ 1.14%
- (B) PUBLIC S.S. MANHOLE W/ ST'D LID
TOP= ~~1097.26~~ 1097.92
INV. IN= ~~1092.10~~ 1092.32
INV. OUT= ~~1092.00~~ 1092.12
- (B) (EX) 145
~~146~~ LF OF 8" SDR-35 PVC AT ~~0.96%~~ 0.96%
- (EX) EX. PUBLIC S.S. MANHOLE W/ ST'D LID
EX. TOP= 1097.73
NEW INV. IN= ~~1090.50~~ 1090.73
EX. INV. IN= 1090.00
EX. INV. OUT= 1089.85

NOTES:
1. G.C. TO CONFIRM & COORDINATE ALL BUILDING TIE-IN LOCATIONS WITH M.E.P. AND ARCHITECTURAL DRAWINGS PRIOR TO CONSTRUCTION OF LATERALS.
2. G.C. TO CONFIRM ALL TIE-IN LOCATIONS TO EXISTING LINES PRIOR TO CONSTRUCTION AND NOTIFY THE ENGINEER OF ANY DISCREPANCIES.

AS-BUILT DRAWING NOTE:
AS-BUILT DRAWING FOR SANITARY SEWER AND WATERLINE IMPROVEMENTS ARE FOR AS-BUILT PURPOSES ONLY. NO IMPROVEMENTS OTHER THAN WATER AND SANITARY SEWER STRUCTURES WERE AS-BUILT OR INDICATED AS SUCH ON THE SUBJECT PLAN SET. UNDERGROUND PIPING WAS NOT LOCATED. LOCATION SHOWN IS APPROXIMATE BASED ON SURFACE FEATURES AND INFORMATION PROVIDED BY CONTRACTOR.

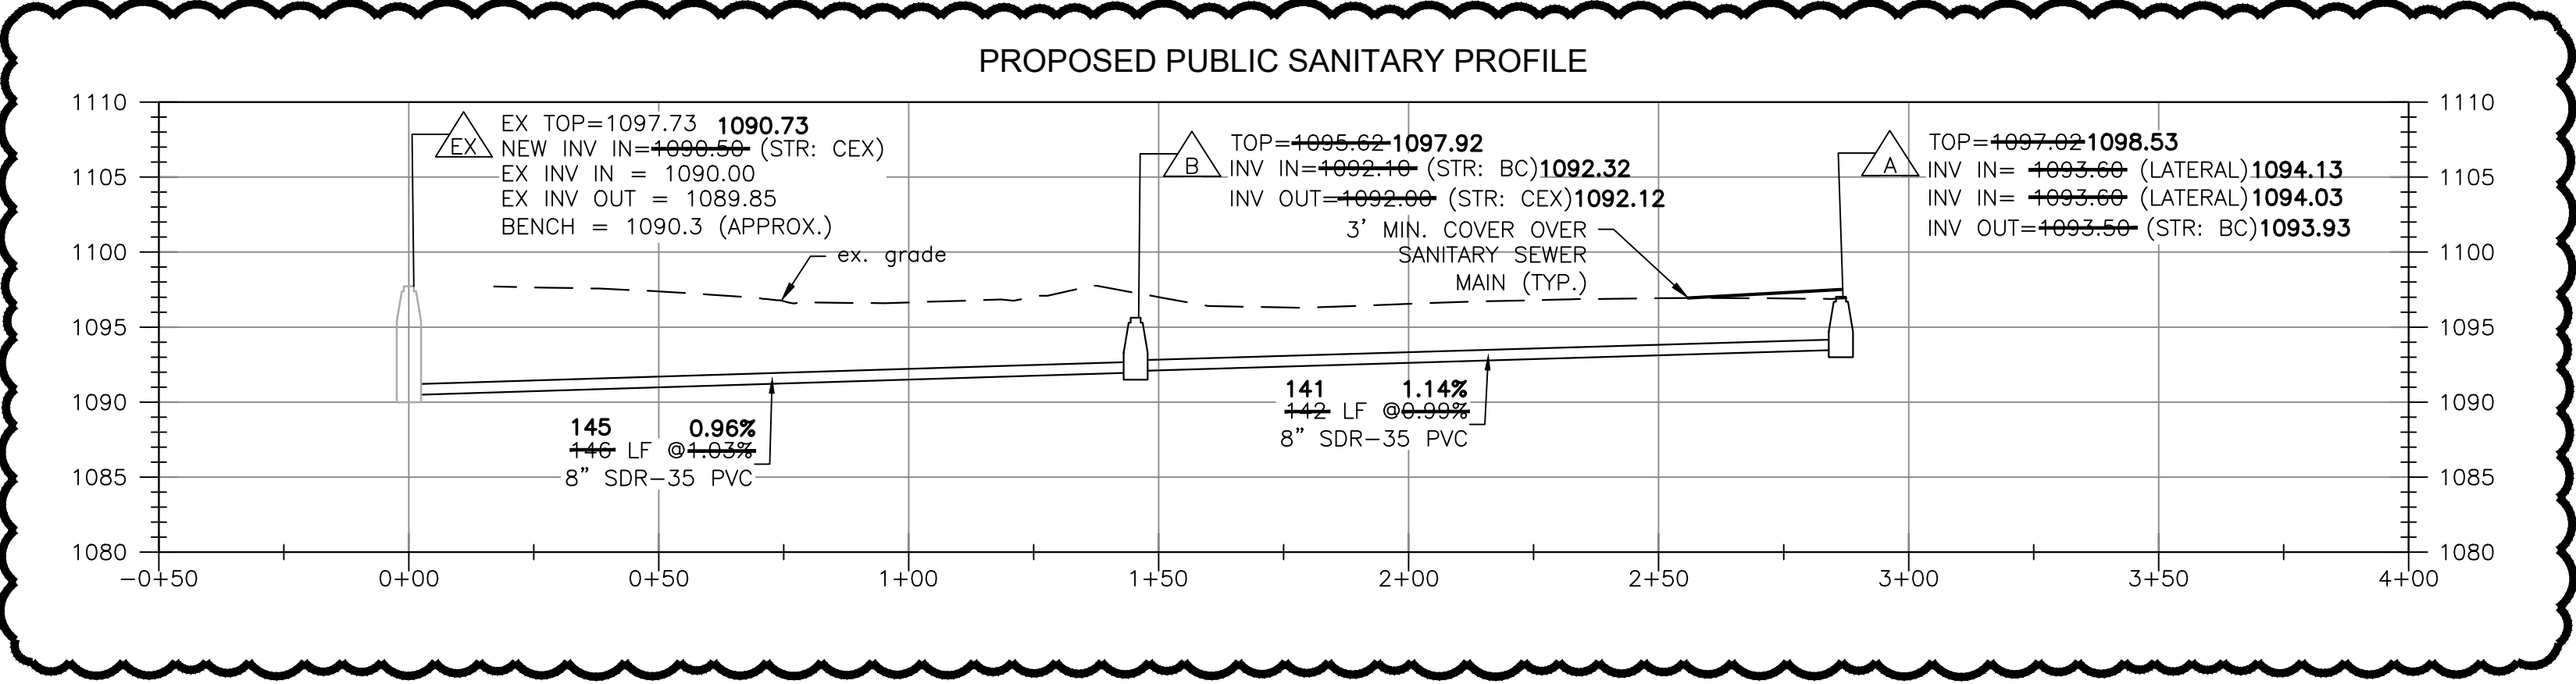


BALZER & ASSOCIATES
PLANNERS / ARCHITECTS
ENGINEERS / SURVEYORS

Roanoke / Richmond
Shenandoah Valley
New River Valley / Lynchburg

www.balzer.cc

1208 Corporate Circle
Roanoke, VA 24018
540.772.9580

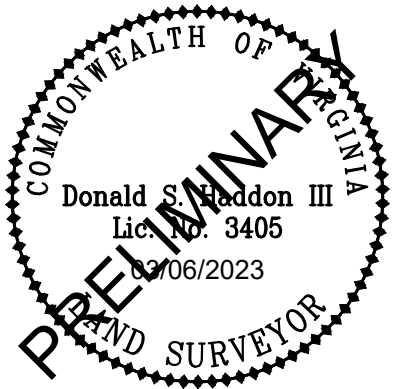

CROSSMILL LANE WATER & SEWER EXTENSION

WATER & SANITARY SEWER AS-BUILT

438 CROSSMILL LANE
SALEM, VA 24153

DRAWN BY EJP
DESIGNED BY EJP
CHECKED BY DSH
DATE 01/04/2023
SCALE 1" = 30'
REVISIONS
03/06/2023 EASEMENT UPDATE

EX-A
PROJECT NO. 04210063.00