


EROSION CONTROL LEGEND

3.08 CULVERT INLET PROTECTION	(SF)	X X X X X
3.08 CULVERT INLET PROTECTION	(CIP)	
3.19 RIPRAP	(RR)	
3.32 PERMANENT SEEDING	(PS)	

AS-BUILT CONDITIONS
JUNE 6, 2005

***CONSTRUCTION ENTRANCE**
CONTRACTOR IS RESPONSIBLE FOR MAINTENANCE OF CONSTRUCTION ENTRANCE(S) IN ACCORDANCE WITH VIRGINIA EROSION AND SEDIMENT CONTROL HANDBOOK, LATEST EDITION. AT COMPLETION OF CONSTRUCTION CONTRACTOR SHALL RESTORE ENTRANCES TO PRE-CONSTRUCTION CONDITION IN ACCORDANCE WITH 'GRAVEL DRIVE NOTE' SHEET 3

E&S-BORE PIT
CONTRACTOR IS RESPONSIBLE FOR PROVIDING EROSION CONTROL MEASURES AT THE BORE PIT LOCATION IN ACCORDANCE WITH THE VIRGINIA EROSION AND SEDIMENT CONTROL HANDBOOK, LATEST EDITION. A METHOD OF SILT REMOVAL DURING DEWATERING OPERATIONS, APPROVED BY THE ROANOKE COUNTY DEPARTMENT OF COMMUNITY DEVELOPMENT, SHALL ALSO BE PROVIDED.

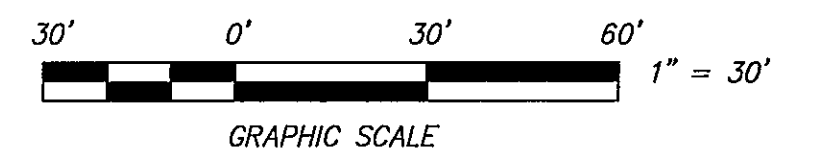

	<p>CRYSTAL CREEK SS EXTENSION EROSION AND SEDIMENT CONTROL PLAN FOR THE WESTERN VIRGINIA WATER AUTHORITY</p> <p>COUNTY OF ROANOKE, VA.</p>
	<p> CALDWELL WHITE ASSOCIATES ENGINEERS / SURVEYORS / PLANNERS</p> <p>1054 OLD COUNTRY CLUB ROAD P.O. BOX 8340 ROANOKE, VIRGINIA 24017 (540) 348-7004 FAX: (540) 981-0699</p>
	<p>Designed: JWK Drawn: JWK Checked: FBC Date: October 19, 2004 Rev: January 12, 2005 Scale: 1"=30' Tax Parcel: 097.01-02-07.11 W.O. No.: 04-0101</p>