


Weller Ln, SE ↑ Roanoke Memorial Hospital ↑



Crystal Spring
16" line relocation - Pipe - 035576
Field-Lok Gaskests on all Joints
Installed by WWA Field Ops.
T# 4060502
2012 Jefferson St.

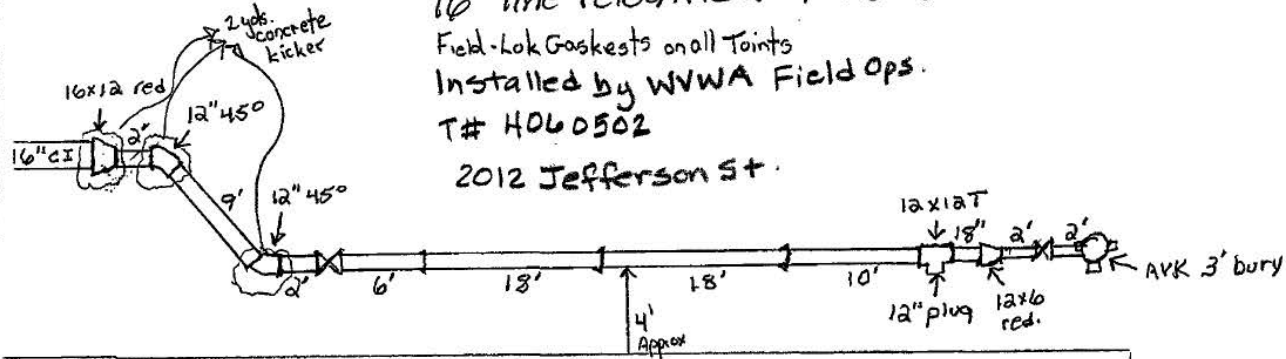

Crystal Spring Building Water Treatment Plant

Tennis Court



Jefferson St, SE ↓

As-Built 03/18/2015