


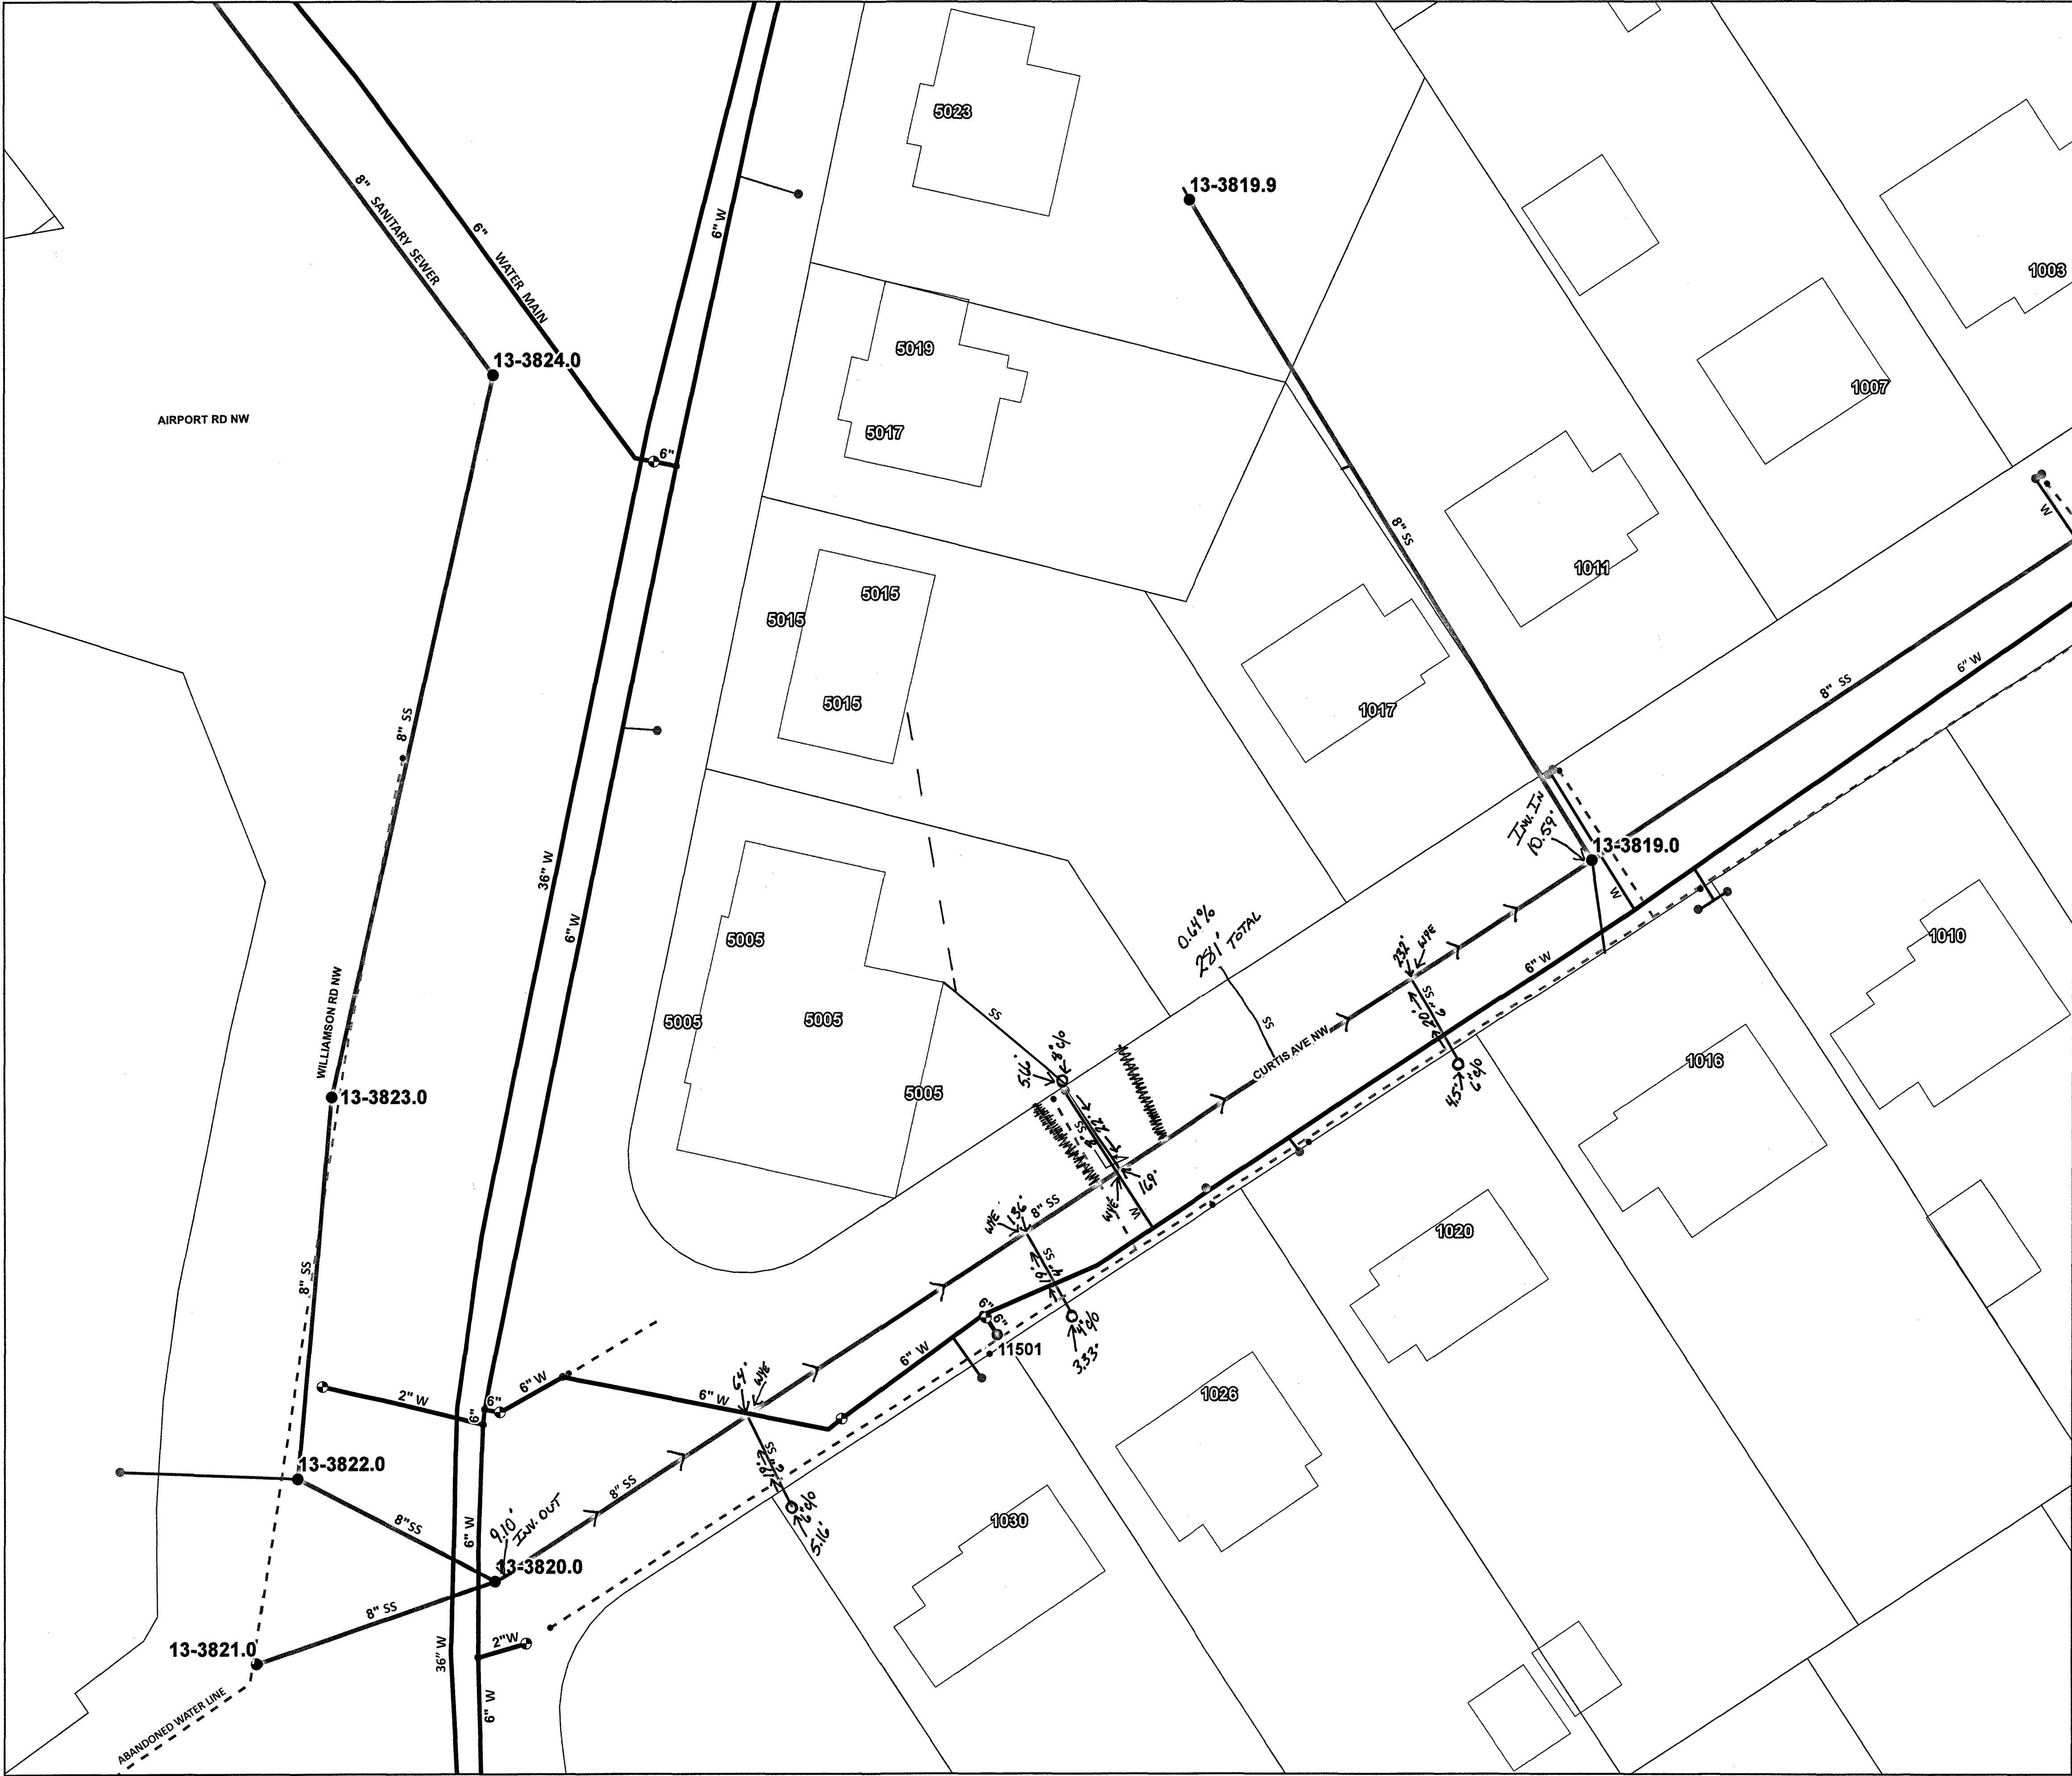

Legend

- WValve
- WHydrant
- WMeter
- WControlValve
- WMain
- WServiceLine
- WBlowOff
- WFitting
- WRawWaterMain
- WPrivatePoint
- WPrivateLine
- WAbandonedPoint
- - - WAbandonedLine
- SManhole
- SCleanout
- SPreTreatment
- SGravityMain
- SForceMain
- SLateralline
- SPrivatePoint
- SPrivateLine
- SAbandonedPoint
- - - SAbandonedLine
- Parcels
- Building Footprints

**1000 Block
Curtis Ave SW**

**Sewer
Gravitymain
Replacement**

CIP2 Taft Beasley (Field Ops)
As-Built 08/01/2020

Created By: WWA Engineering
Created On: June 17, 2020

0 25 50
Feet