


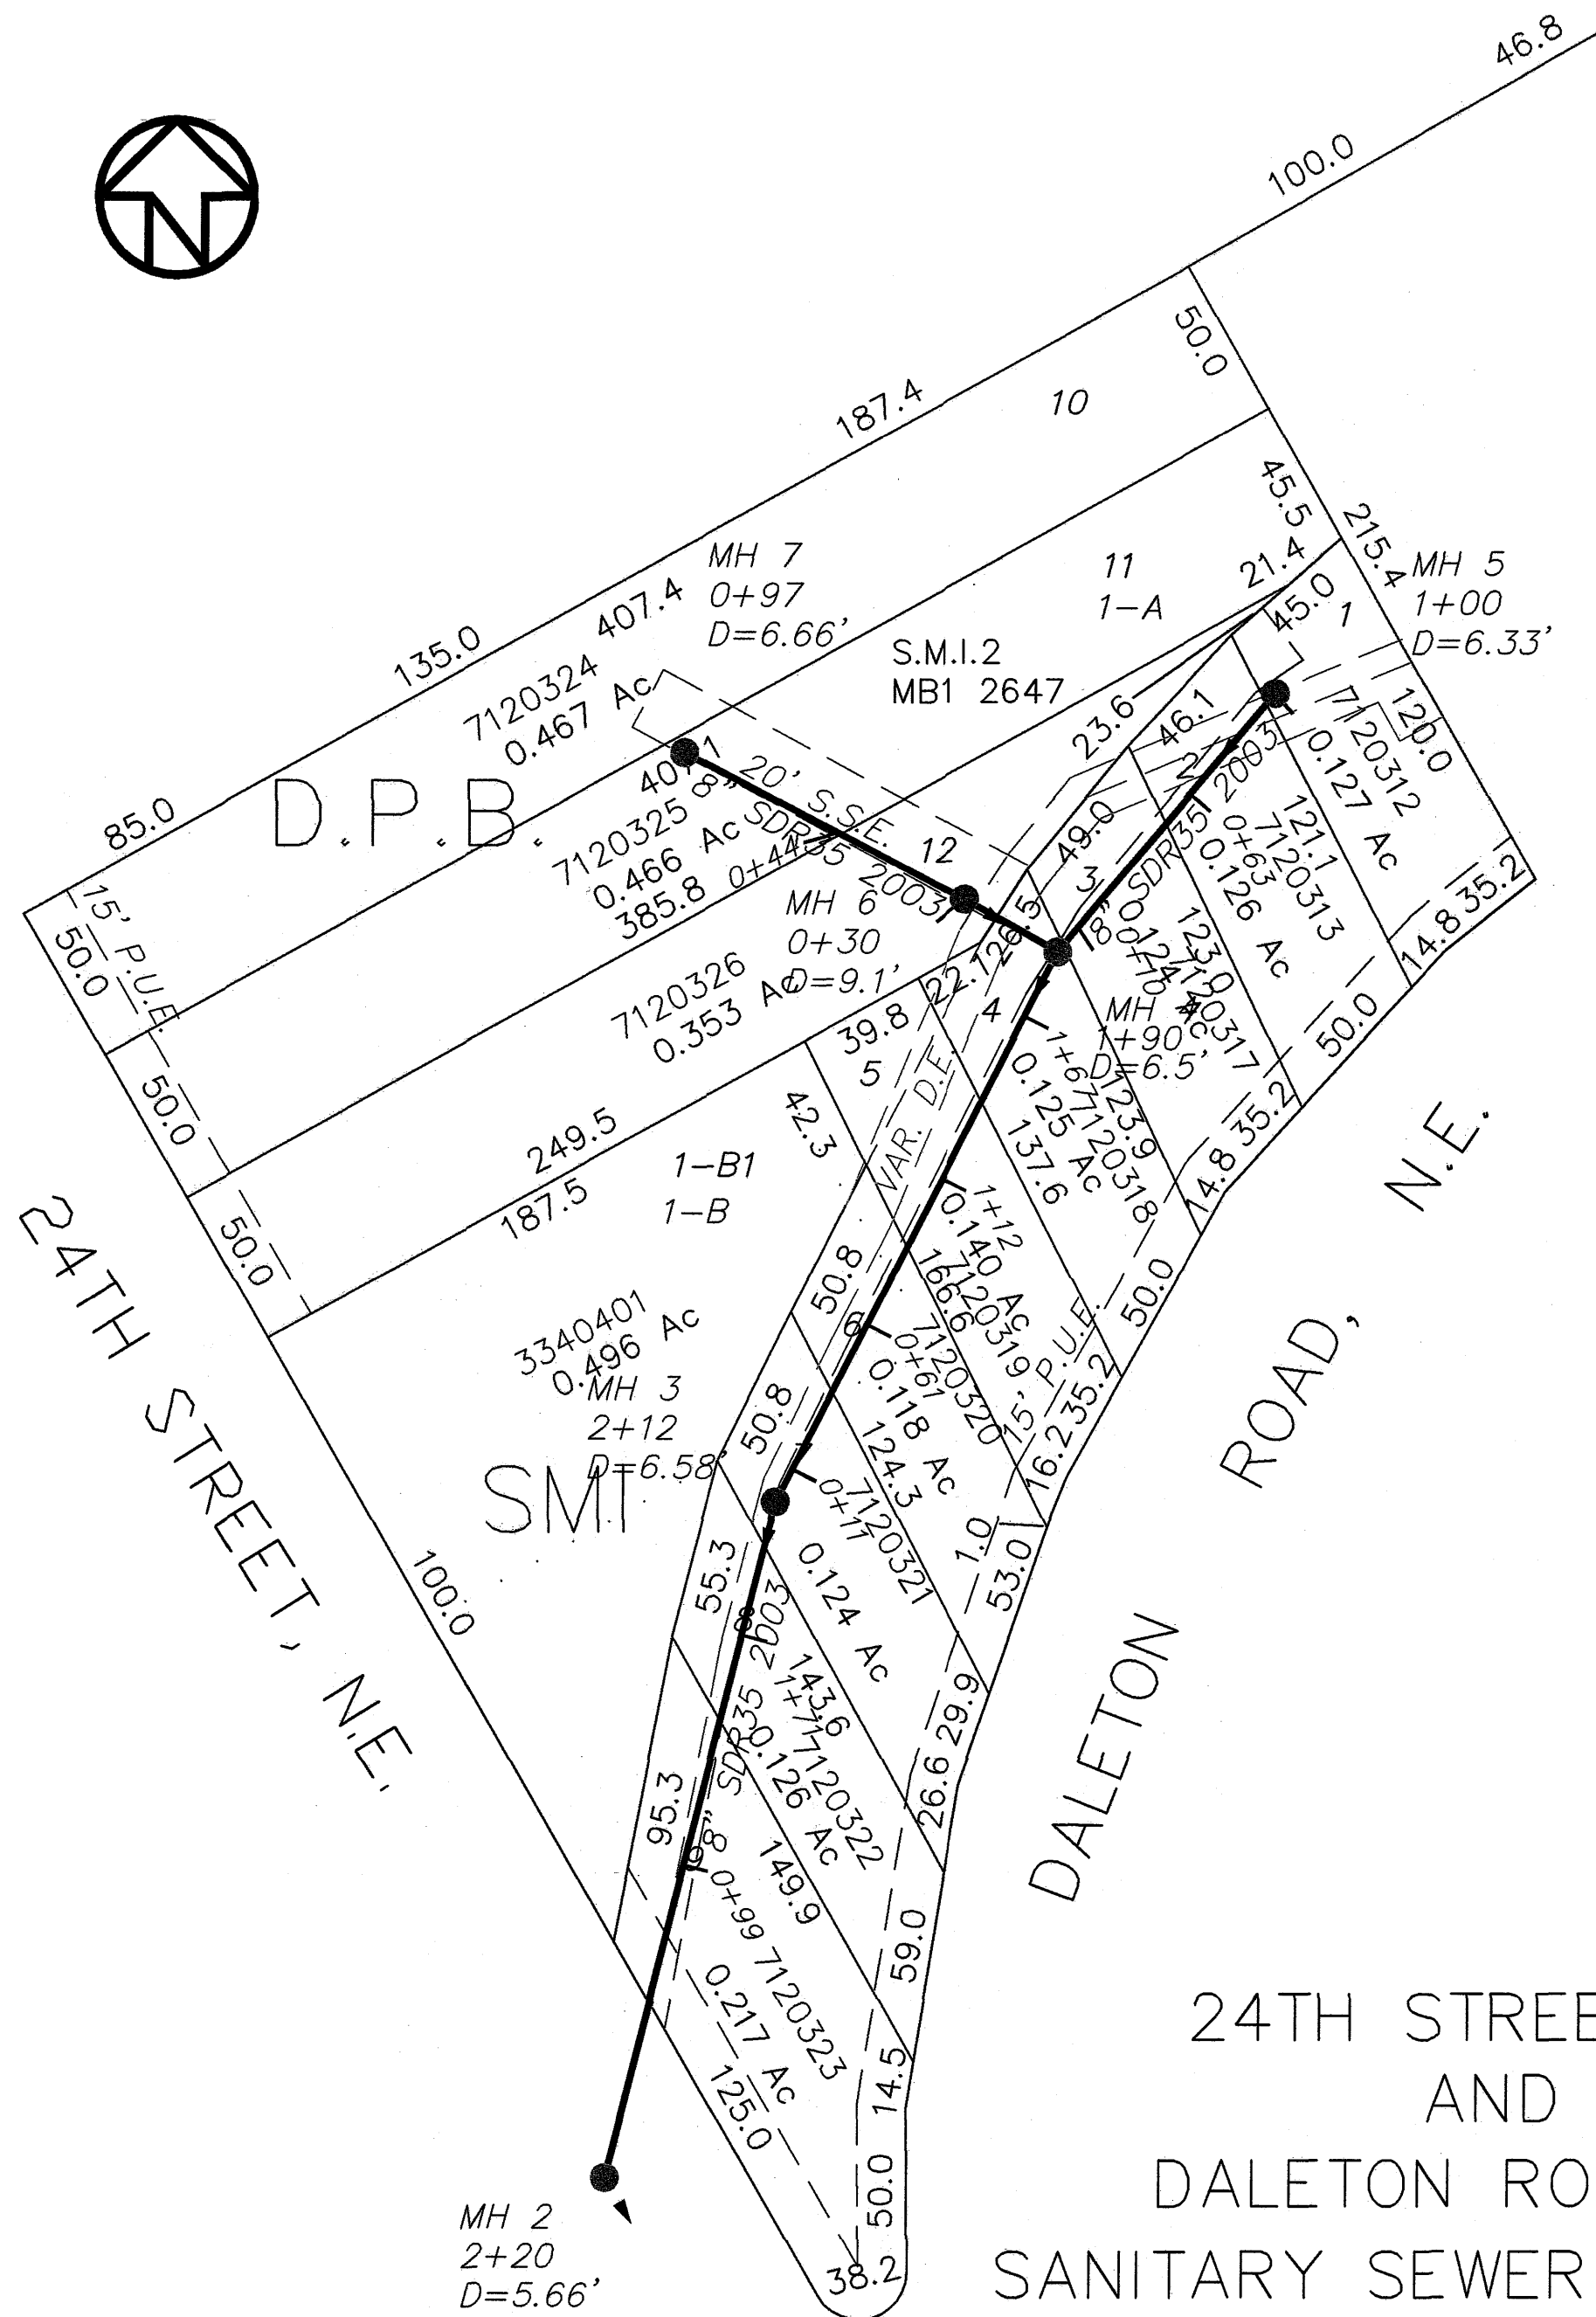

AS-BUILT: 01/21/2004
GPS: 12/18/2003