



This document, together with the concepts and designs presented herein, as an instrument of service, is intended only for the specific purpose and client for which it was prepared. Reuse of and improper reliance on this document without written authorization and adaptation by Engineering Concepts, Inc. shall be without liability to Engineering Concepts, Inc.


PROFILE OF COLONY SANITARY

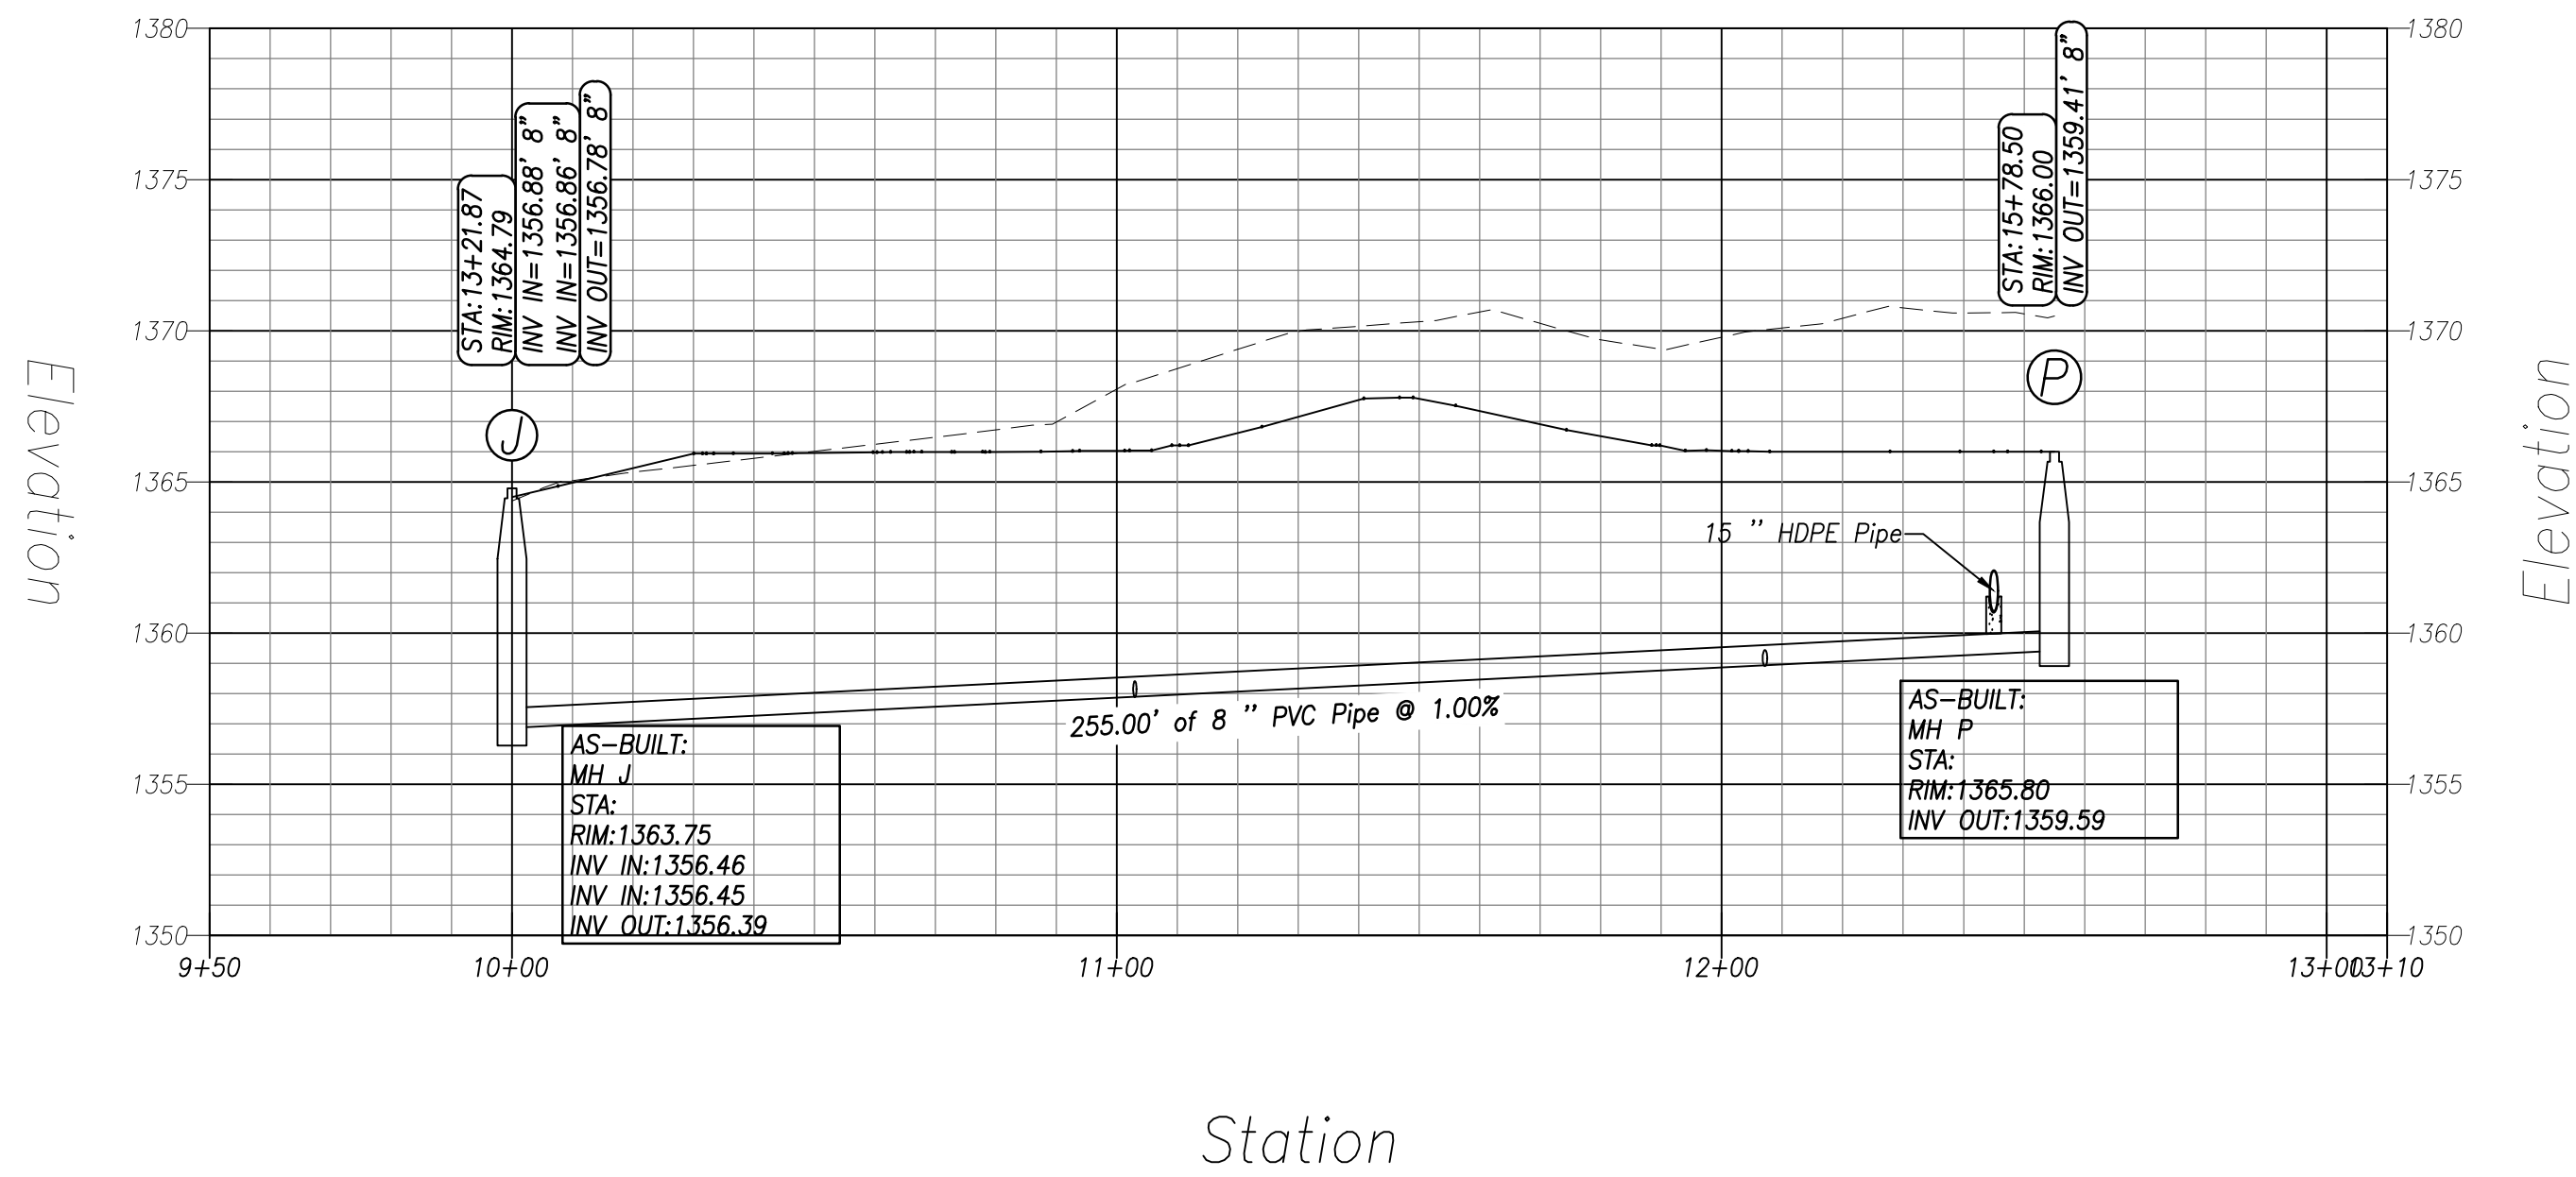

PROFILE OF CLARK SANITARY

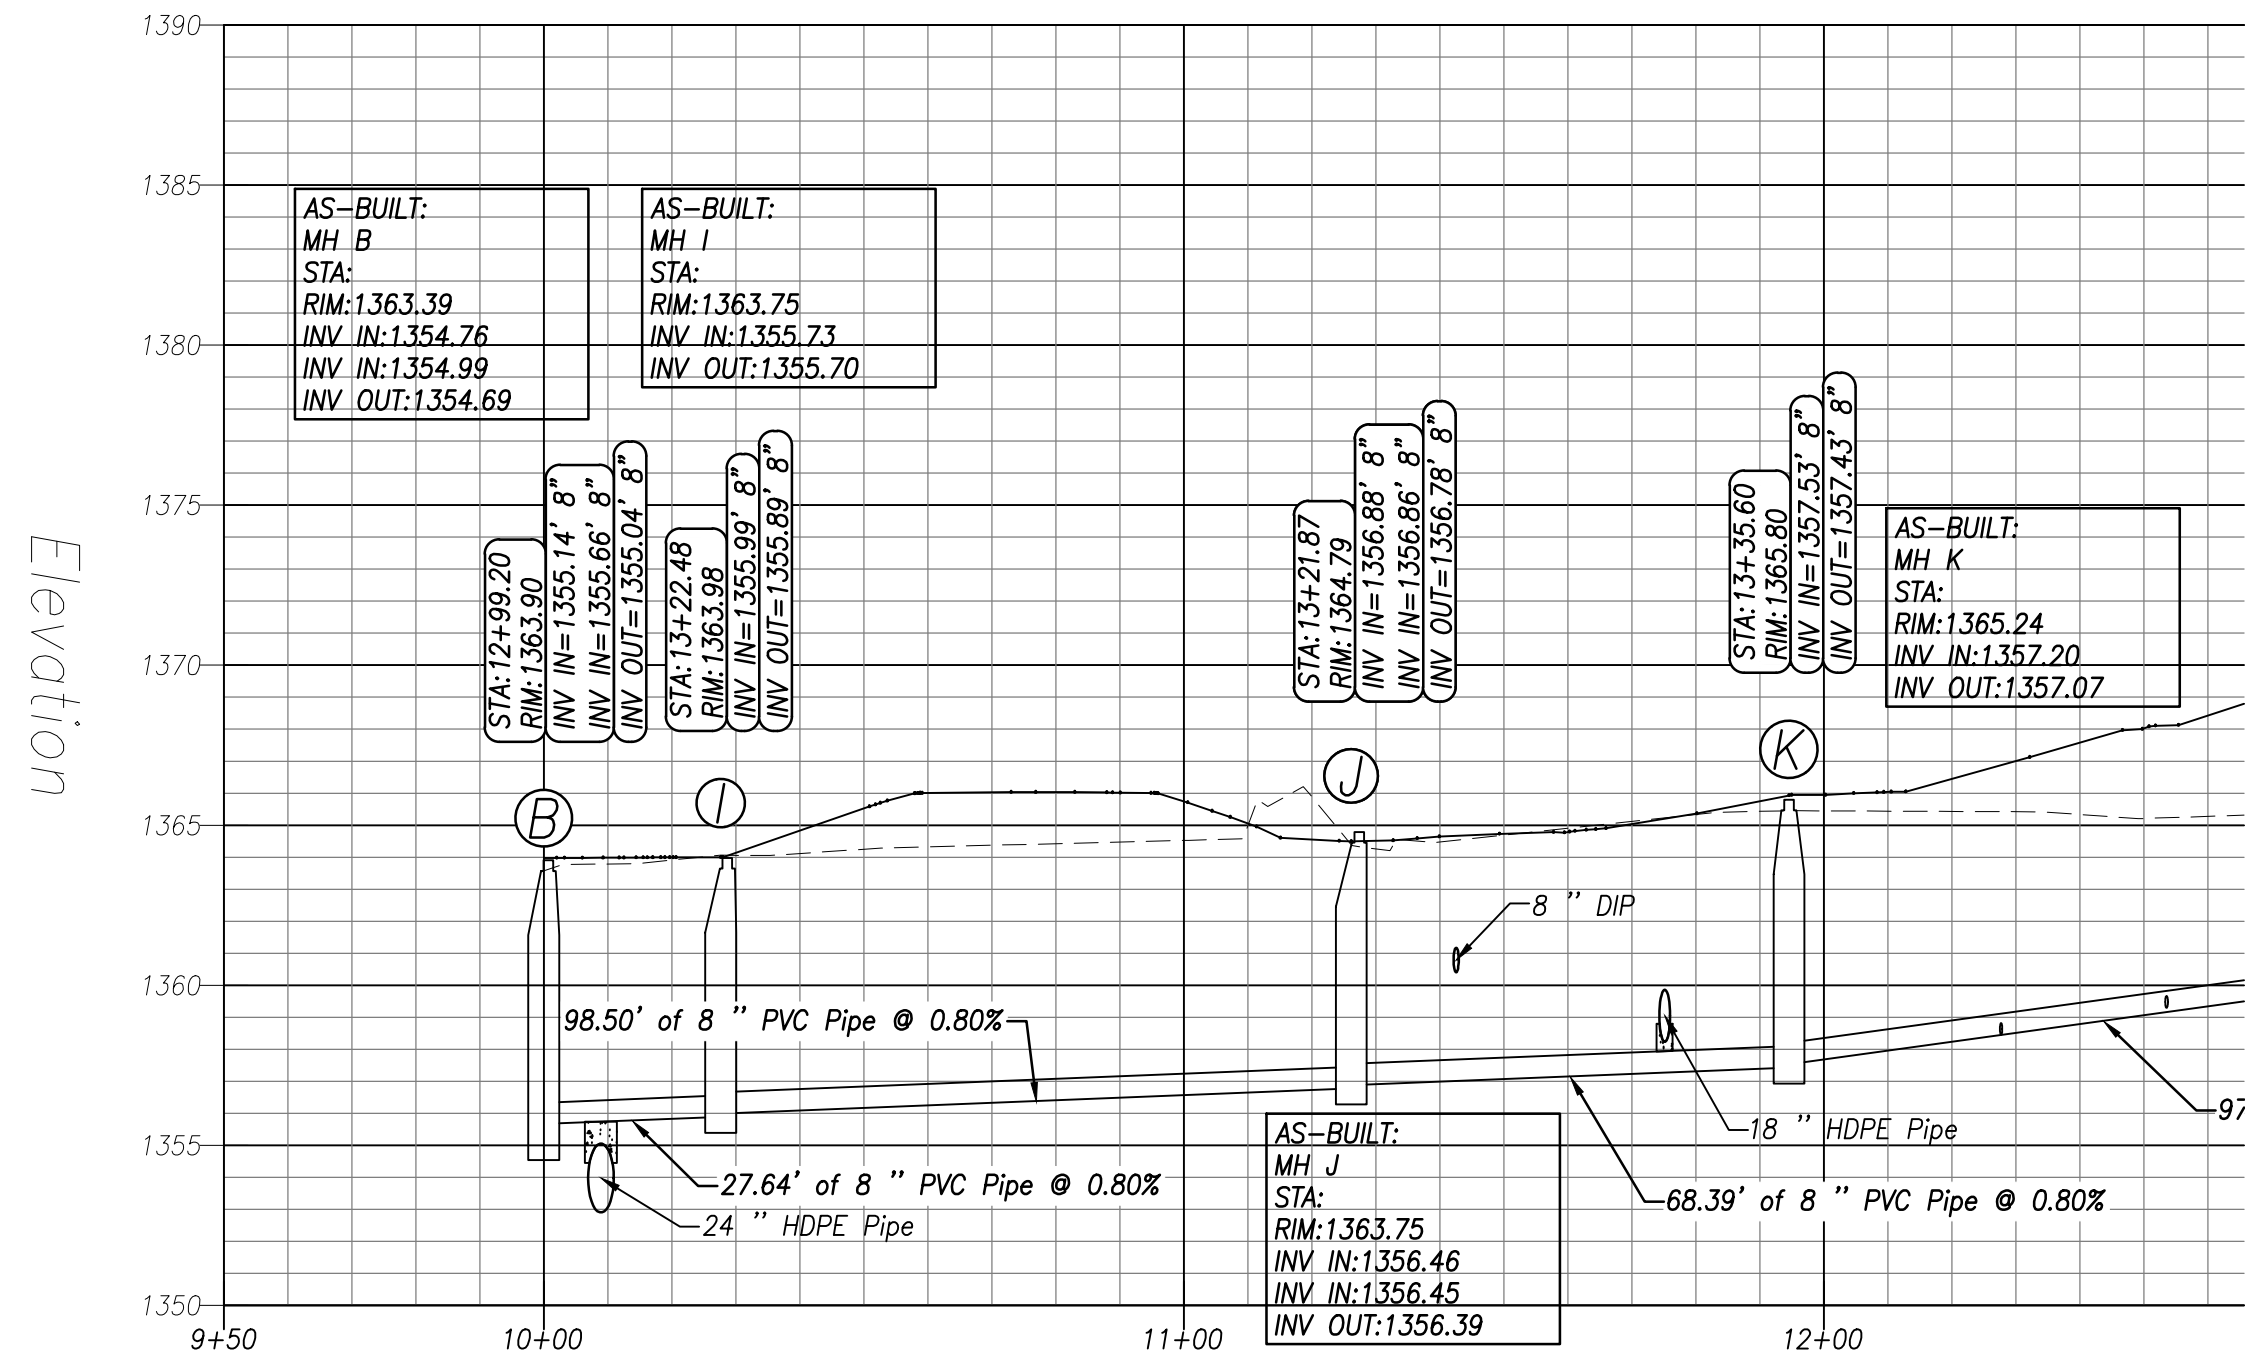

PROFILE OF ALLEY SANITARY

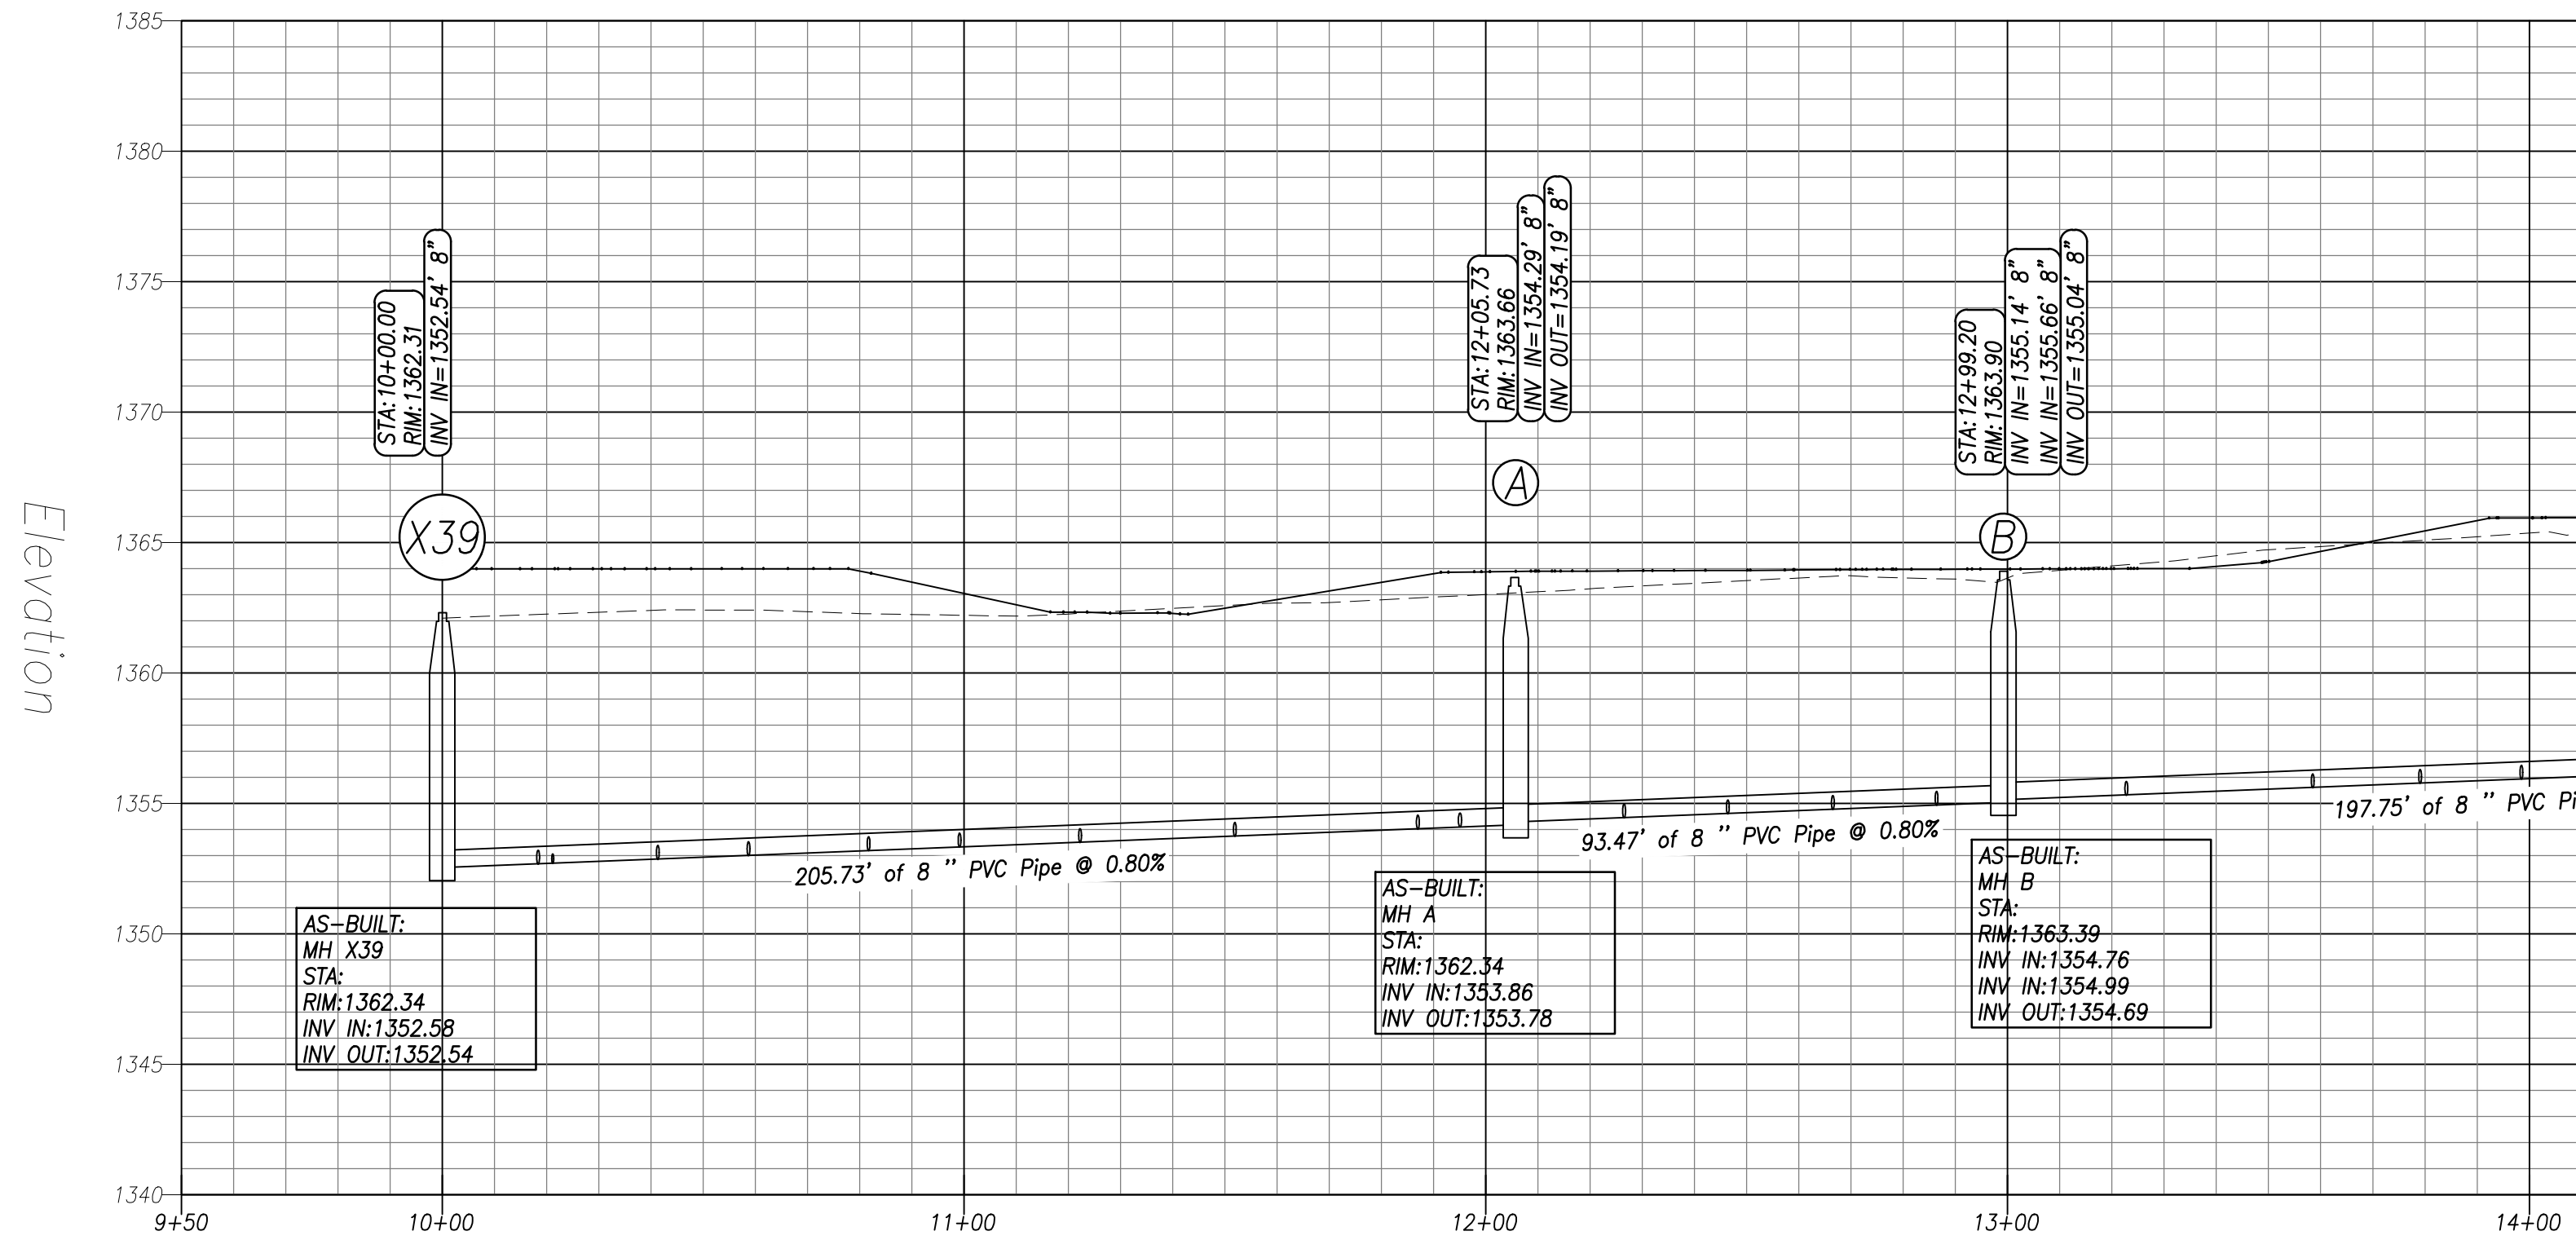

AS-BUILT



ENGINEERING
CONCEPTS, INC.


94 GREENFIELD STREET
DALEVILLE, VIRGINIA 24083
540.473.1253



FRALIN & WALDRON, INC.

DALEVILLE TOWN CENTER
BOTETOURT COUNTY, VA

SANITARY SEWER PROFILES

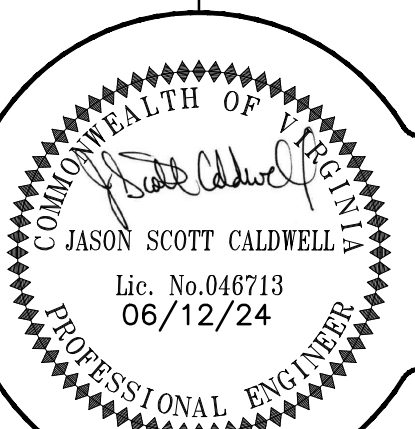

0 30 60
GRAPHIC SCALE

PROJECT: 21061

C-609