


DAVIDSON'S - JEFFERSON ST. SE

BENDS ARE MEAN LUGGED

← 22 —

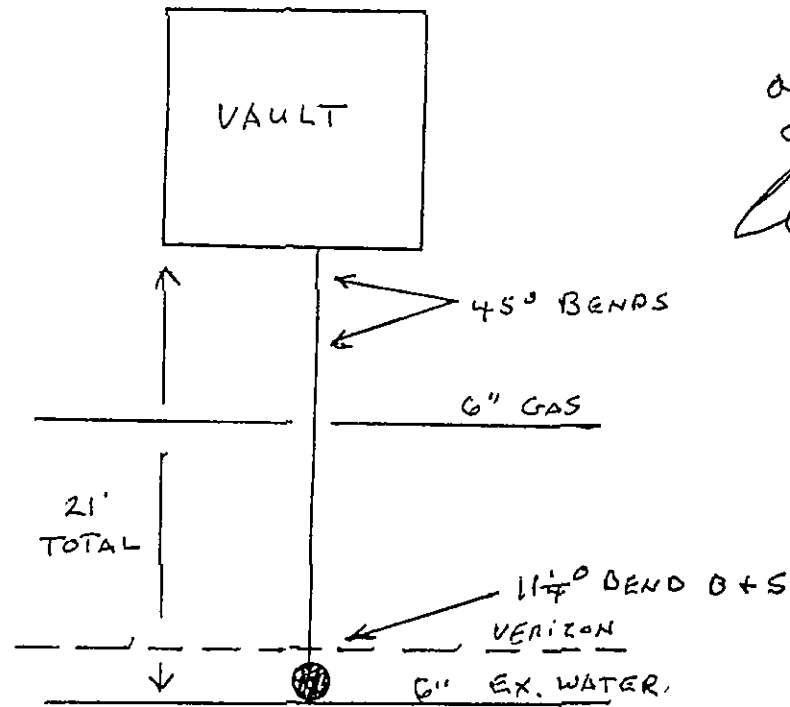

as BUILT
9-21-07

Handwritten signature