
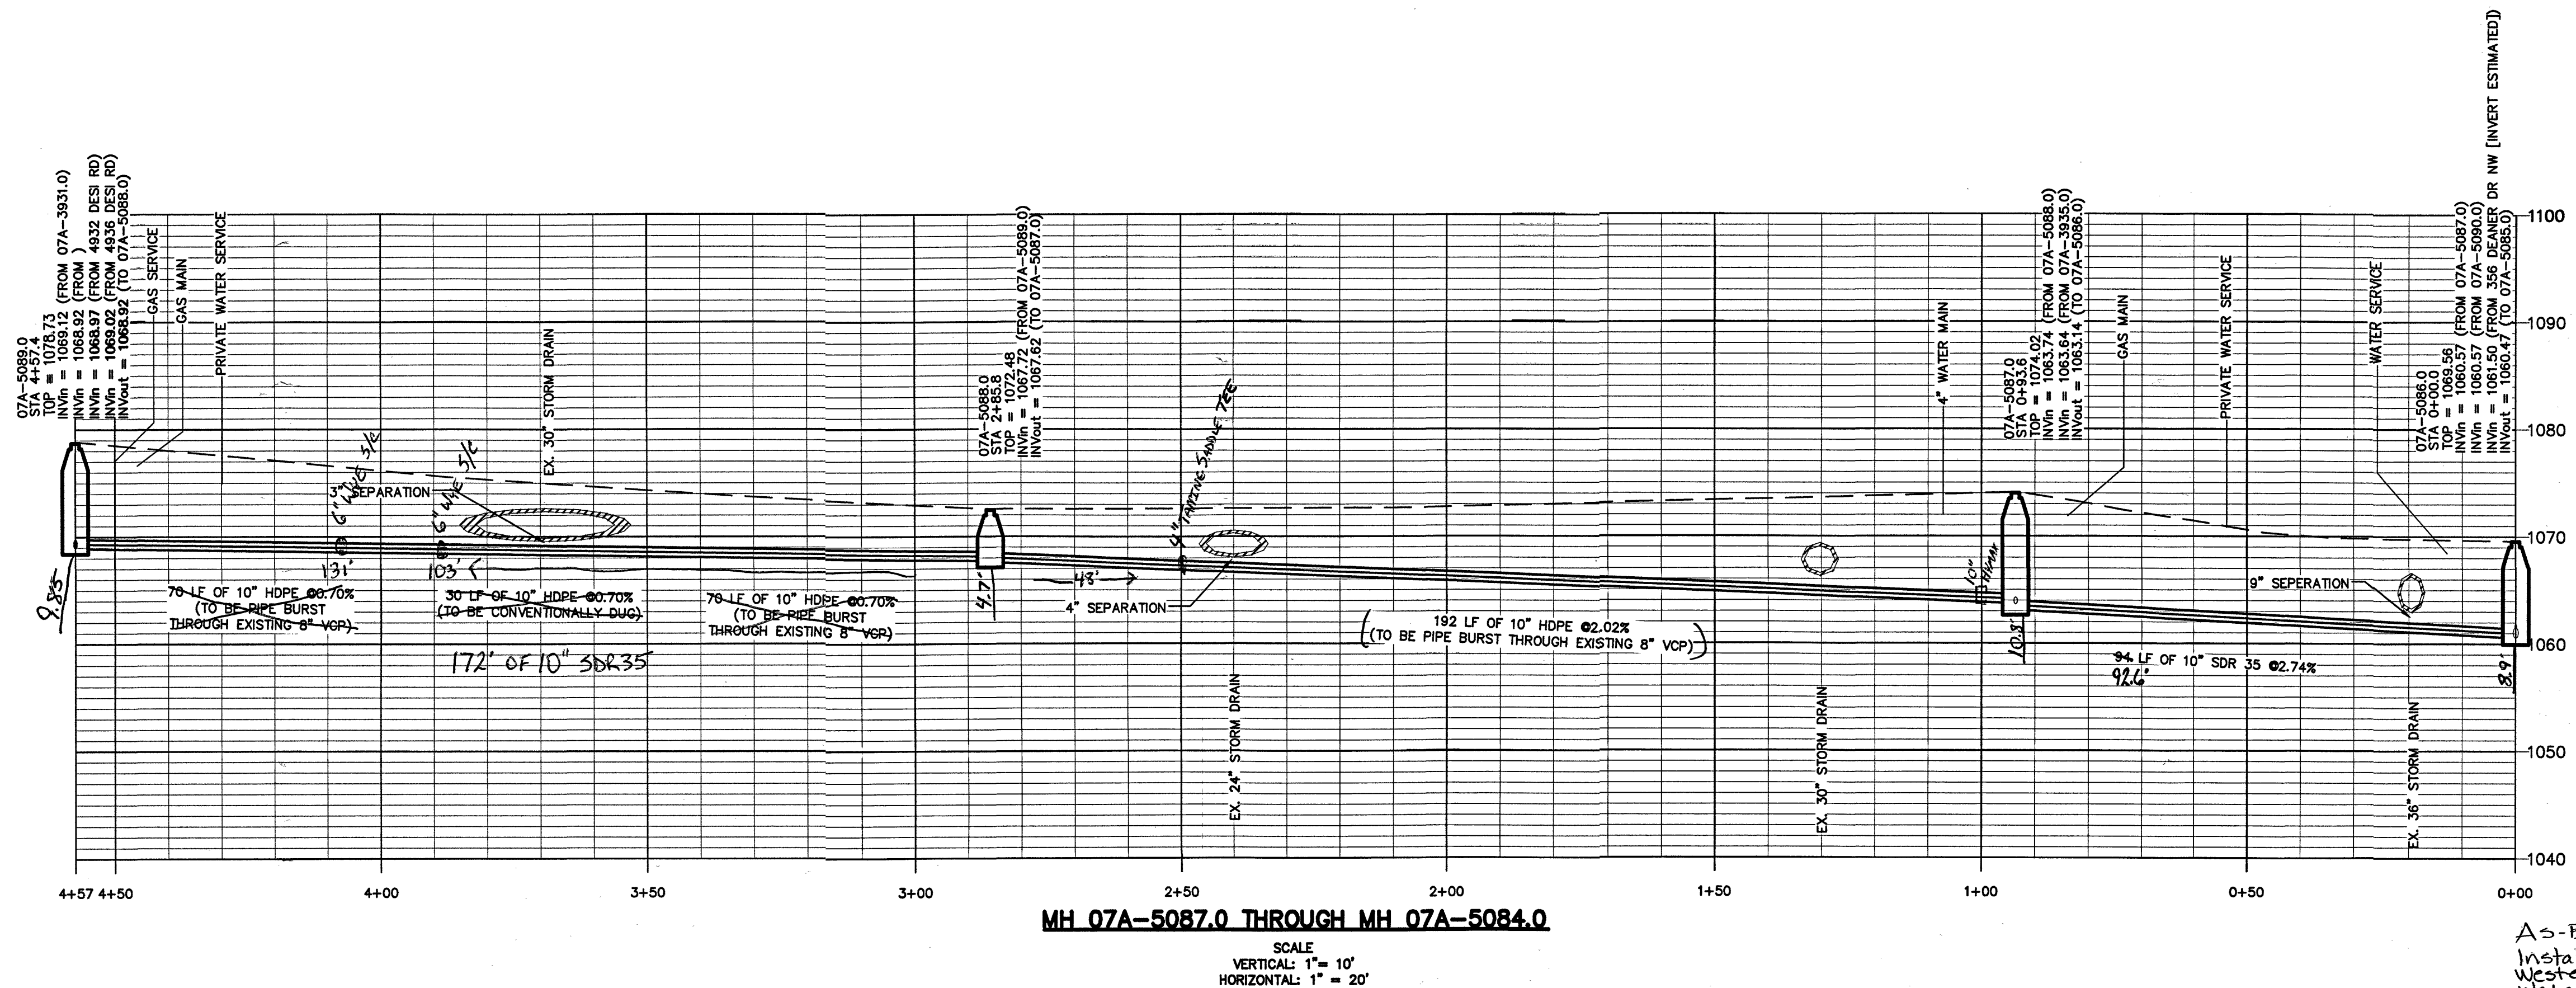


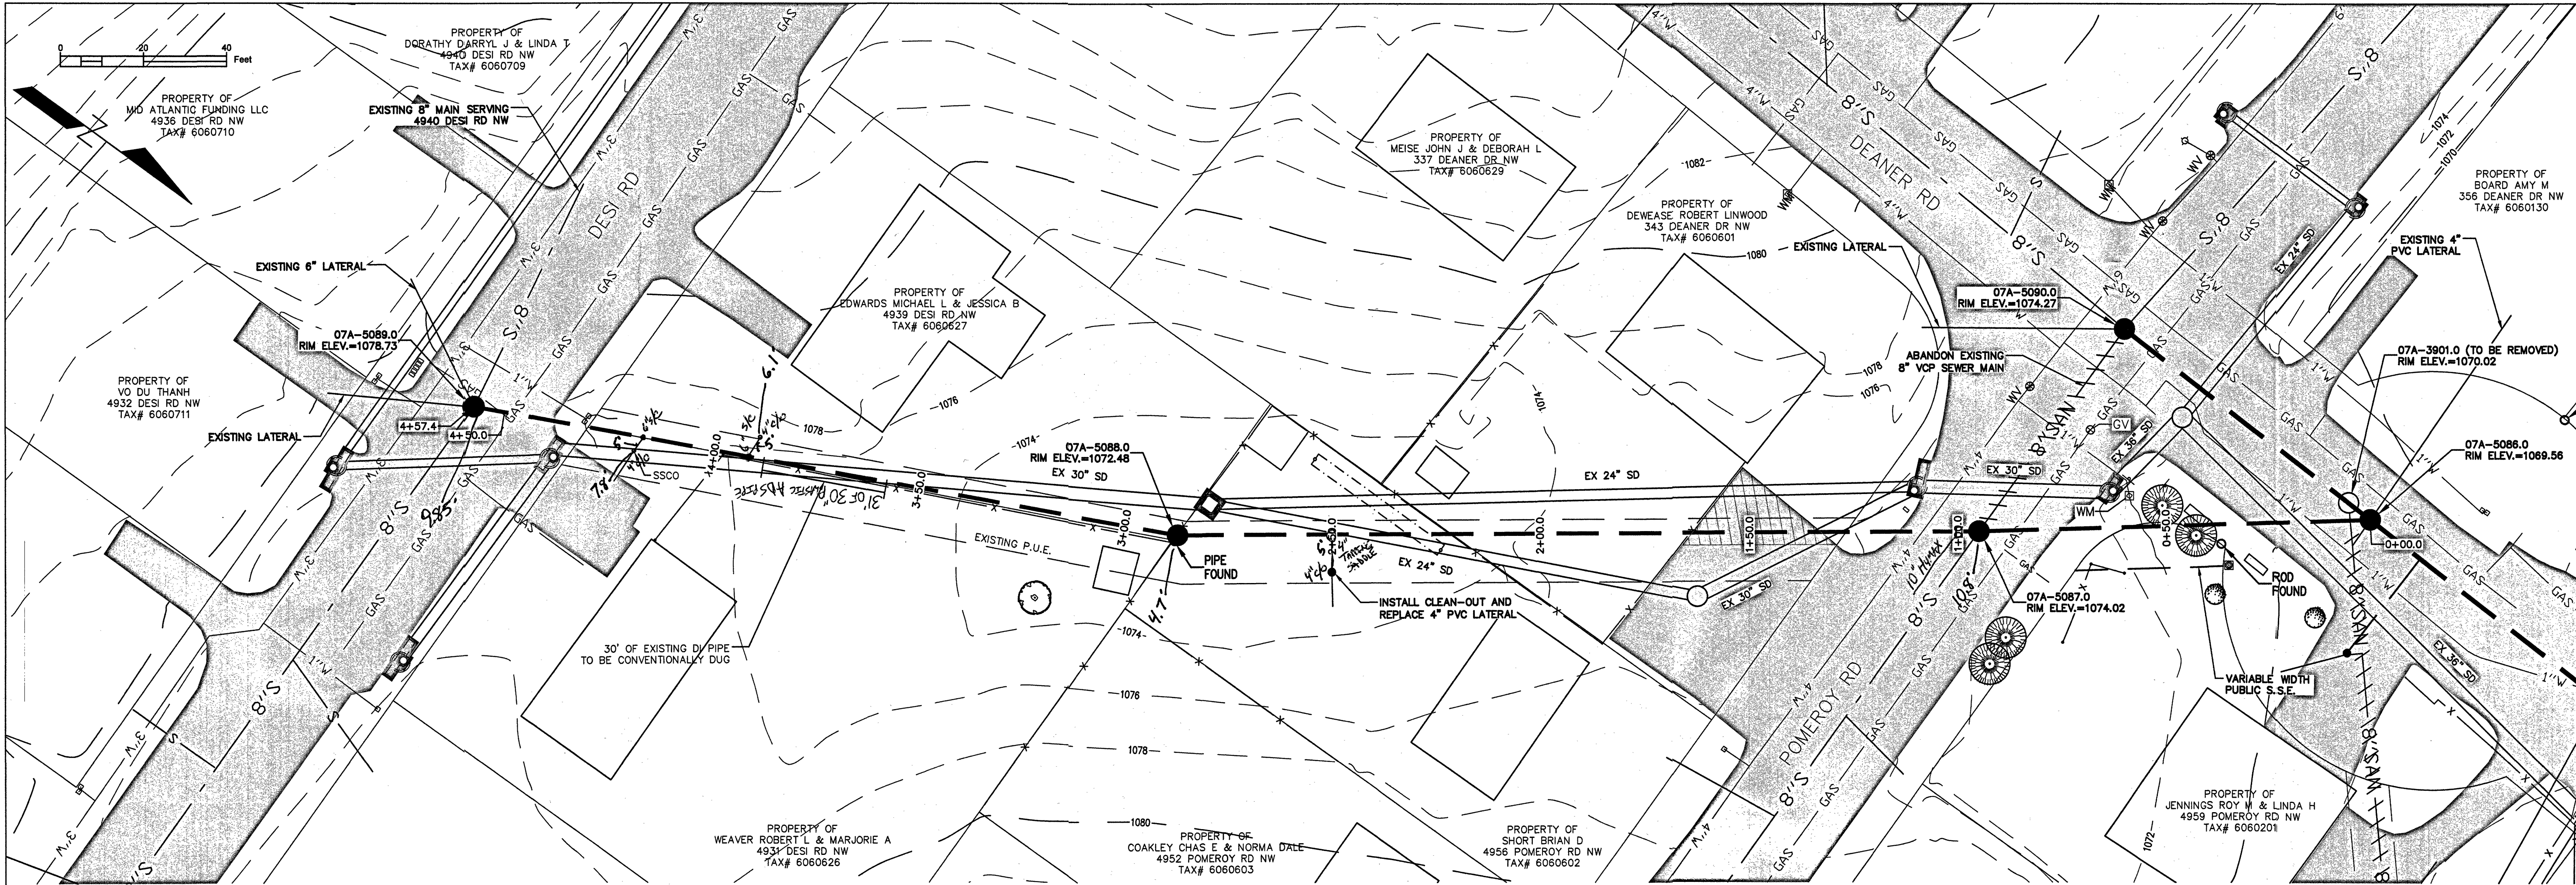

WESTERN VIRGINIA
WATER AUTHORITY

ENGINEERING SERVICES
601 S JEFFERSON ST, SUITE 300
ROANOKE, VA 24011
540-853-5641 or 540-853-5770

DEANER SEWER CIP

PLAN & PROFILE

Rev	Description	Date	By
1	90% SUBMITTAL	6/17/15	DRJ
2	PROPOSED PLAN	10/1/15	DRJ
3	REVISED PROP. PIPE TO 12"	9/20/16	DRJ
4	REVISED PLAN PER FO MEETING	10/04/16	DRJ
5	FINAL REVIEW	04/05/17	DRJ
6	CLEANUP FOR AS-BUILT	8/18/17	DRJ

Designed: DRJ
Checked: AAS
Approved: TEC
Date: 10/07/16
Project: 1

As-Built 08/10/2017
Installed by:
Western Virginia
WaterAuth Field Ops.

Sheet 1 of 2