
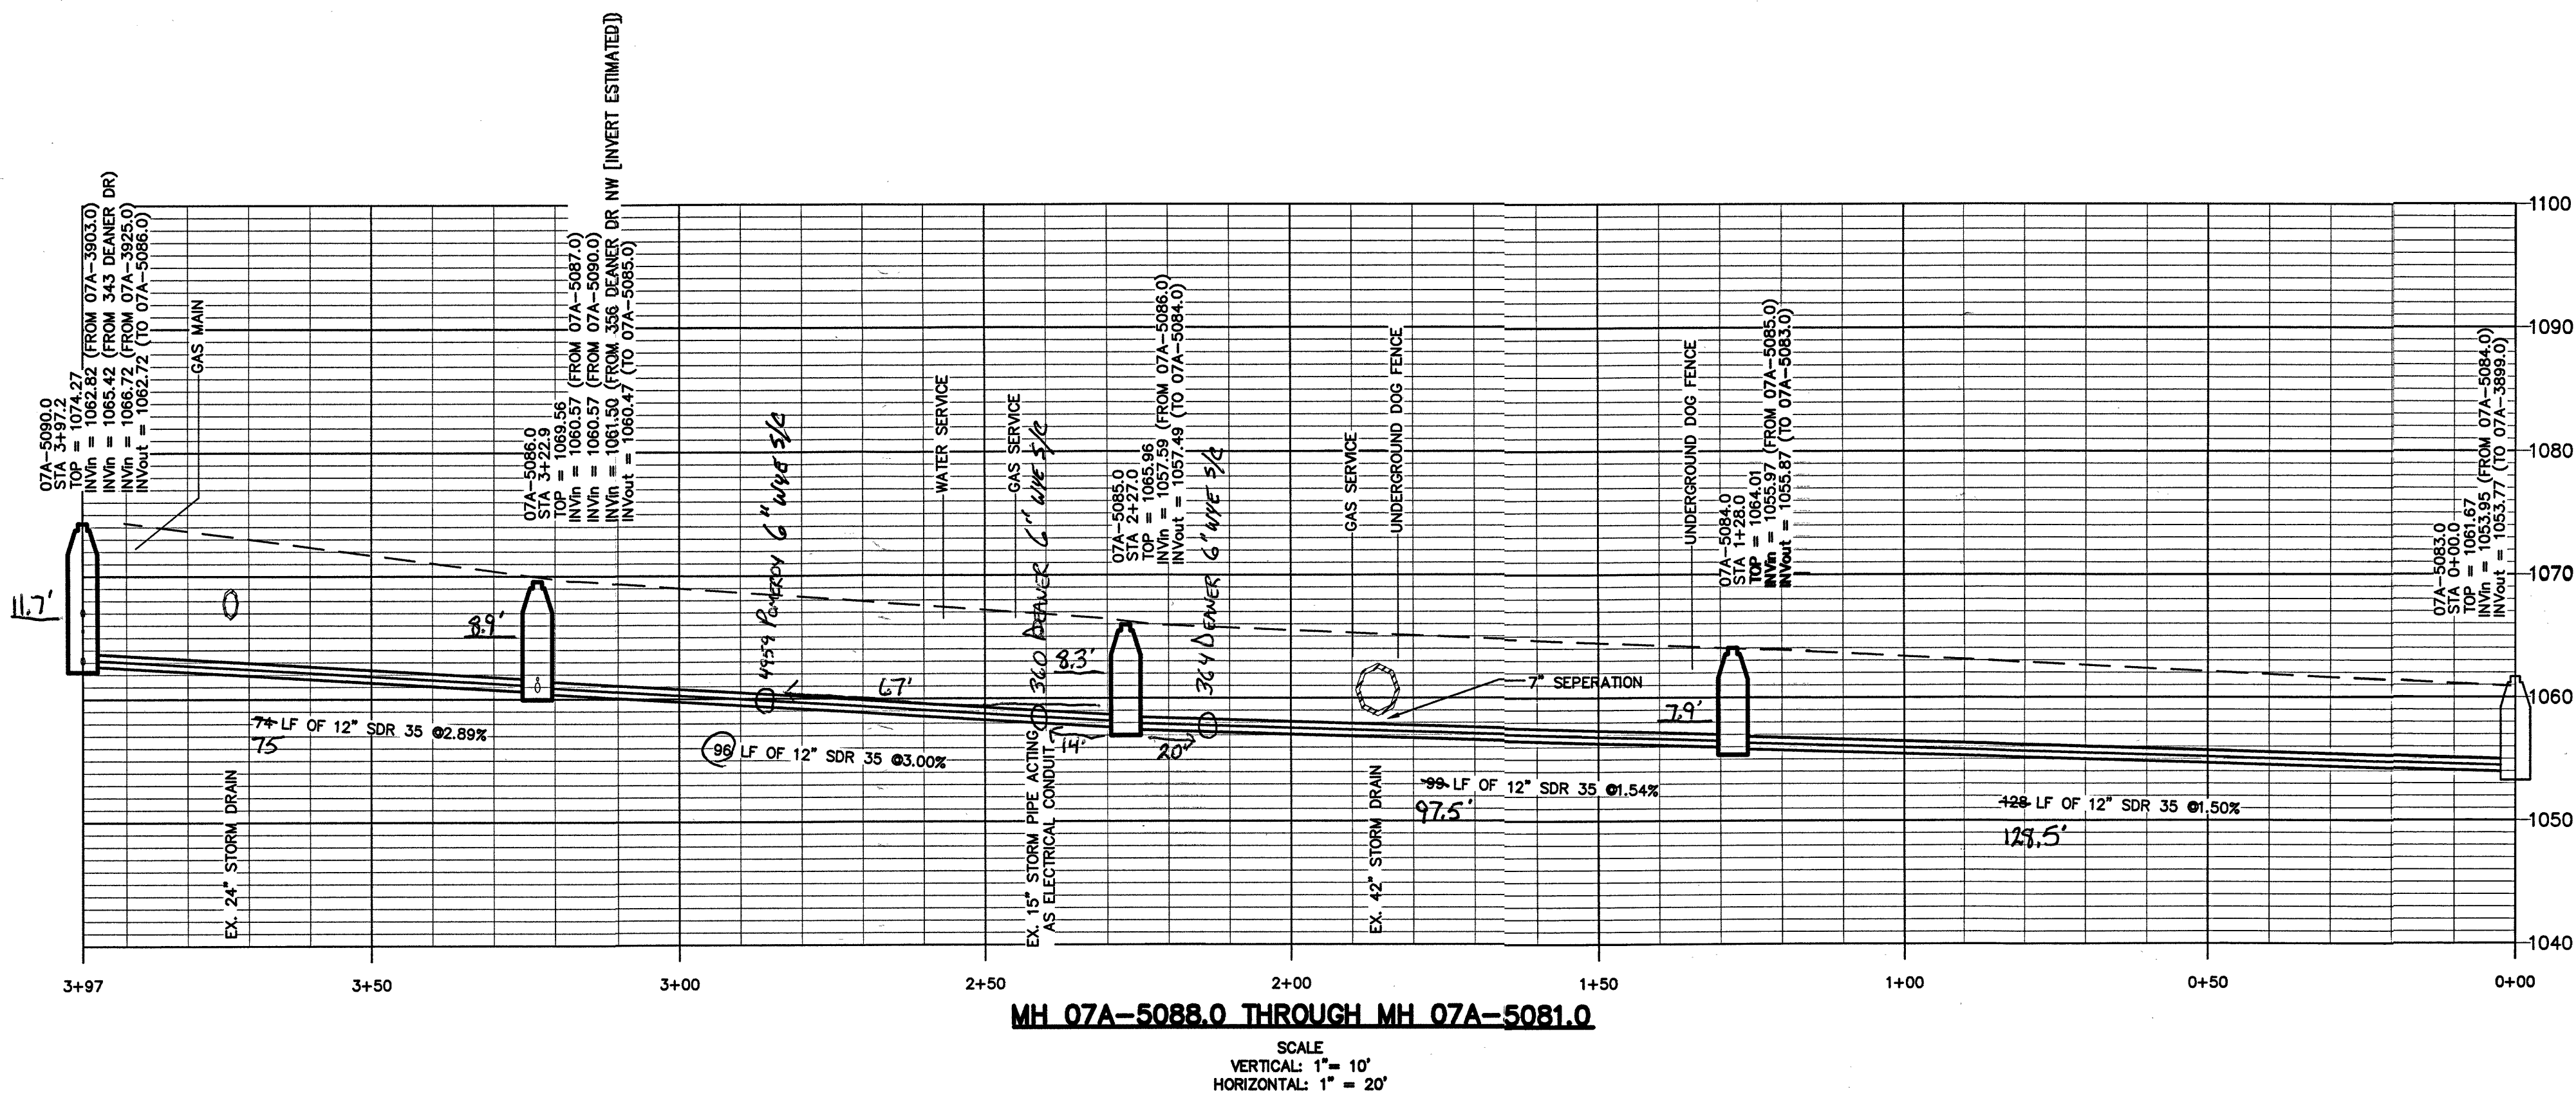


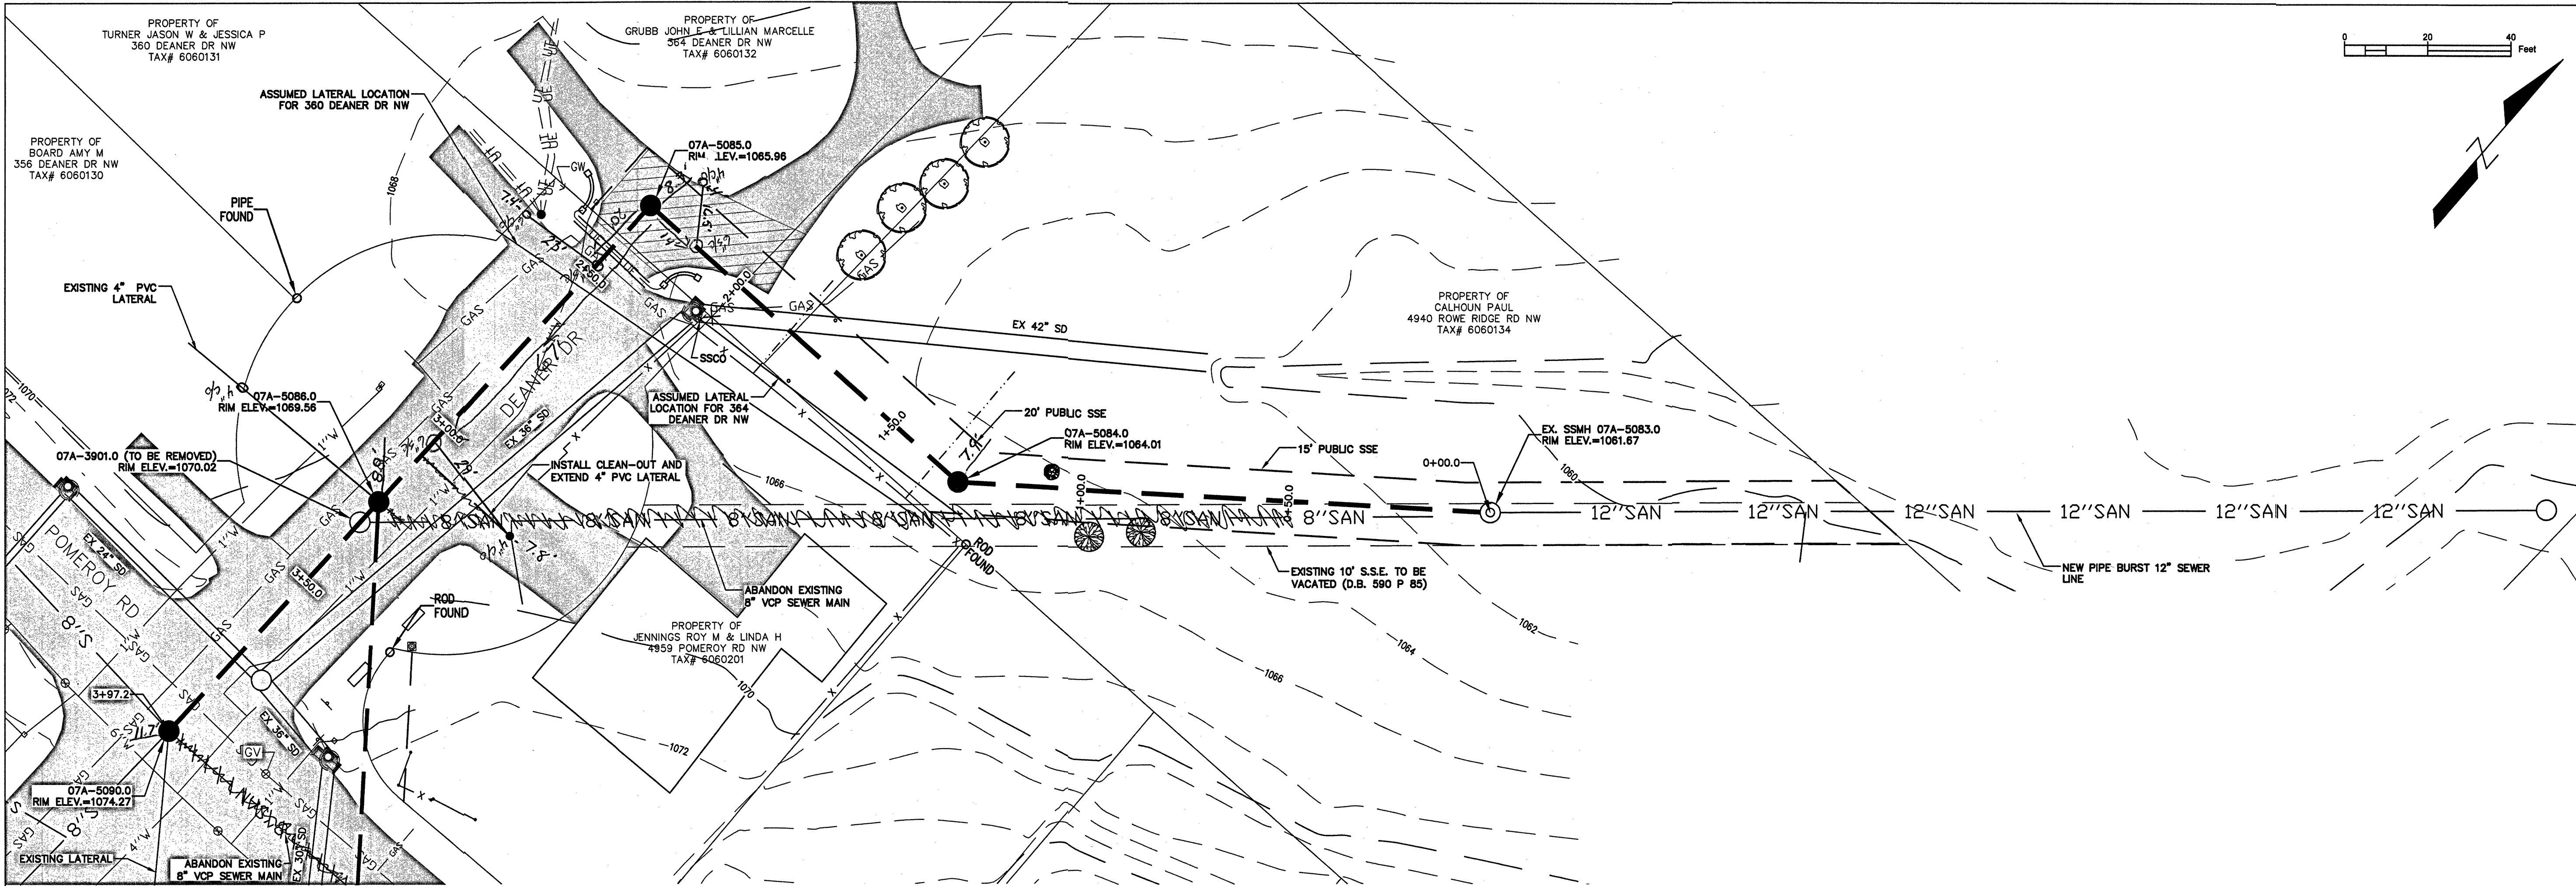

Project Name	DEANER SEWER PROJECT
Contractor	CIP 2 - TAFT BEASLEY
Install Date	AUGUST 11 TH 2017
Sewer Gravity Main(s)	
Manufacturer	U.S. PIPE COMPANY
Diameter	12" & 10"
Pipe Class	12" SDR35 / 10" SDR35 / 10" HDPE
Material	PLASTIC / PLASTIC / FUSION
Comments	
Sewer Gravity Lateral(s)	
Manufacturer	U.S. PIPE COMPANY
Diameter	6" & 4"
Pipe Class	6" SDR26 / 4" SCH 40
Material	PLASTIC / PLASTIC
Comments	
Sewer Manhole(s)	
Manufacturer	EAST JORDAN
Material	STEEL
Ring & Cover Manuf.	EAST JORDAN
Cover Type	STANDARD
Comments	

WESTERN VIRGINIA

WATER AUTHORITY

ENGINEERING SERVICES

601 S JEFFERSON ST, SUITE 300

ROANOKE, VA 24011

540-853-5641 or 540-853-5770

DEANER SEWER CIP

PLAN & PROFILE

Rev	1	2	3	4	5
Description	90% SUBMITTAL	PROPOSED PLAN	PIPE TO 12"	FINAL REVIEW	CLEANUP FOR AS-BUILT
Date	6/17/15	10/1/15	9/20/16	04/05/17	8/18/17
By	DRJ	DRJ	DRJ	DRJ	DRJ

Designed: DRJ
Checked: AAS
Approved: TEC
Date: 10/07/16
Project: 2
Sheet 2 of 2