


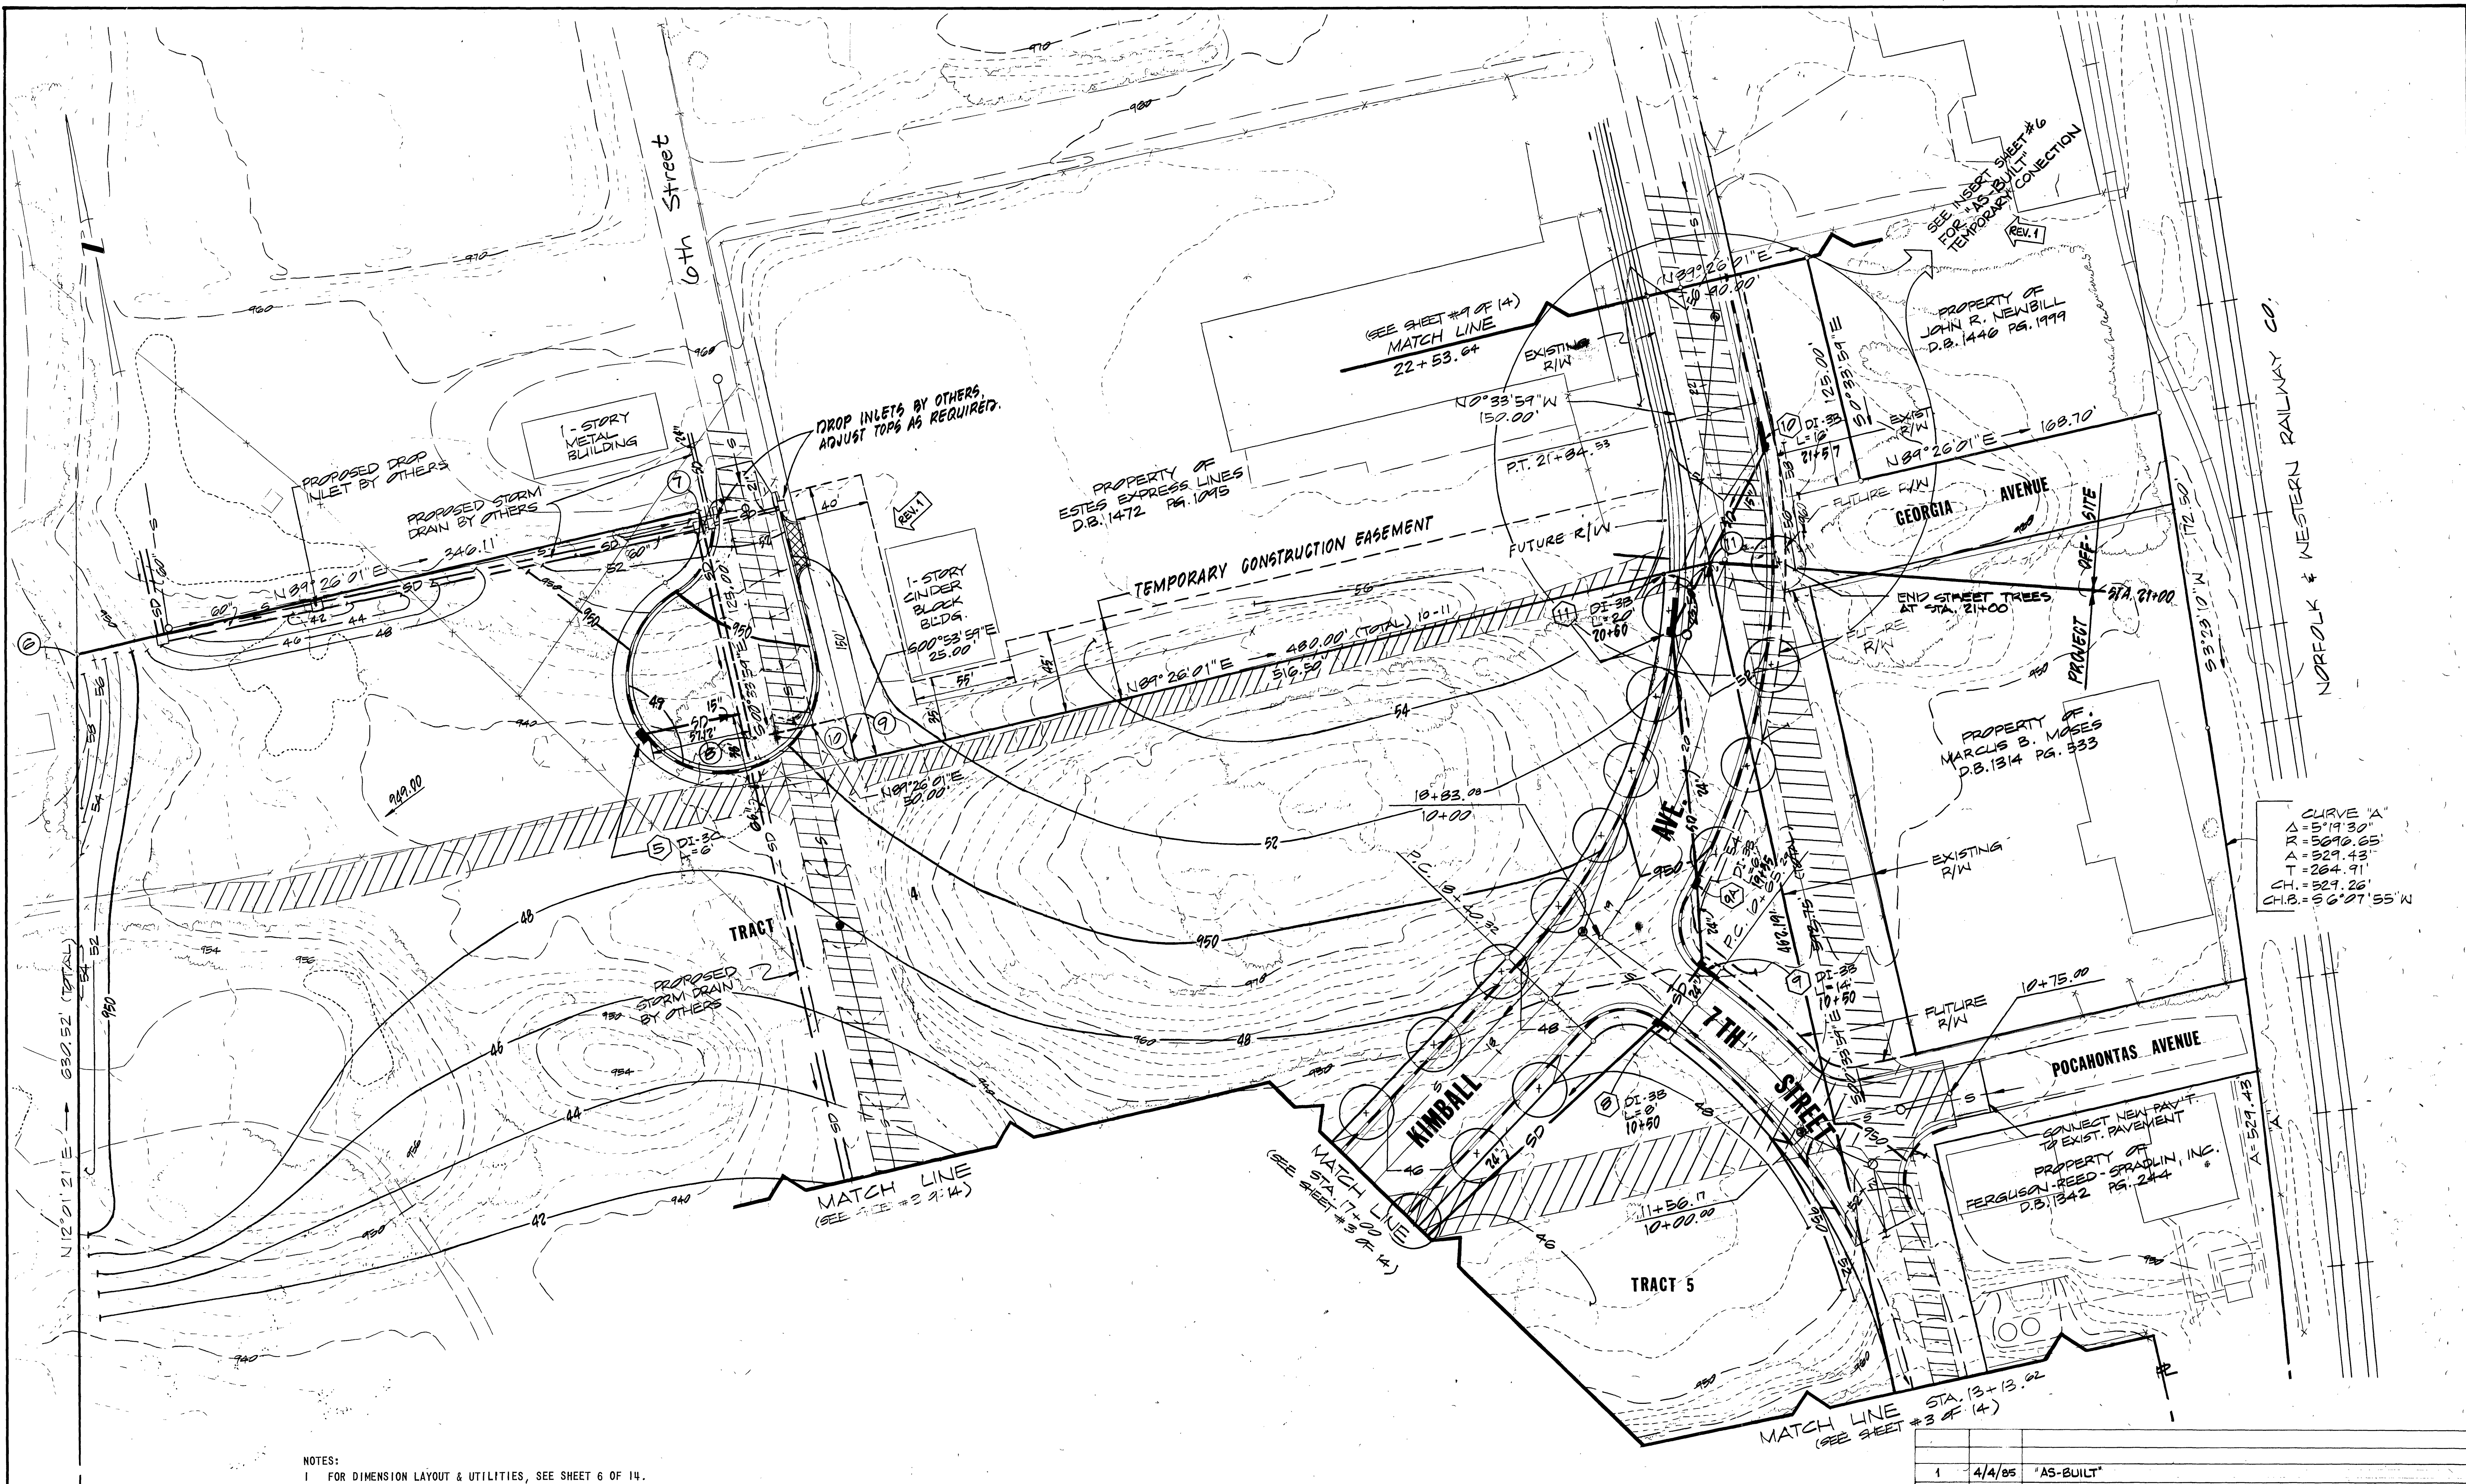

NOTES:
1. FOR DIMENSION LAYOUT & UTILITIES, SEE SHEET 6 OF 14.

"BENCHMARK" - NAIL & WASHER IN A.P.C.O. POLE #254-4548 50' NORTH OF INT. 6TH ST. & POCAHONTAS AVE. ELEV. = 934.43

1	4/4/85	"AS-BUILT"
REVISION	DATE	DESCRIPTION
DESIGNED	BLH	
DRAWN	T.S.B.	
CHECKED	BLH	
DEANWOOD COMMUNITY DEVELOPMENT PROGRAM (CD-2) LANDSCAPING, GRADING AND STORM DRAINAGE (NORTH)		
BUFORD T. LUMSDEN & ASSOCIATES, P.C. ENGINEERS-SURVEYORS ROANOKE, VIRGINIA		SCALE 1" = 40' DATE 23 MAR, 1984 COMM 81-338 SHEET 4 OF 14