


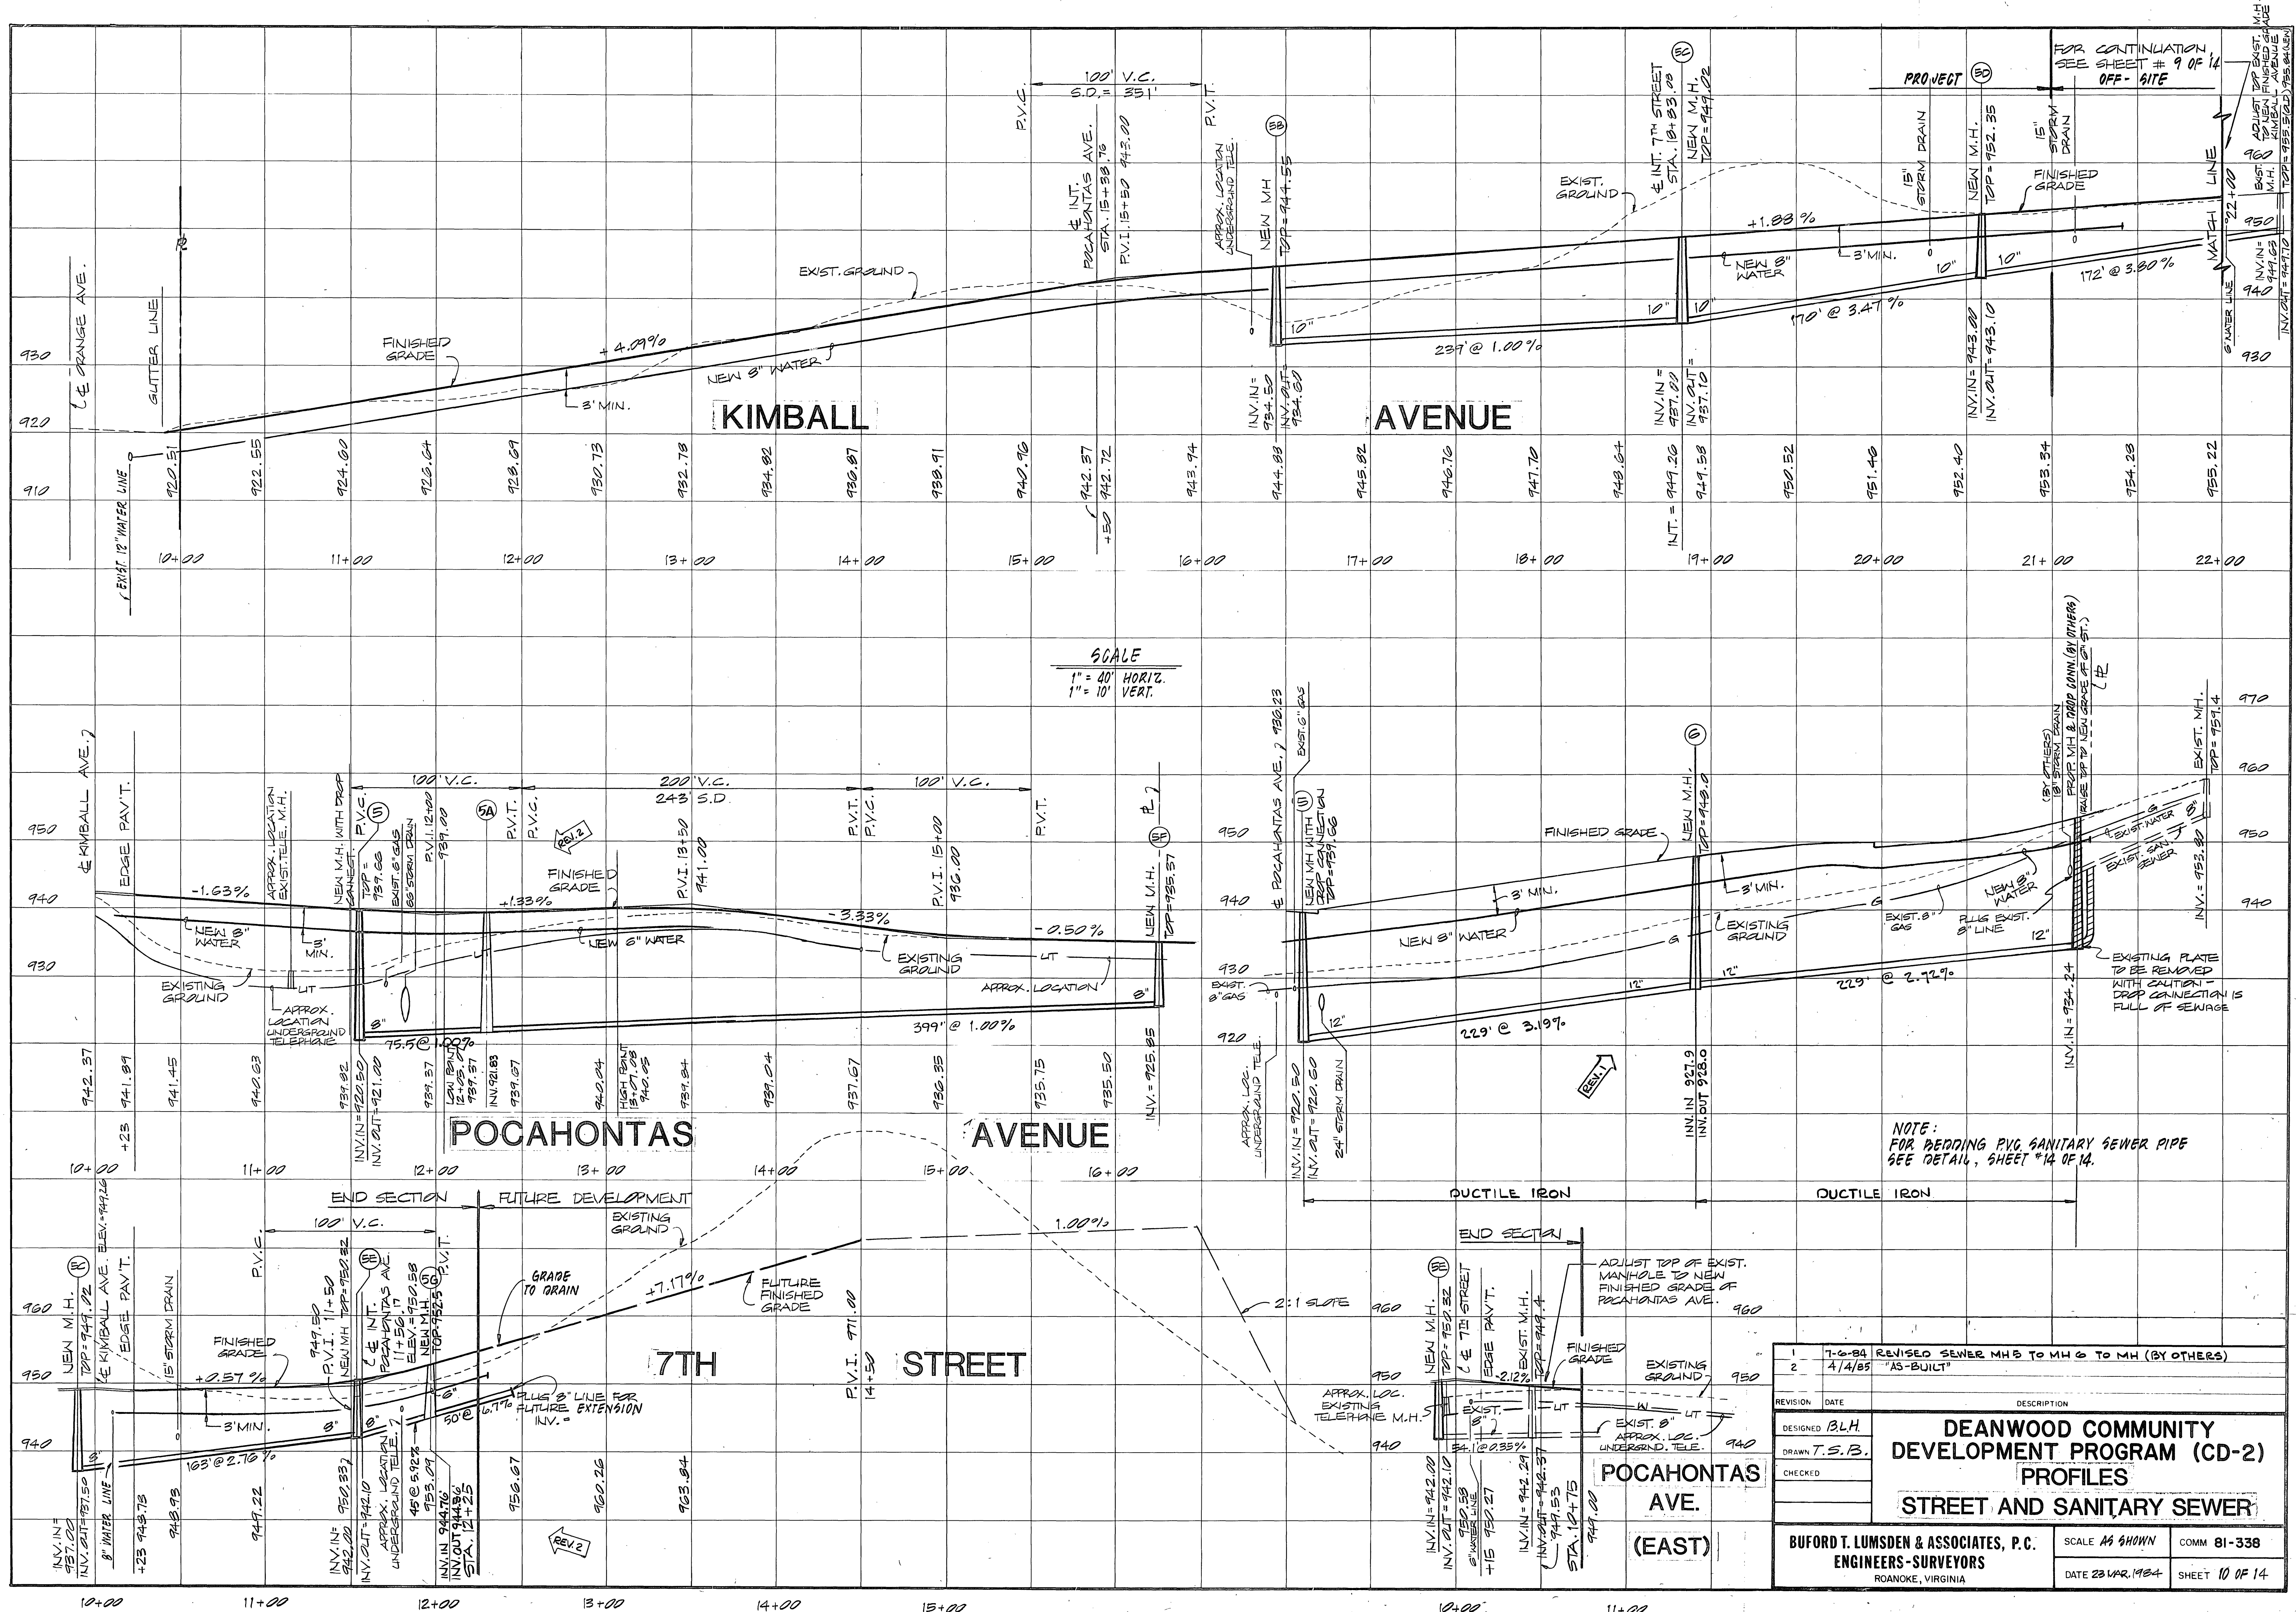

1	7-6-84	REVISED SEWER MHS TO MH 6 TO MH (BY OTHERS)
2	4/4/85	"AS-BUILT"
REVISION DATE DESCRIPTION		
DESIGNED	B.L.H.	
DRAWN	T.S.B.	
CHECKED		
DEANWOOD COMMUNITY DEVELOPMENT PROGRAM (CD-2) PROFILES STREET AND SANITARY SEWER		
BUFORD T. LUMSDEN & ASSOCIATES, P.C. ENGINEERS-SURVEYORS ROANOKE, VIRGINIA		
SCALE	AS SHOWN	COMM 81-338
DATE	23 APR. 1984	SHEET 10 OF 14