
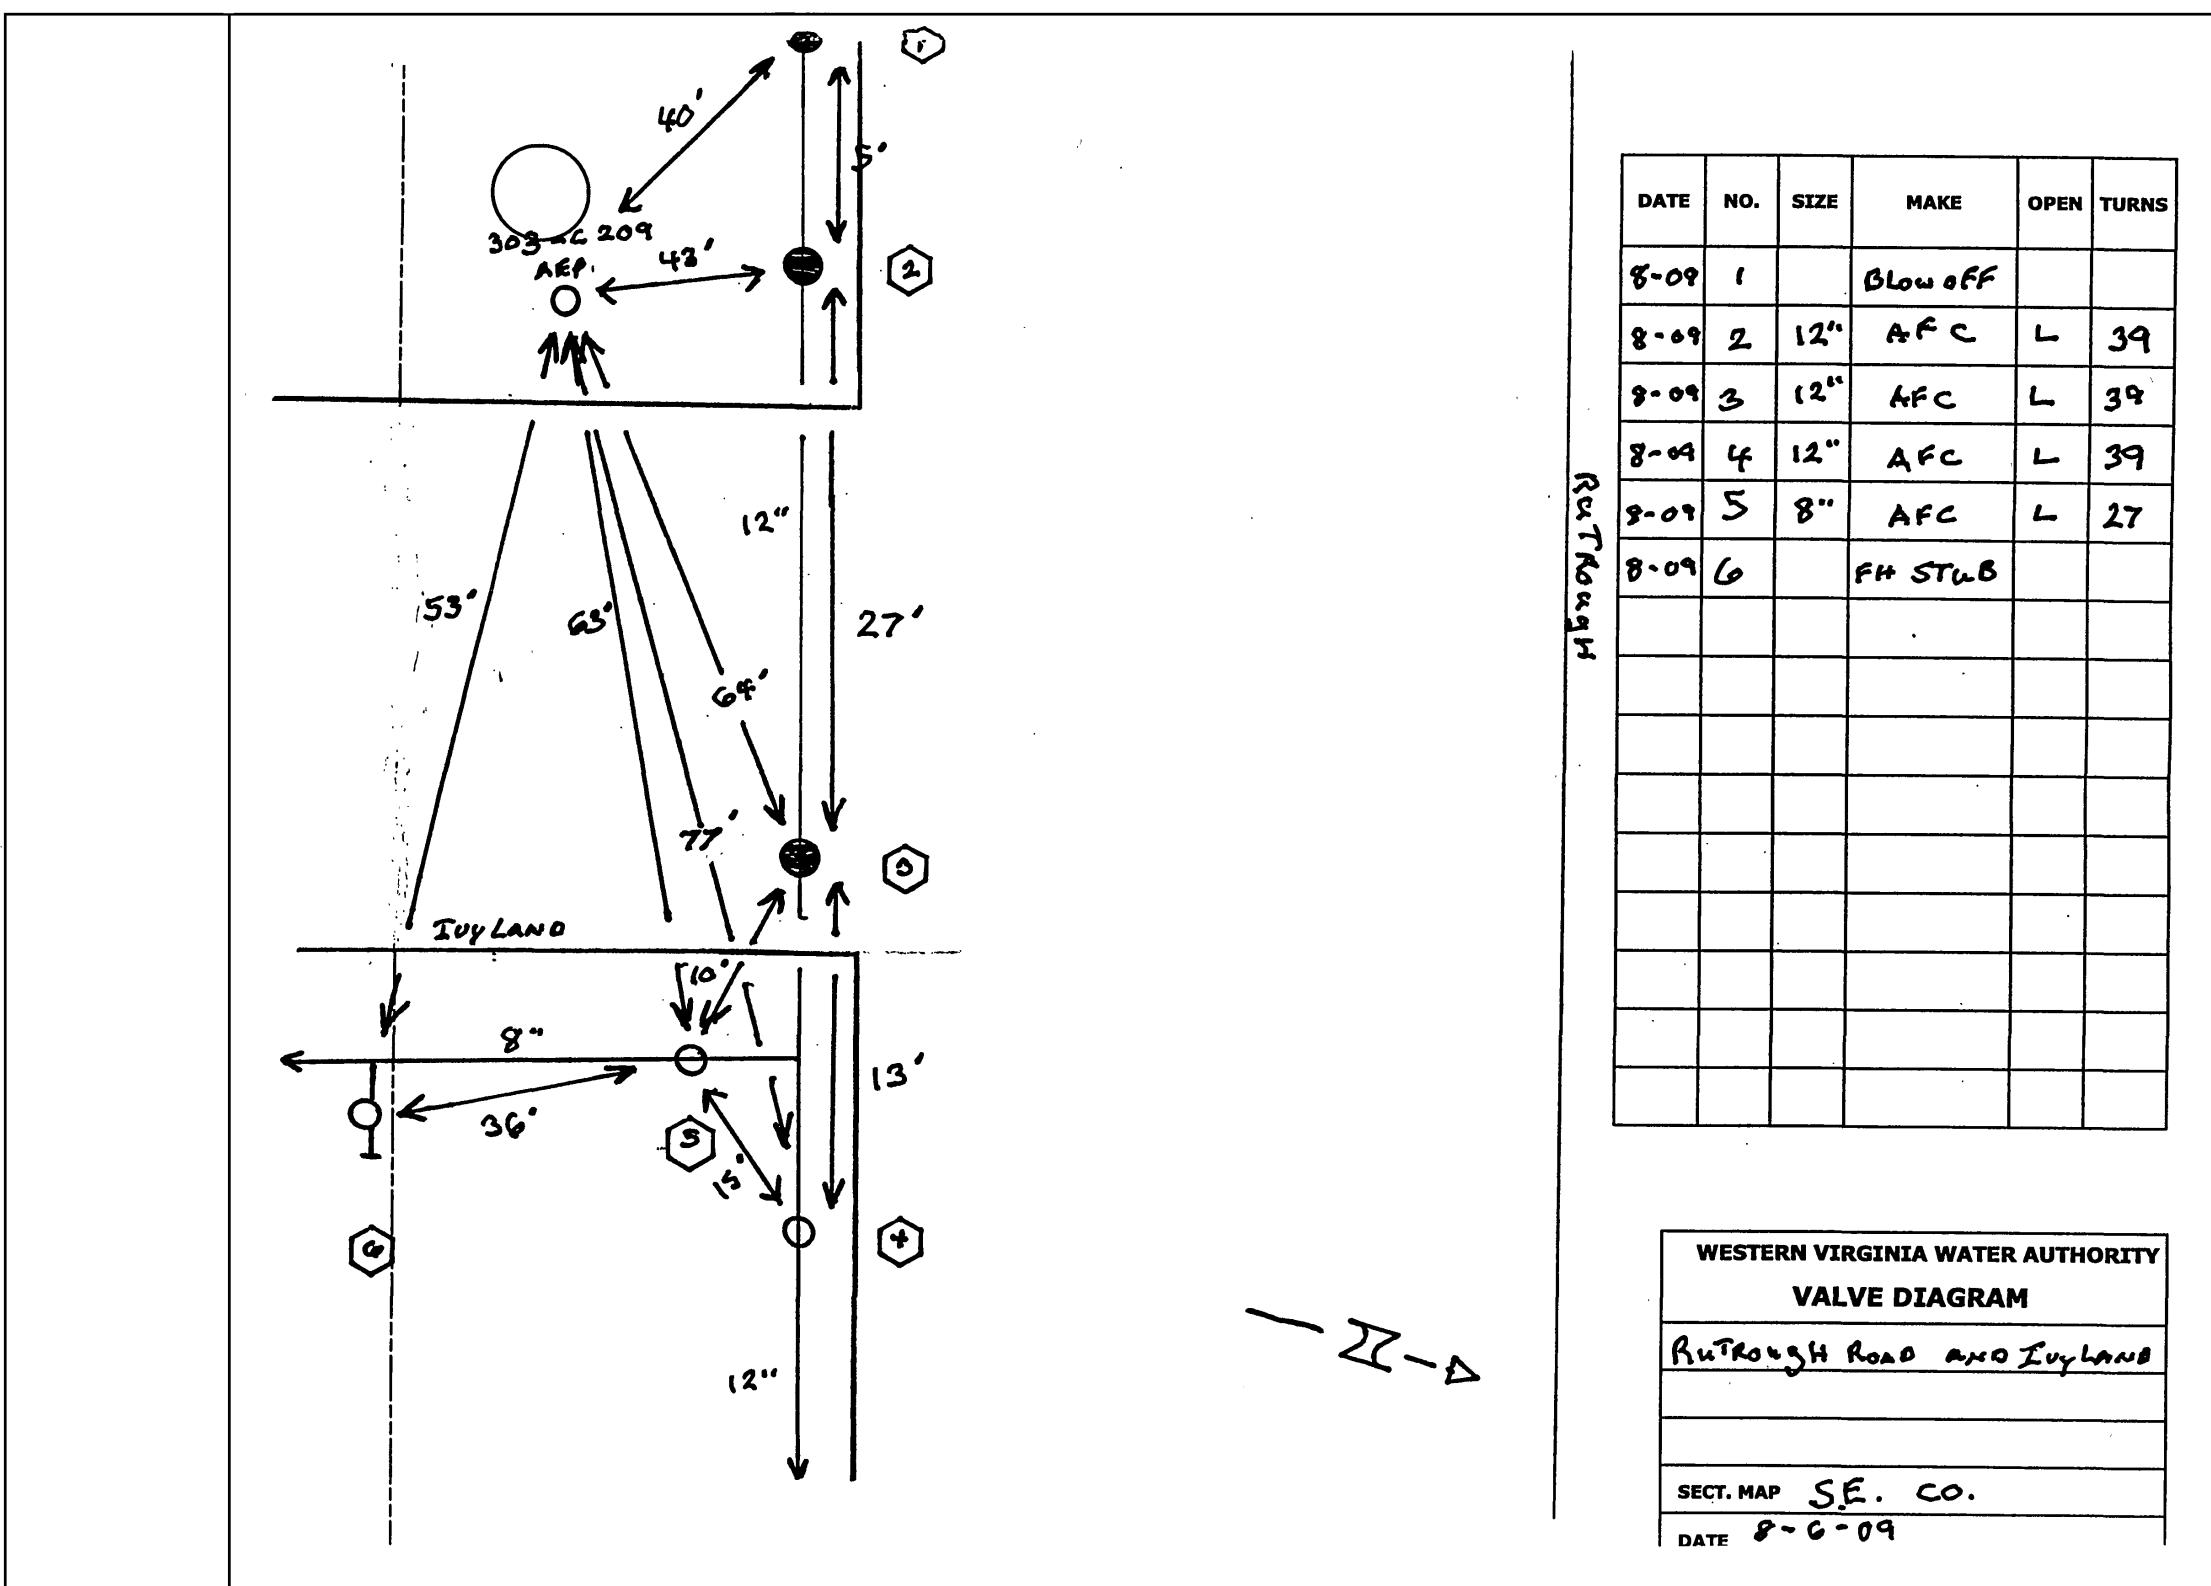
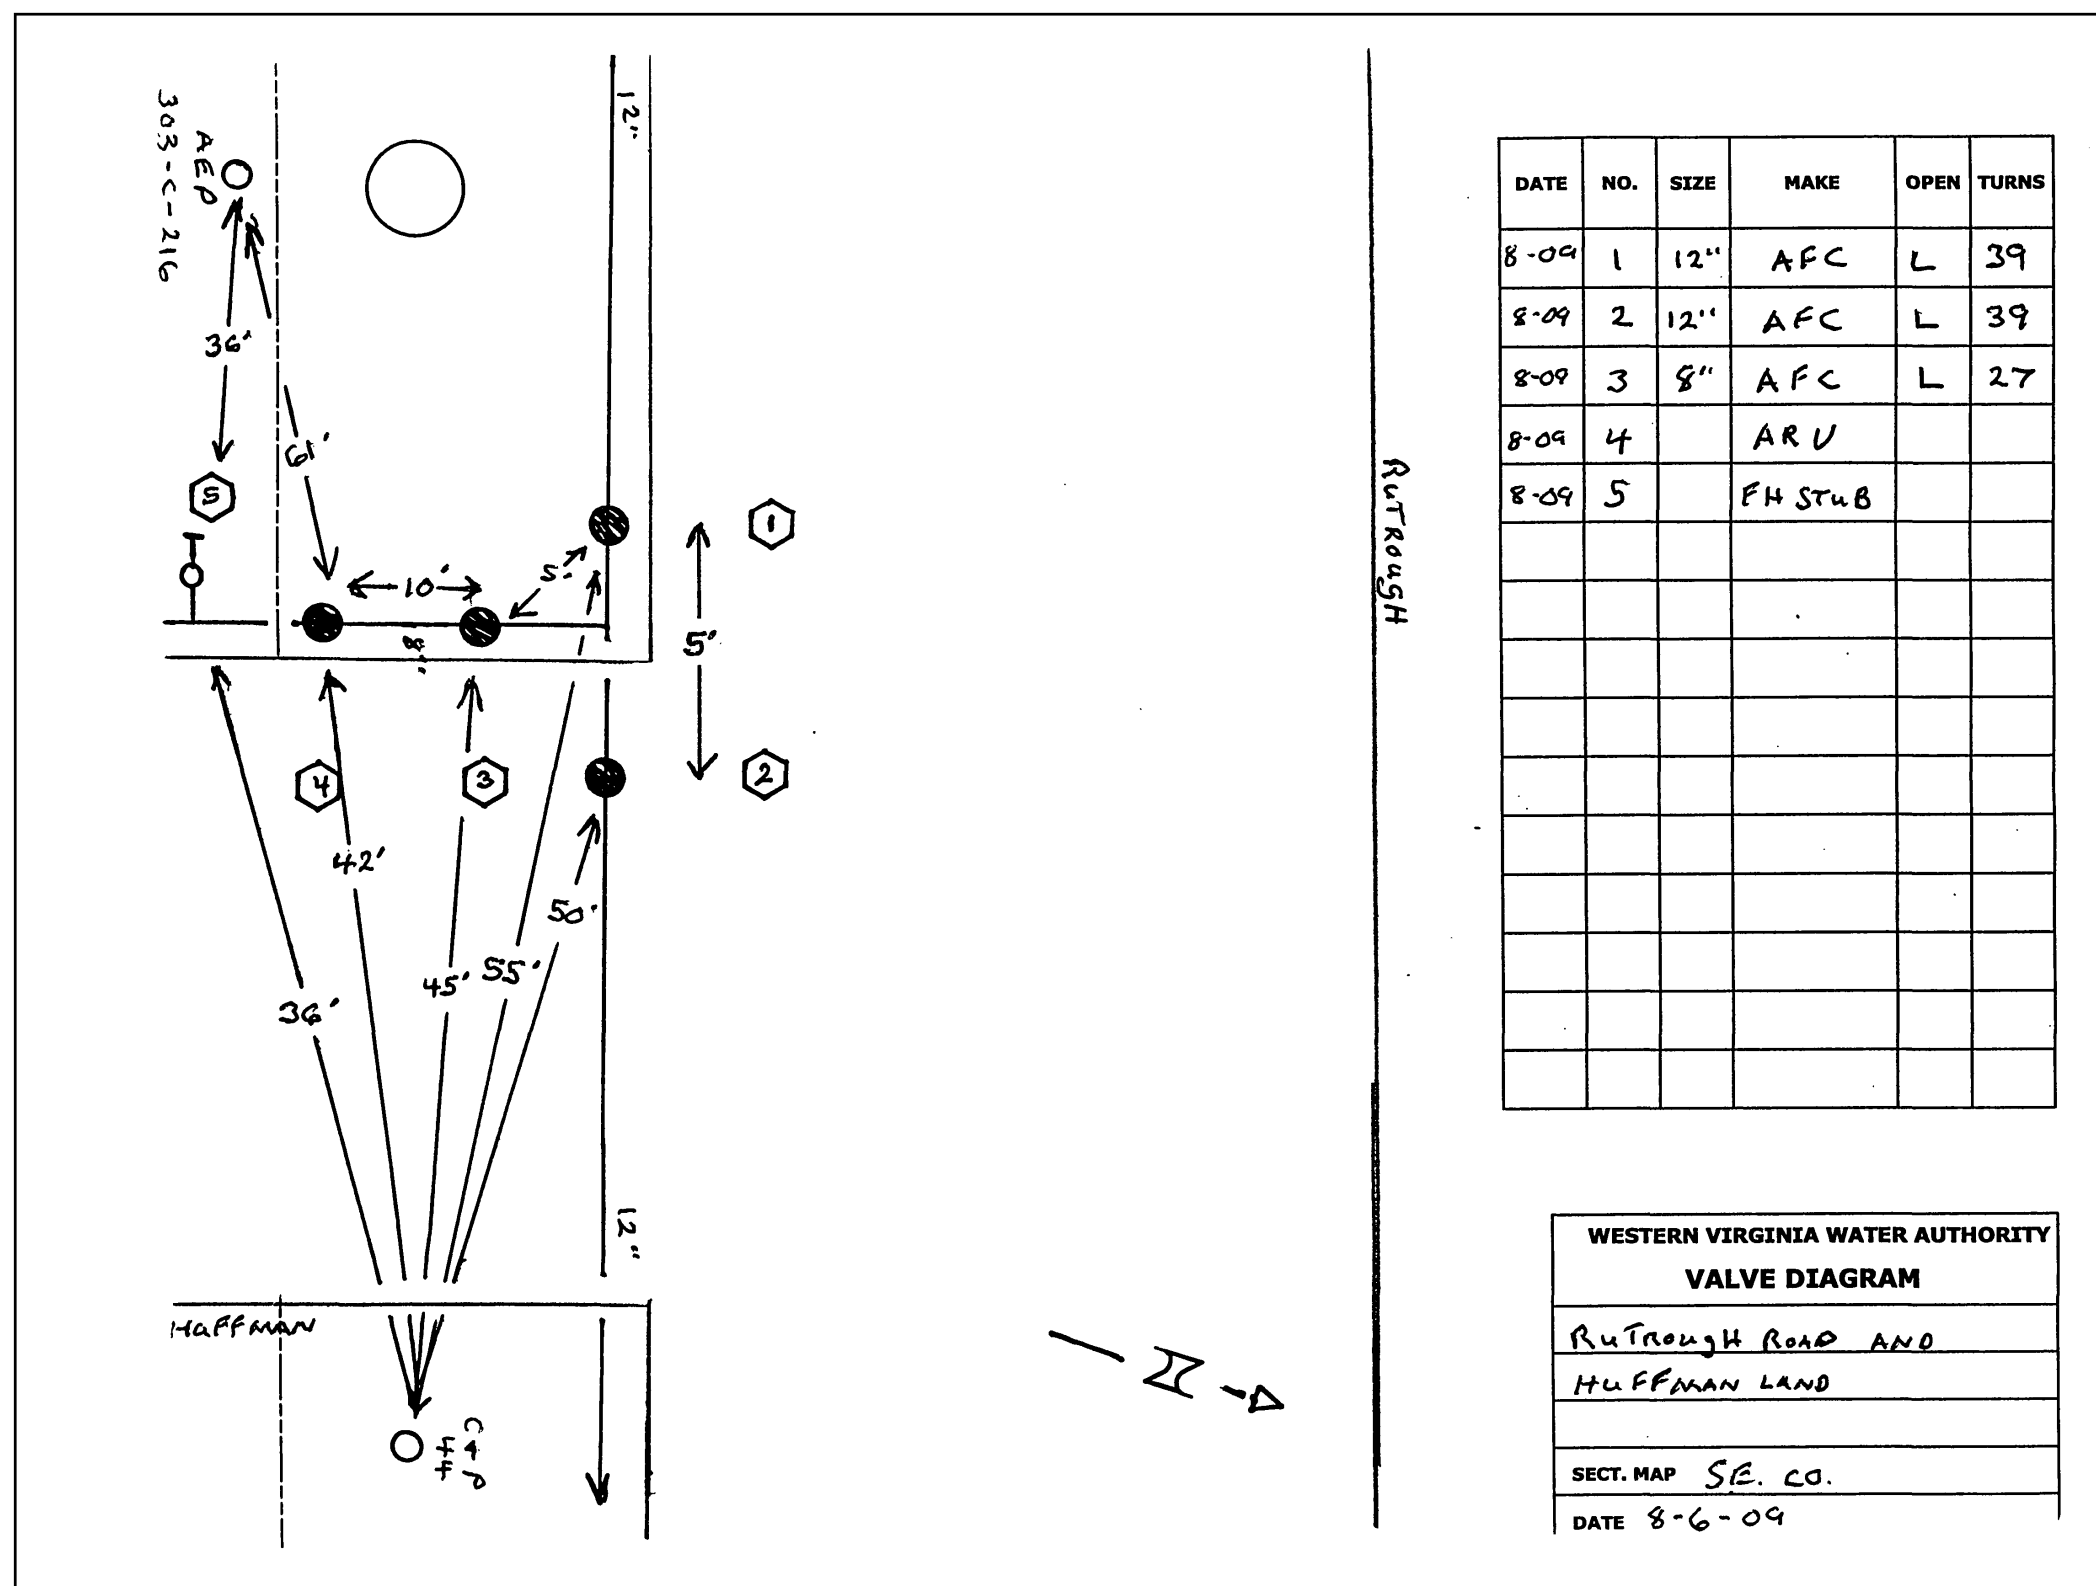
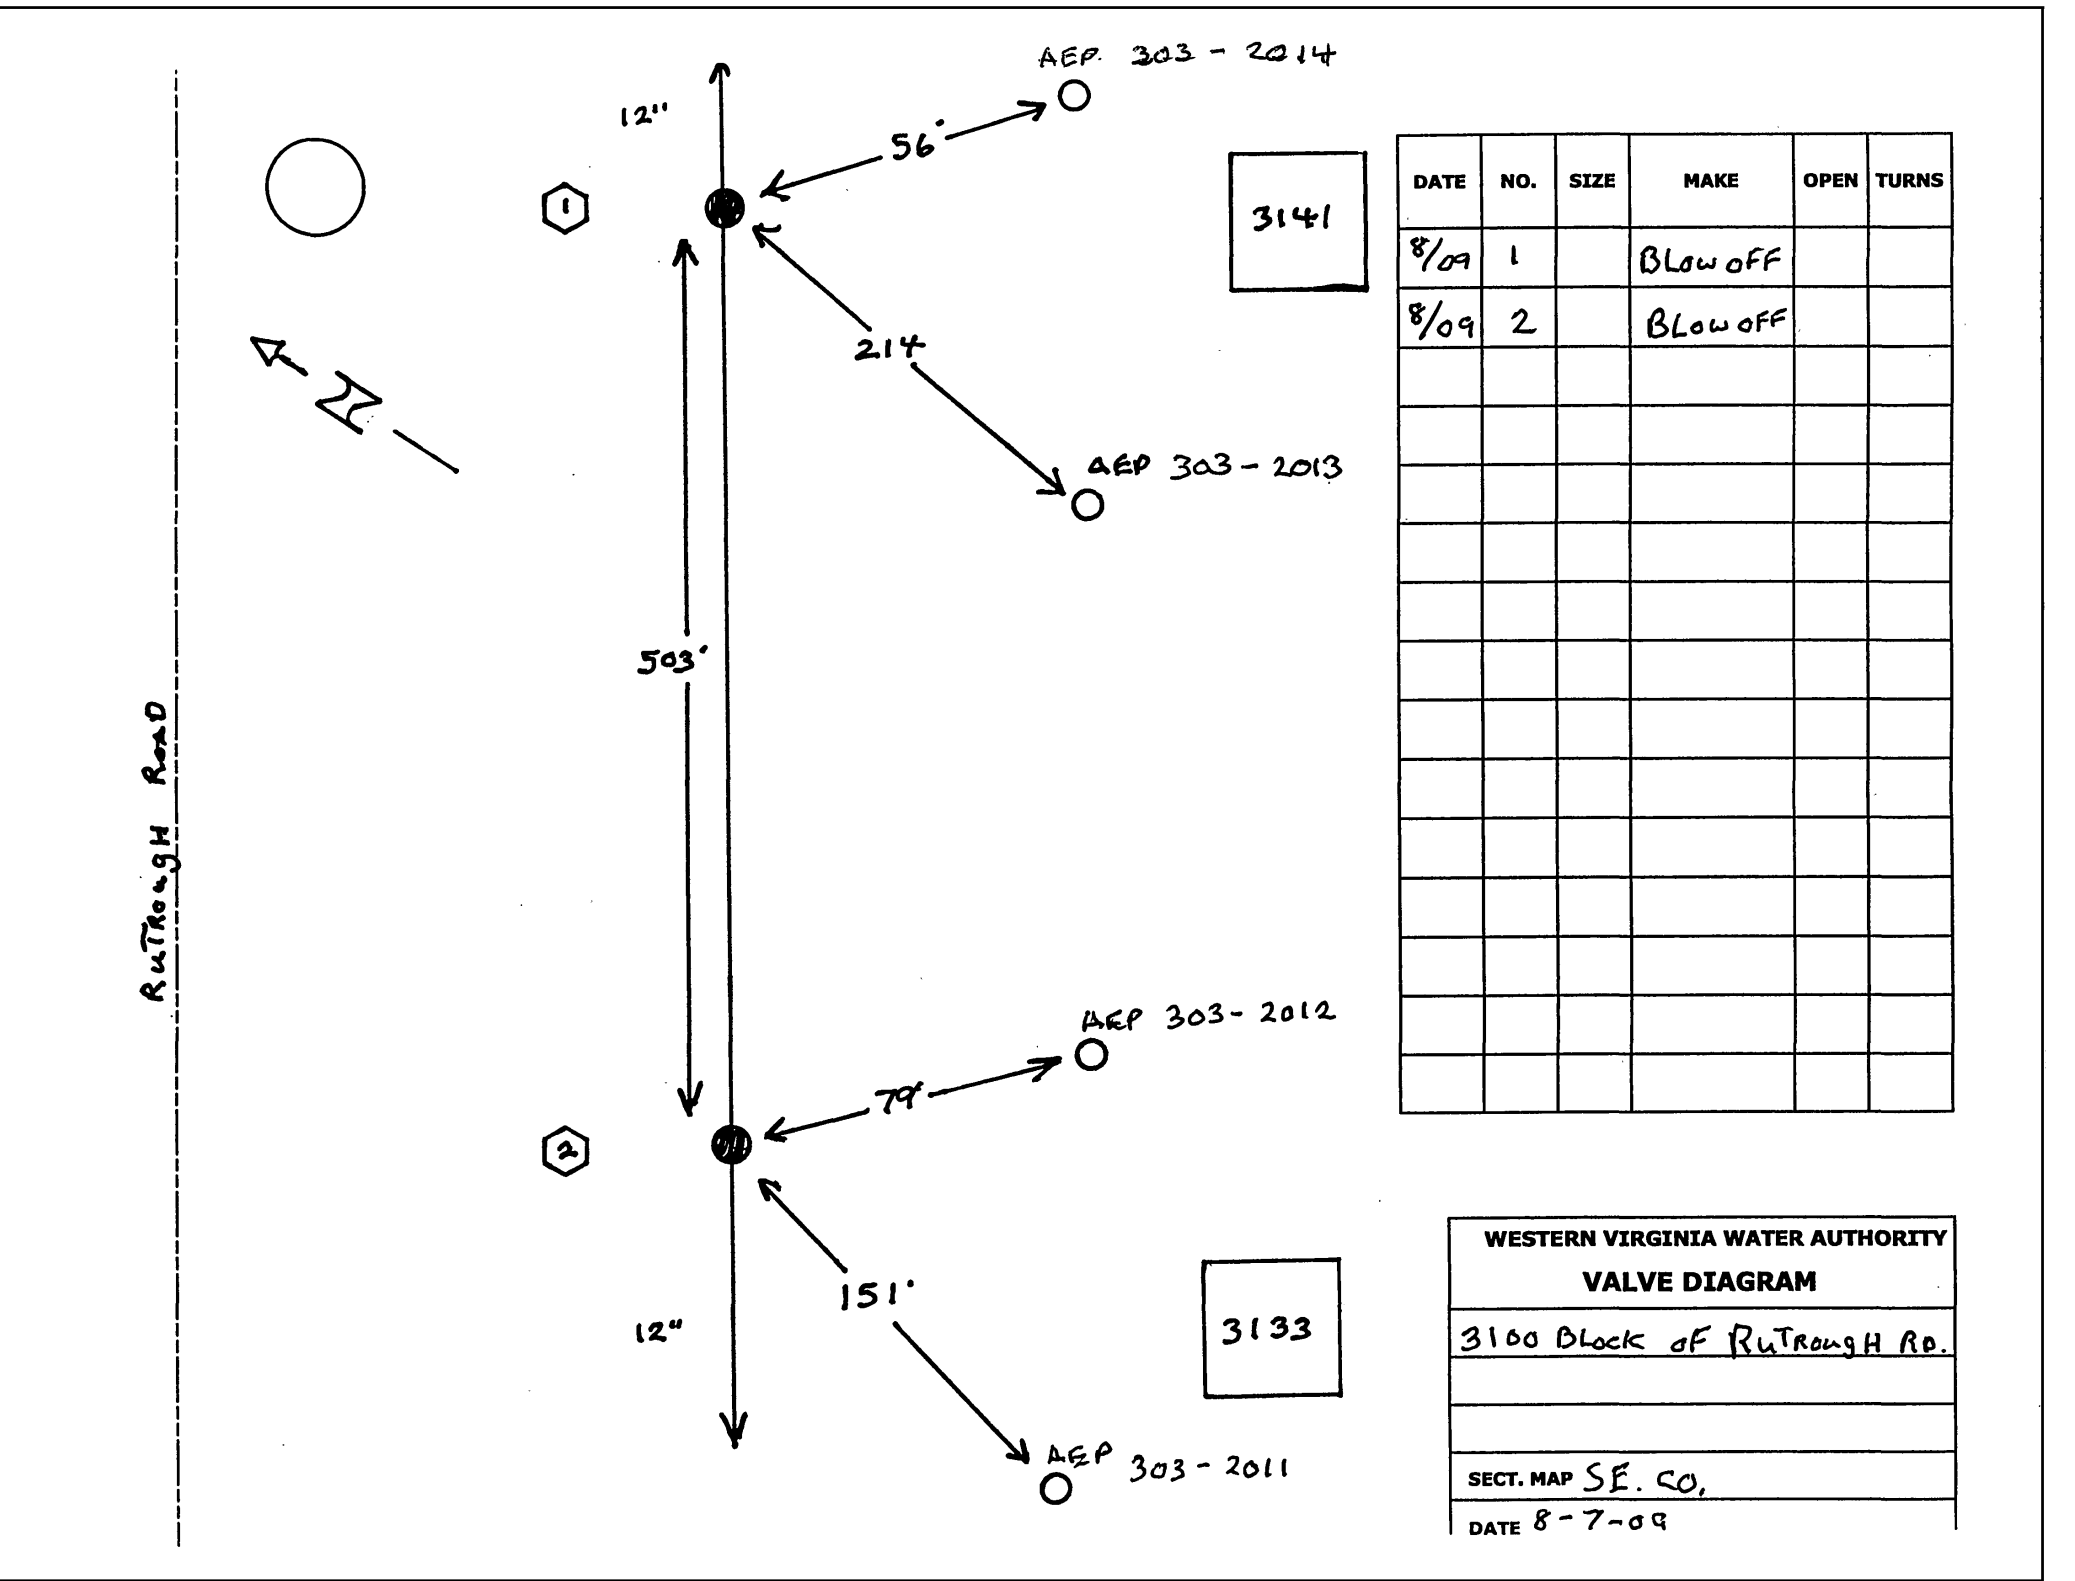
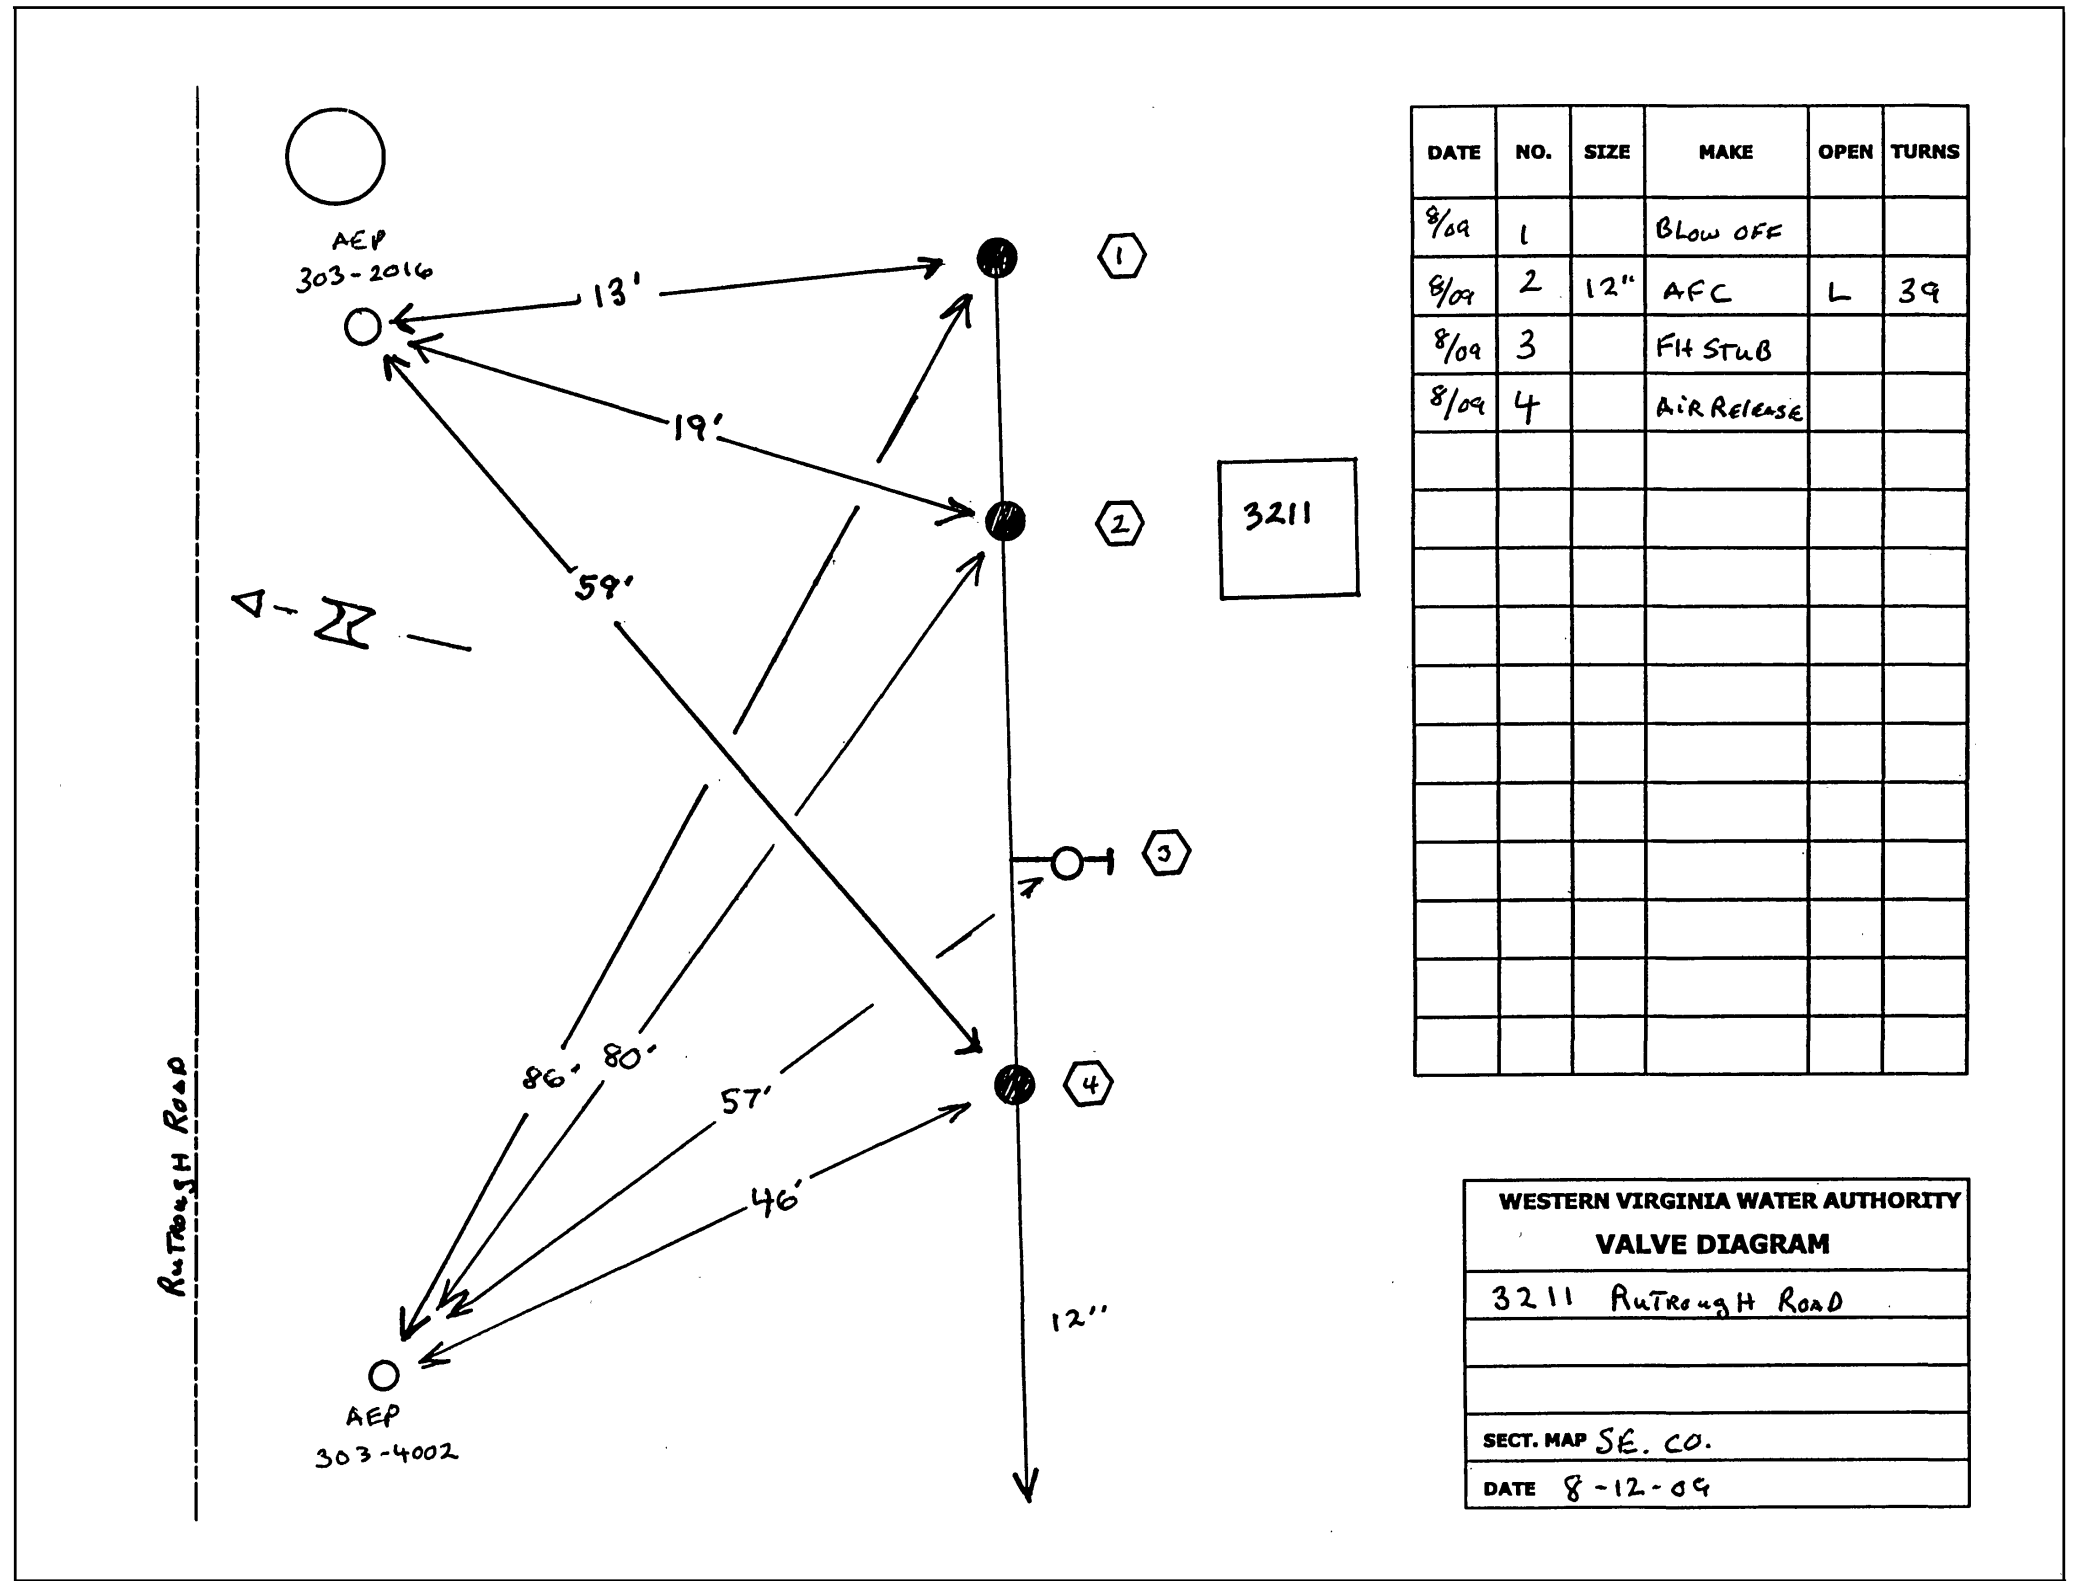


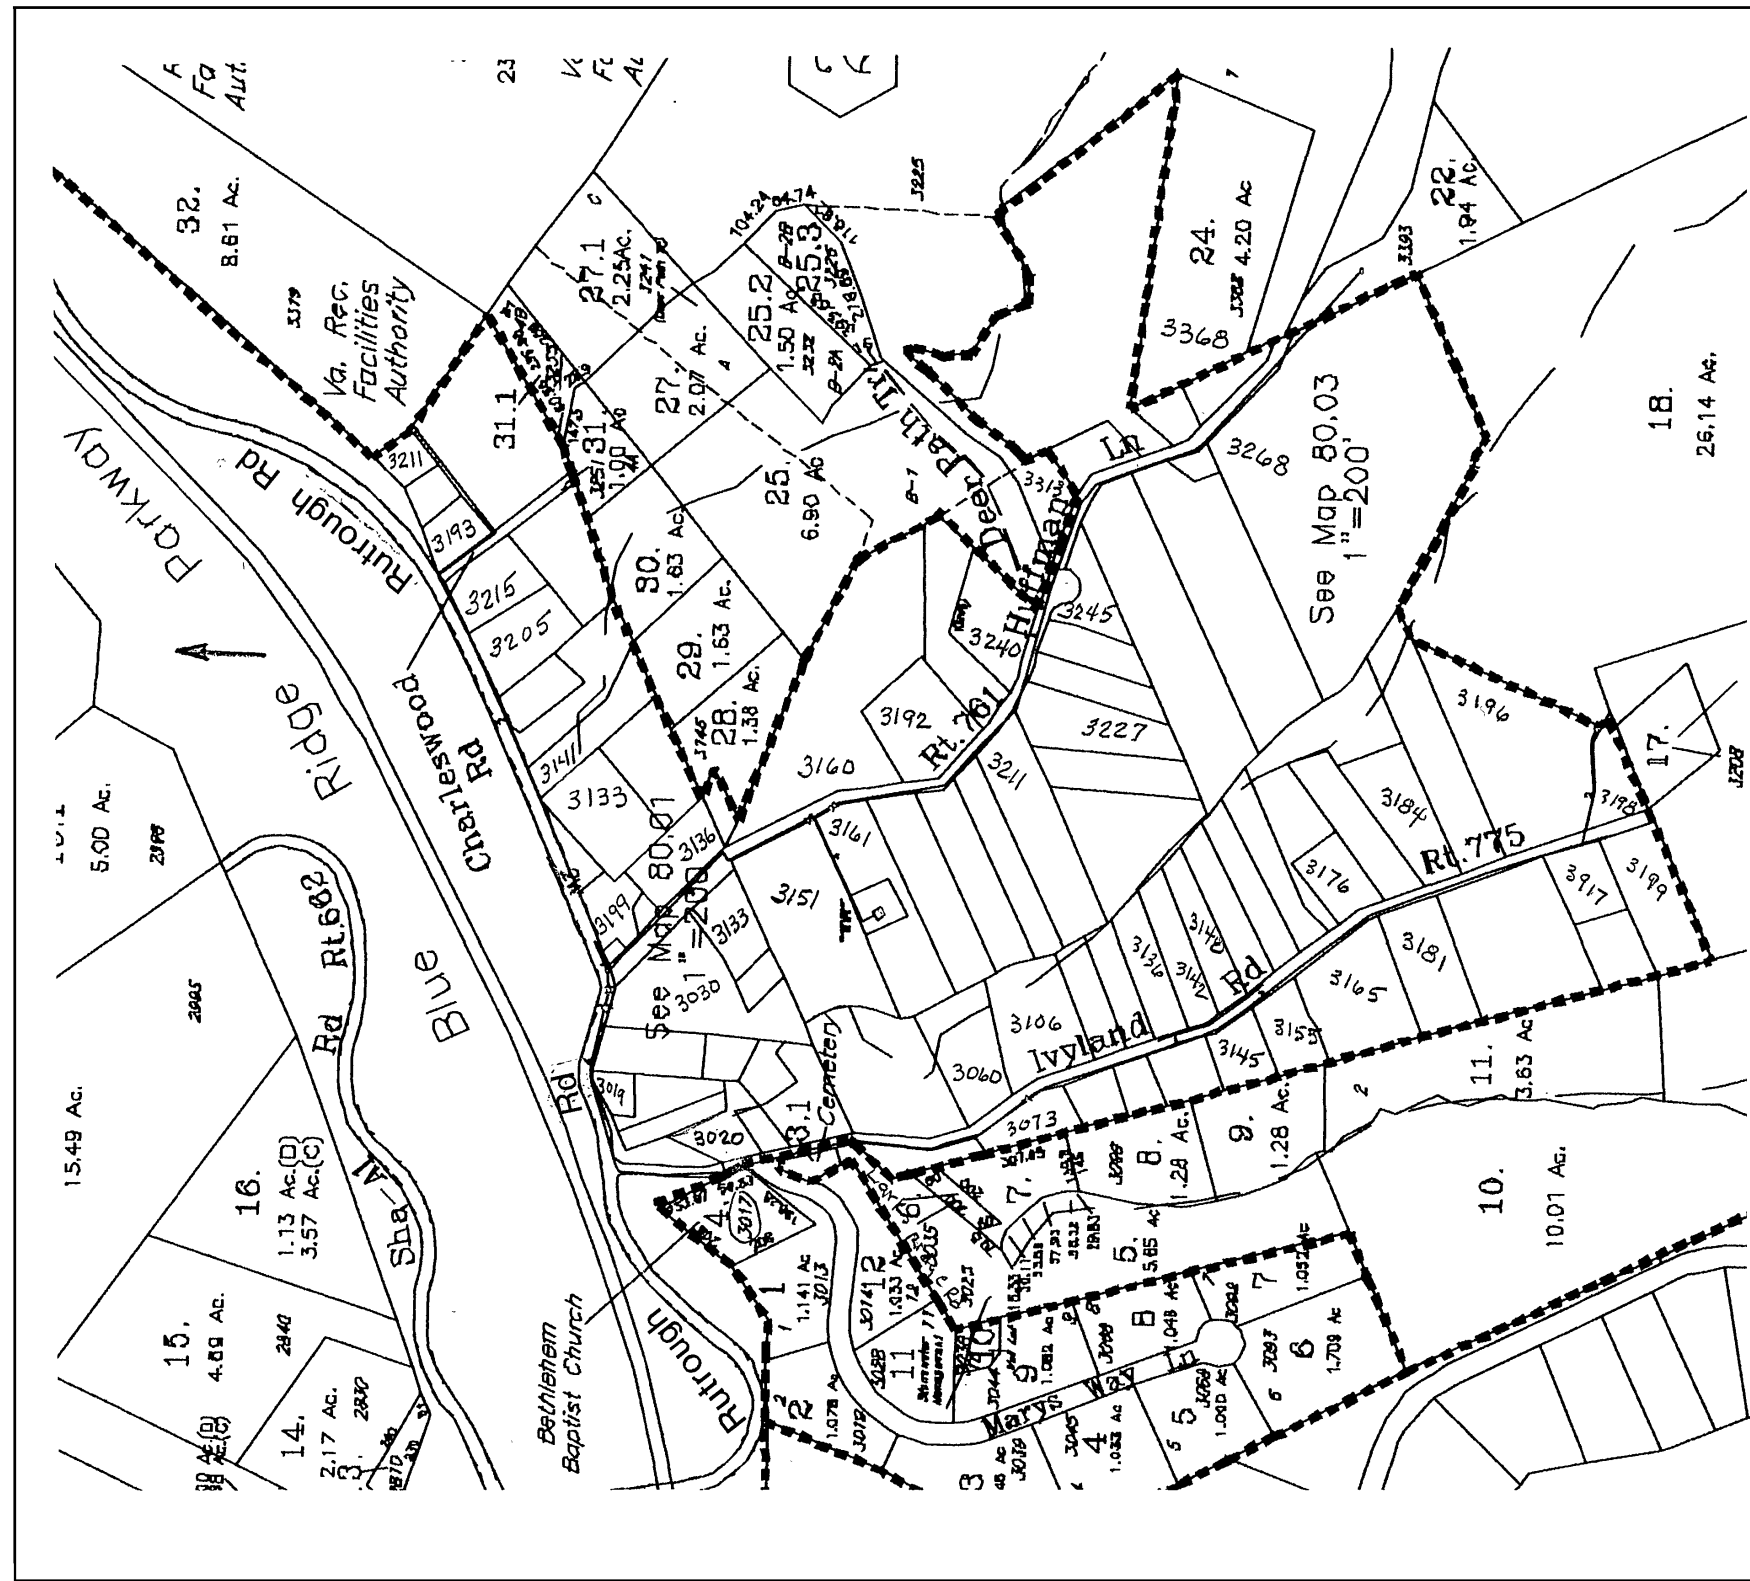

SEE PLAN SHEET 3 of 12 RUTROUGH ROAD STA 10+00.00 TO STA 20+00.00
SEE PLAN SHEET 4 of 12 RUTROUGH ROAD STA 20+00.00 TO STA 28+17.38

VALVE SHEETS

Delaney Court
Waterline Replacement
Western Virginia Water Authority
Roanoke County, Virginia