
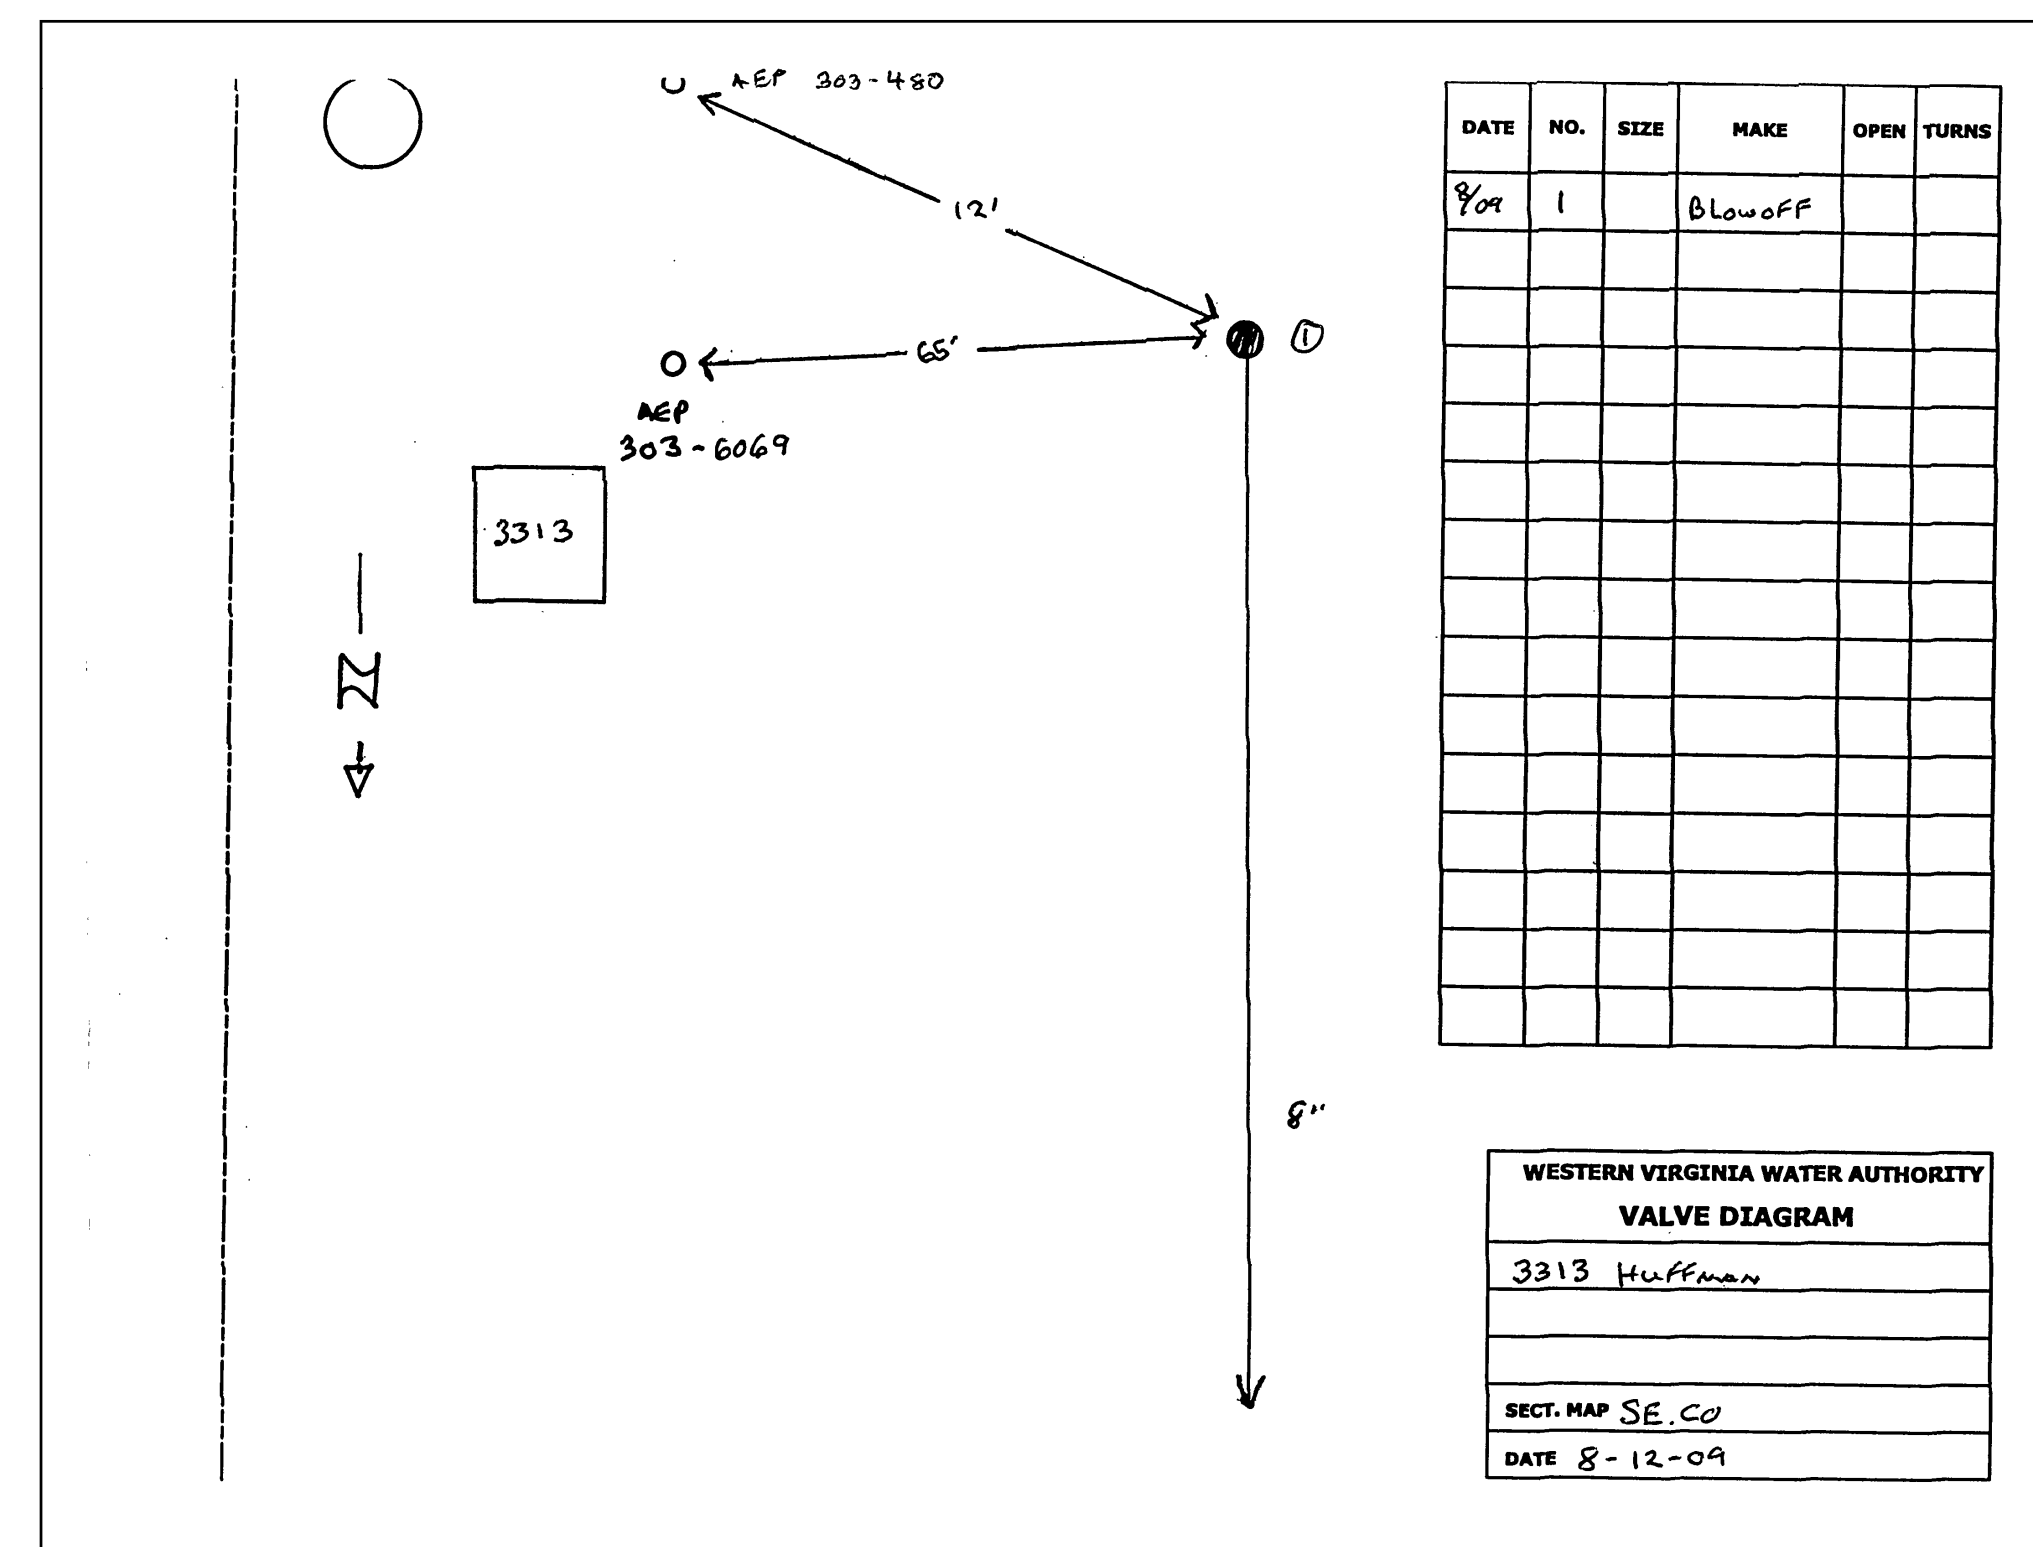
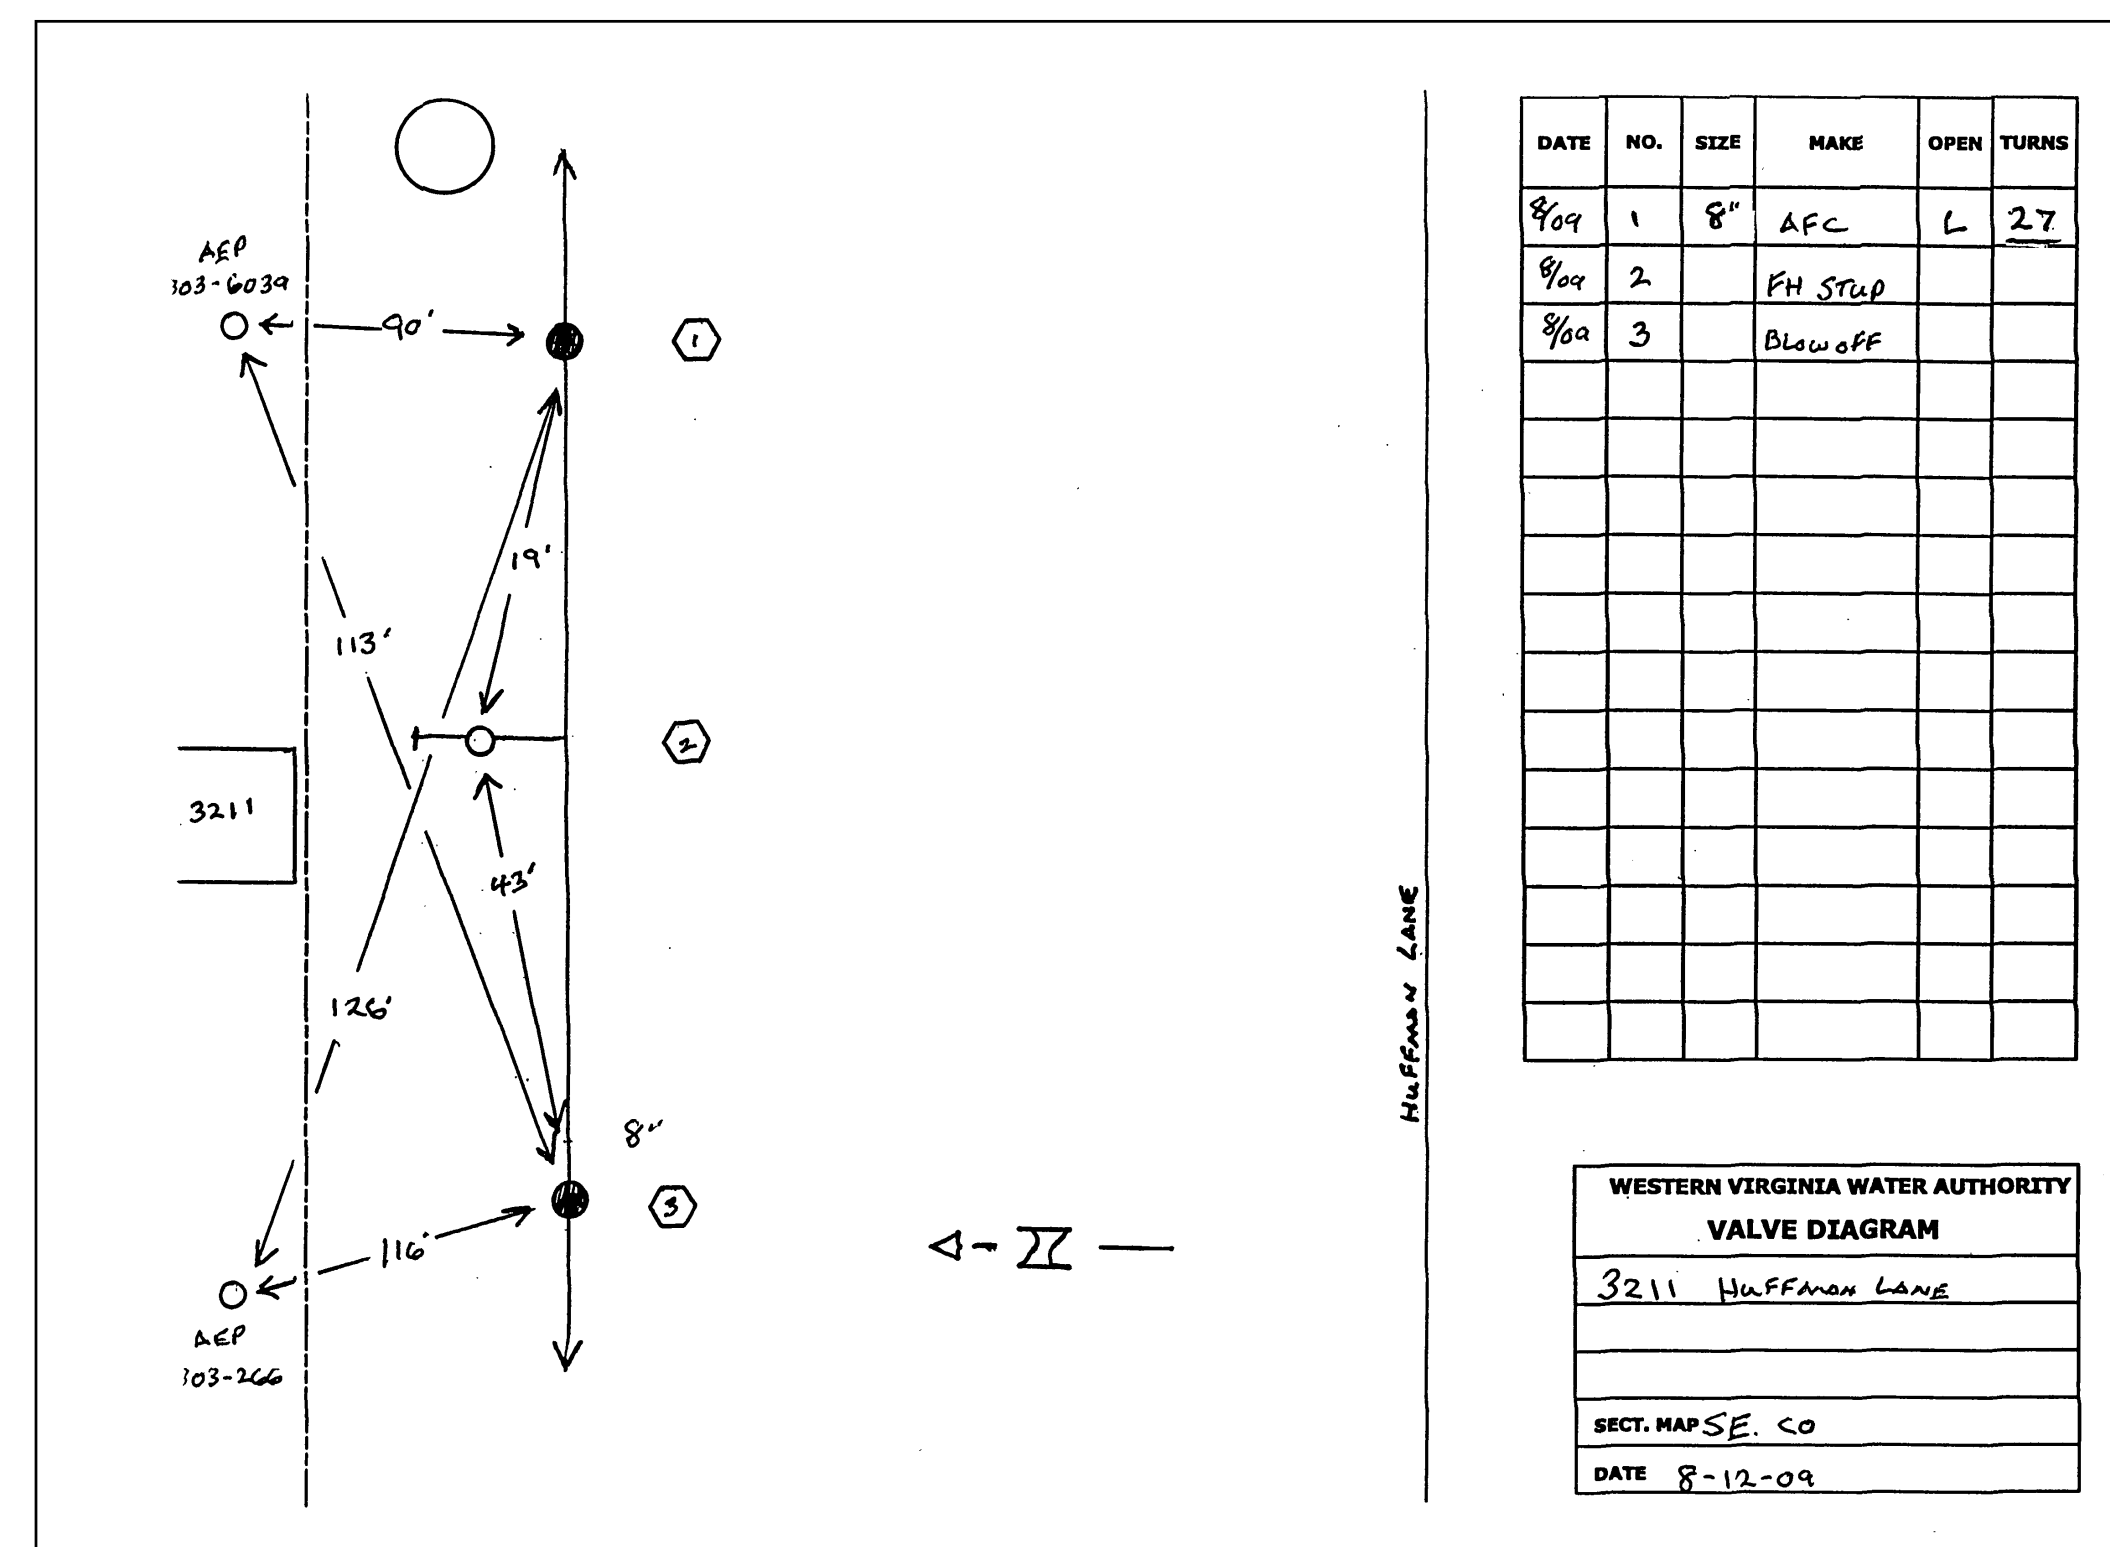
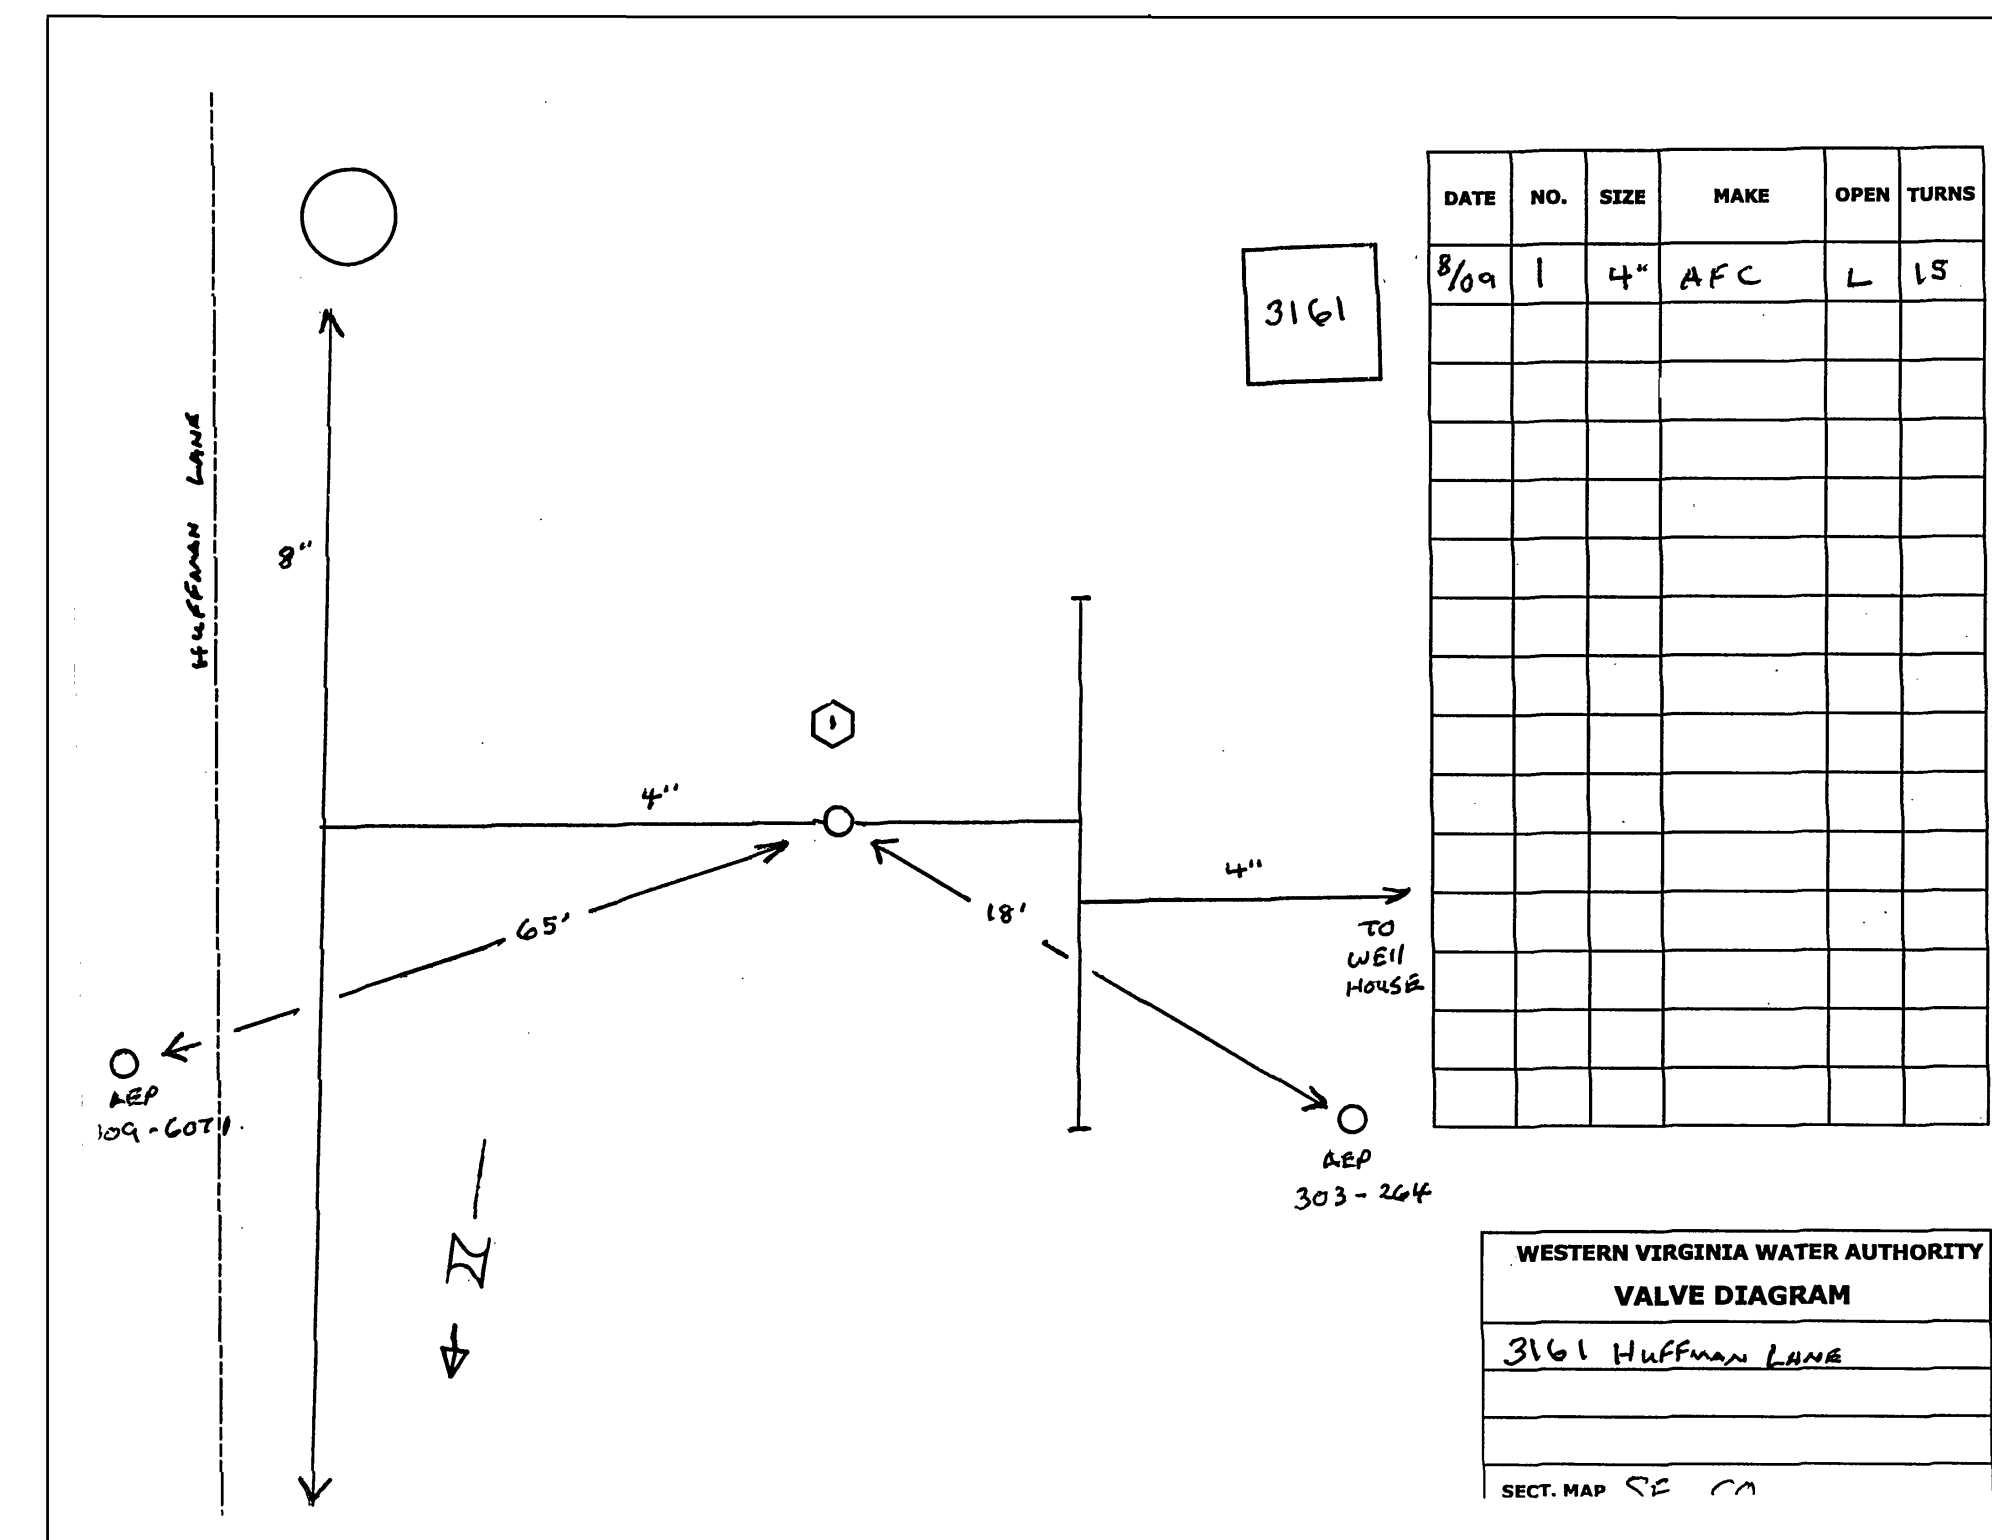


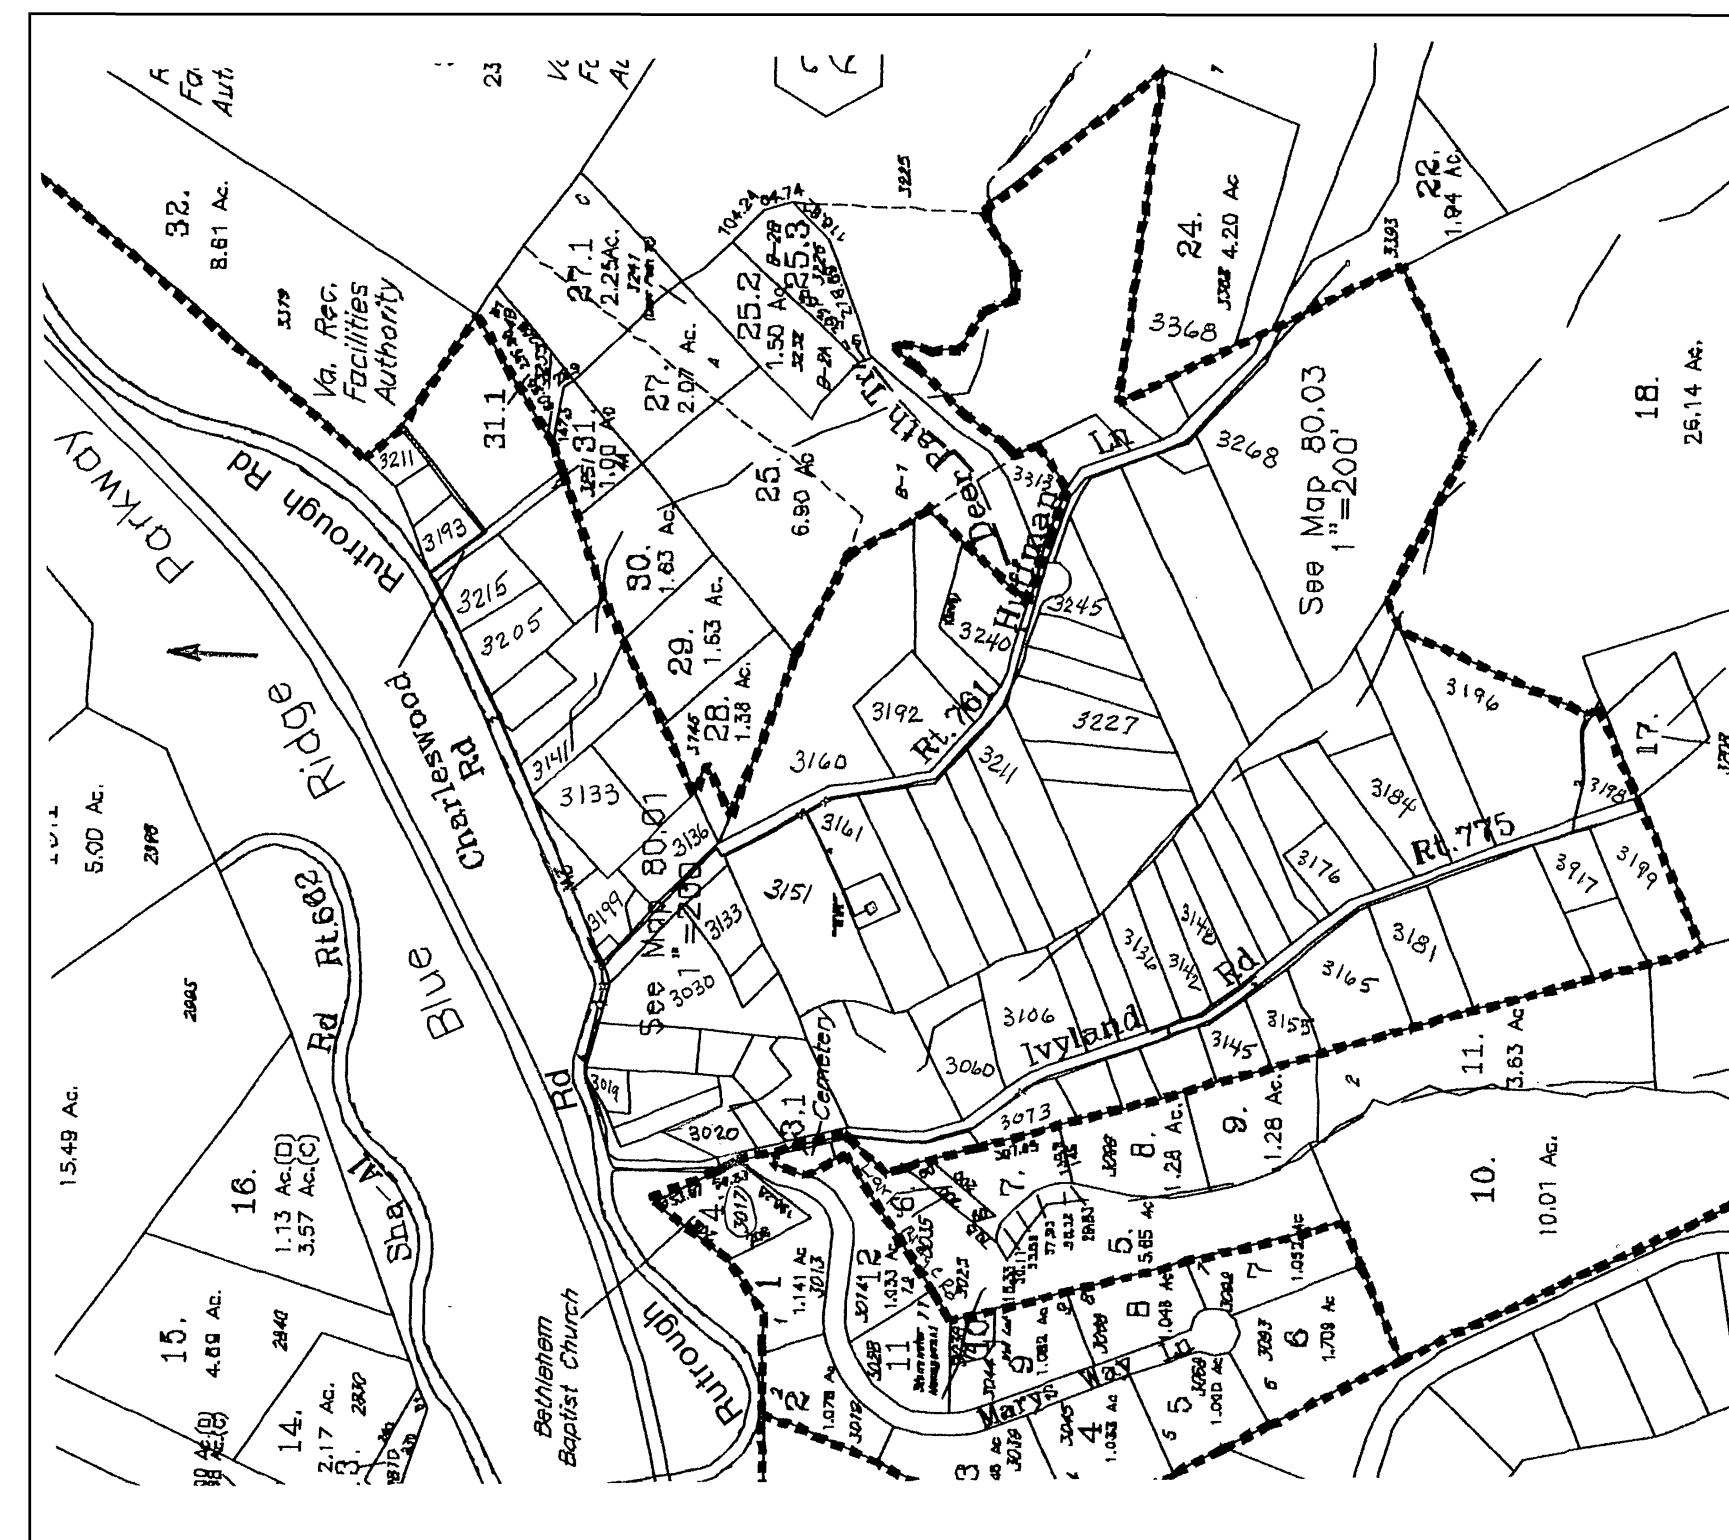

SEE PLAN SHEET 7 of 12	HUFFMAN LANE STA 10+00.00 TO STA 22+00.00
SEE PLAN SHEET 8 of 12	HUFFMAN LANE STA 22+00.00 TO STA 31+96.63

VALVE SHEETS

Delaney Court Waterline Replacement

**Western Virginia Water Authority
Roanoke County, Virginia**