
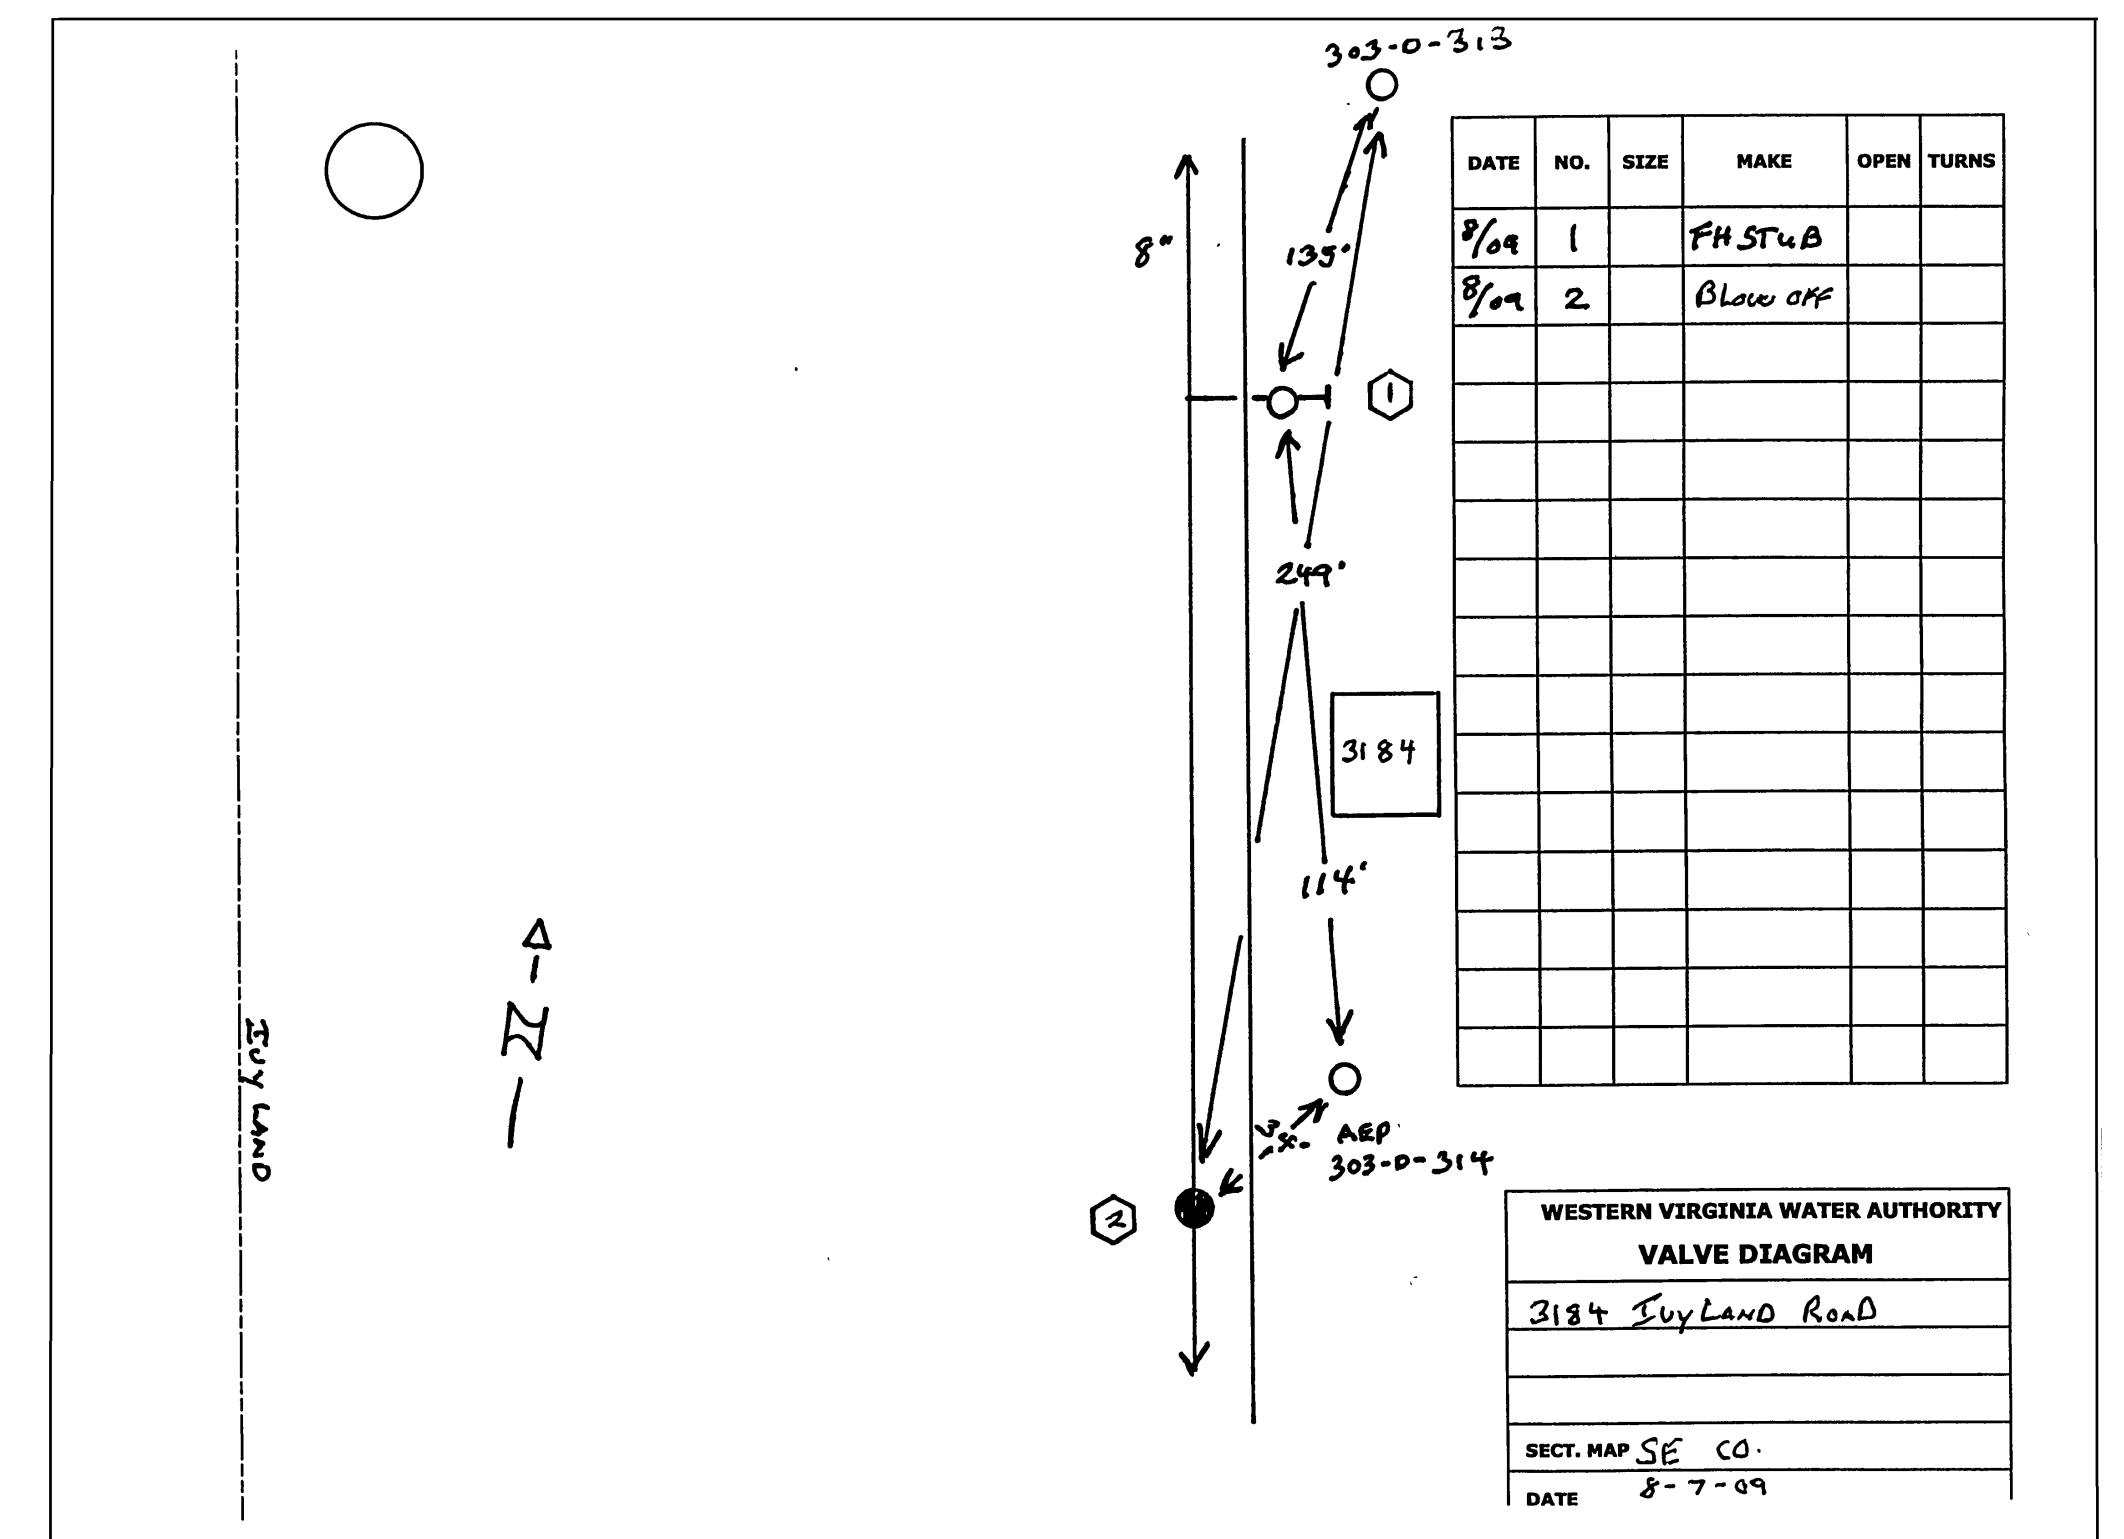
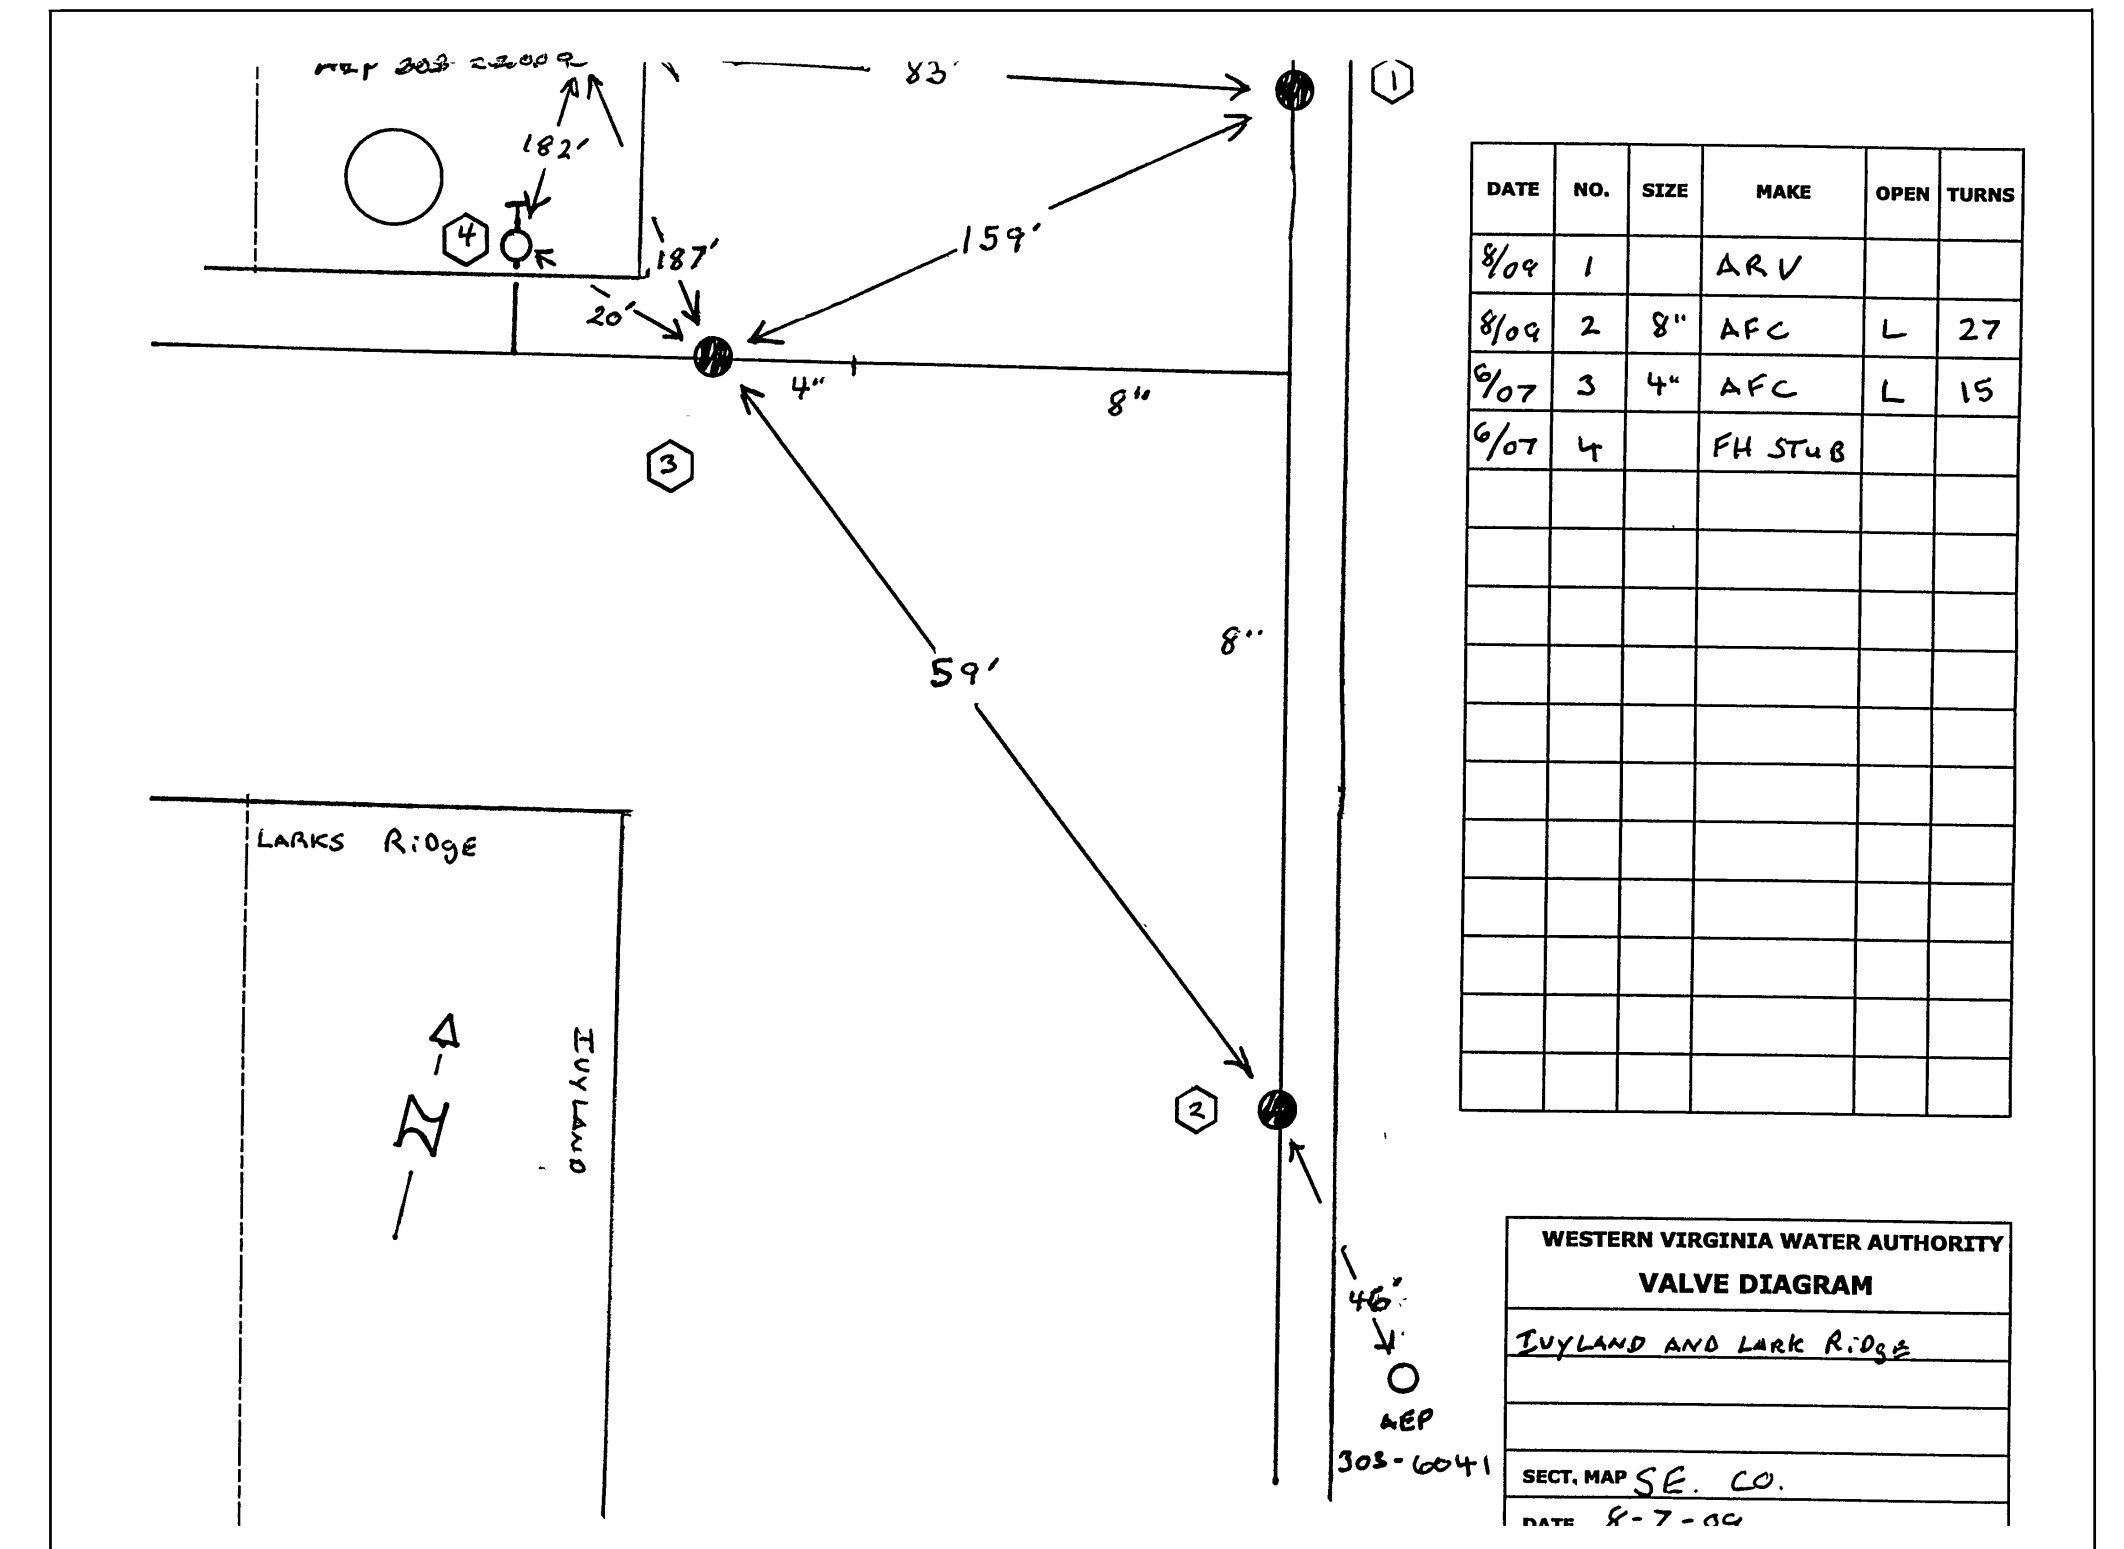
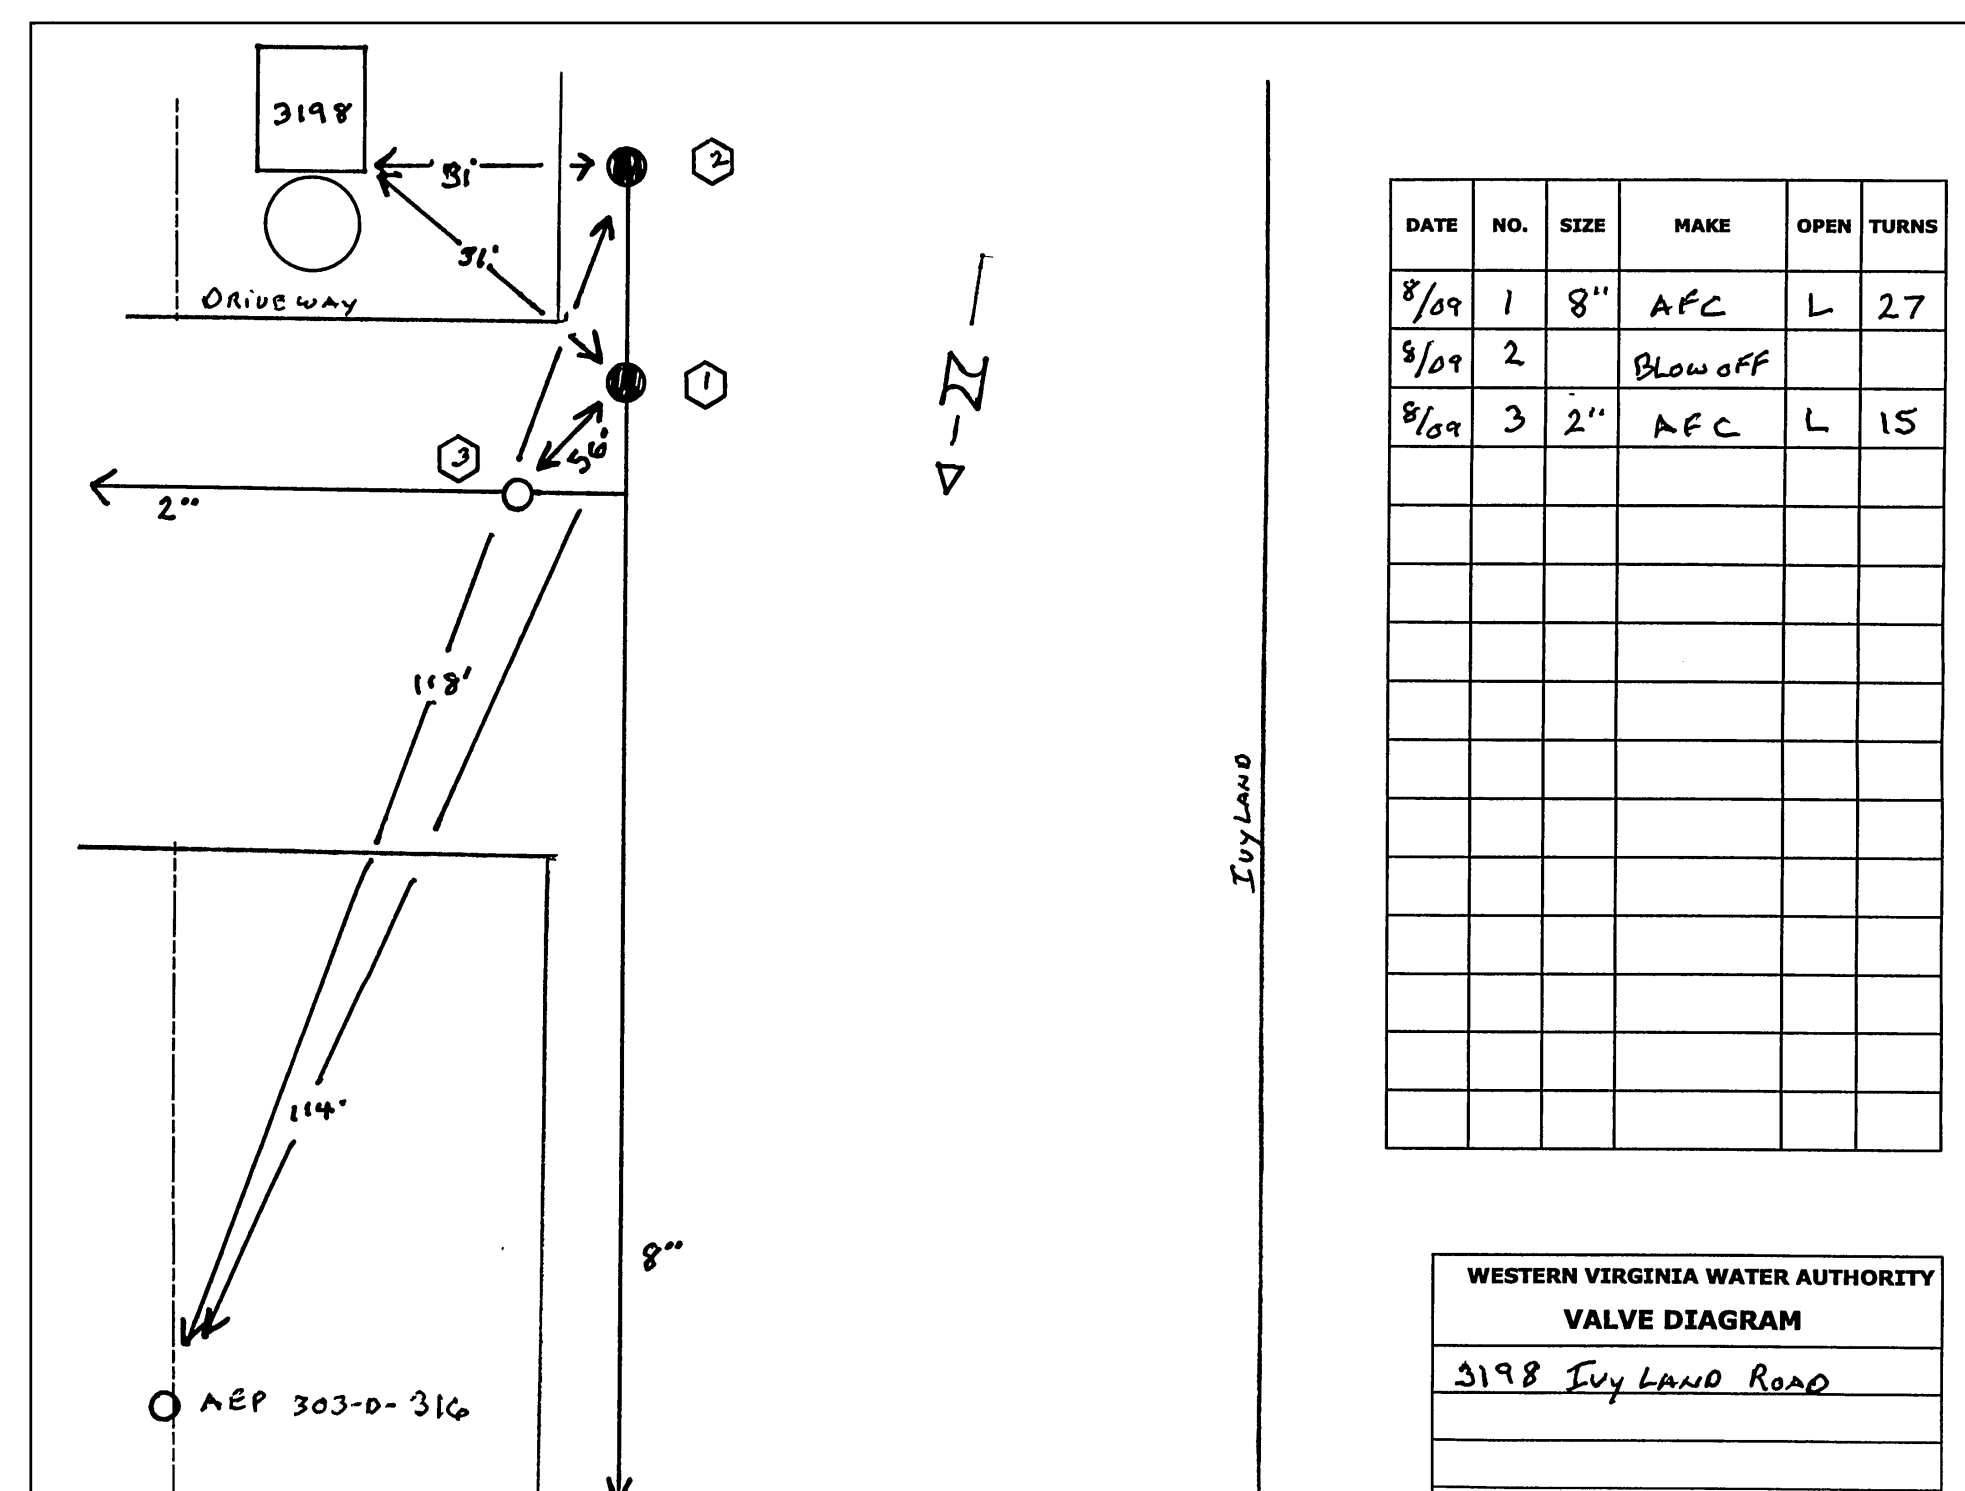
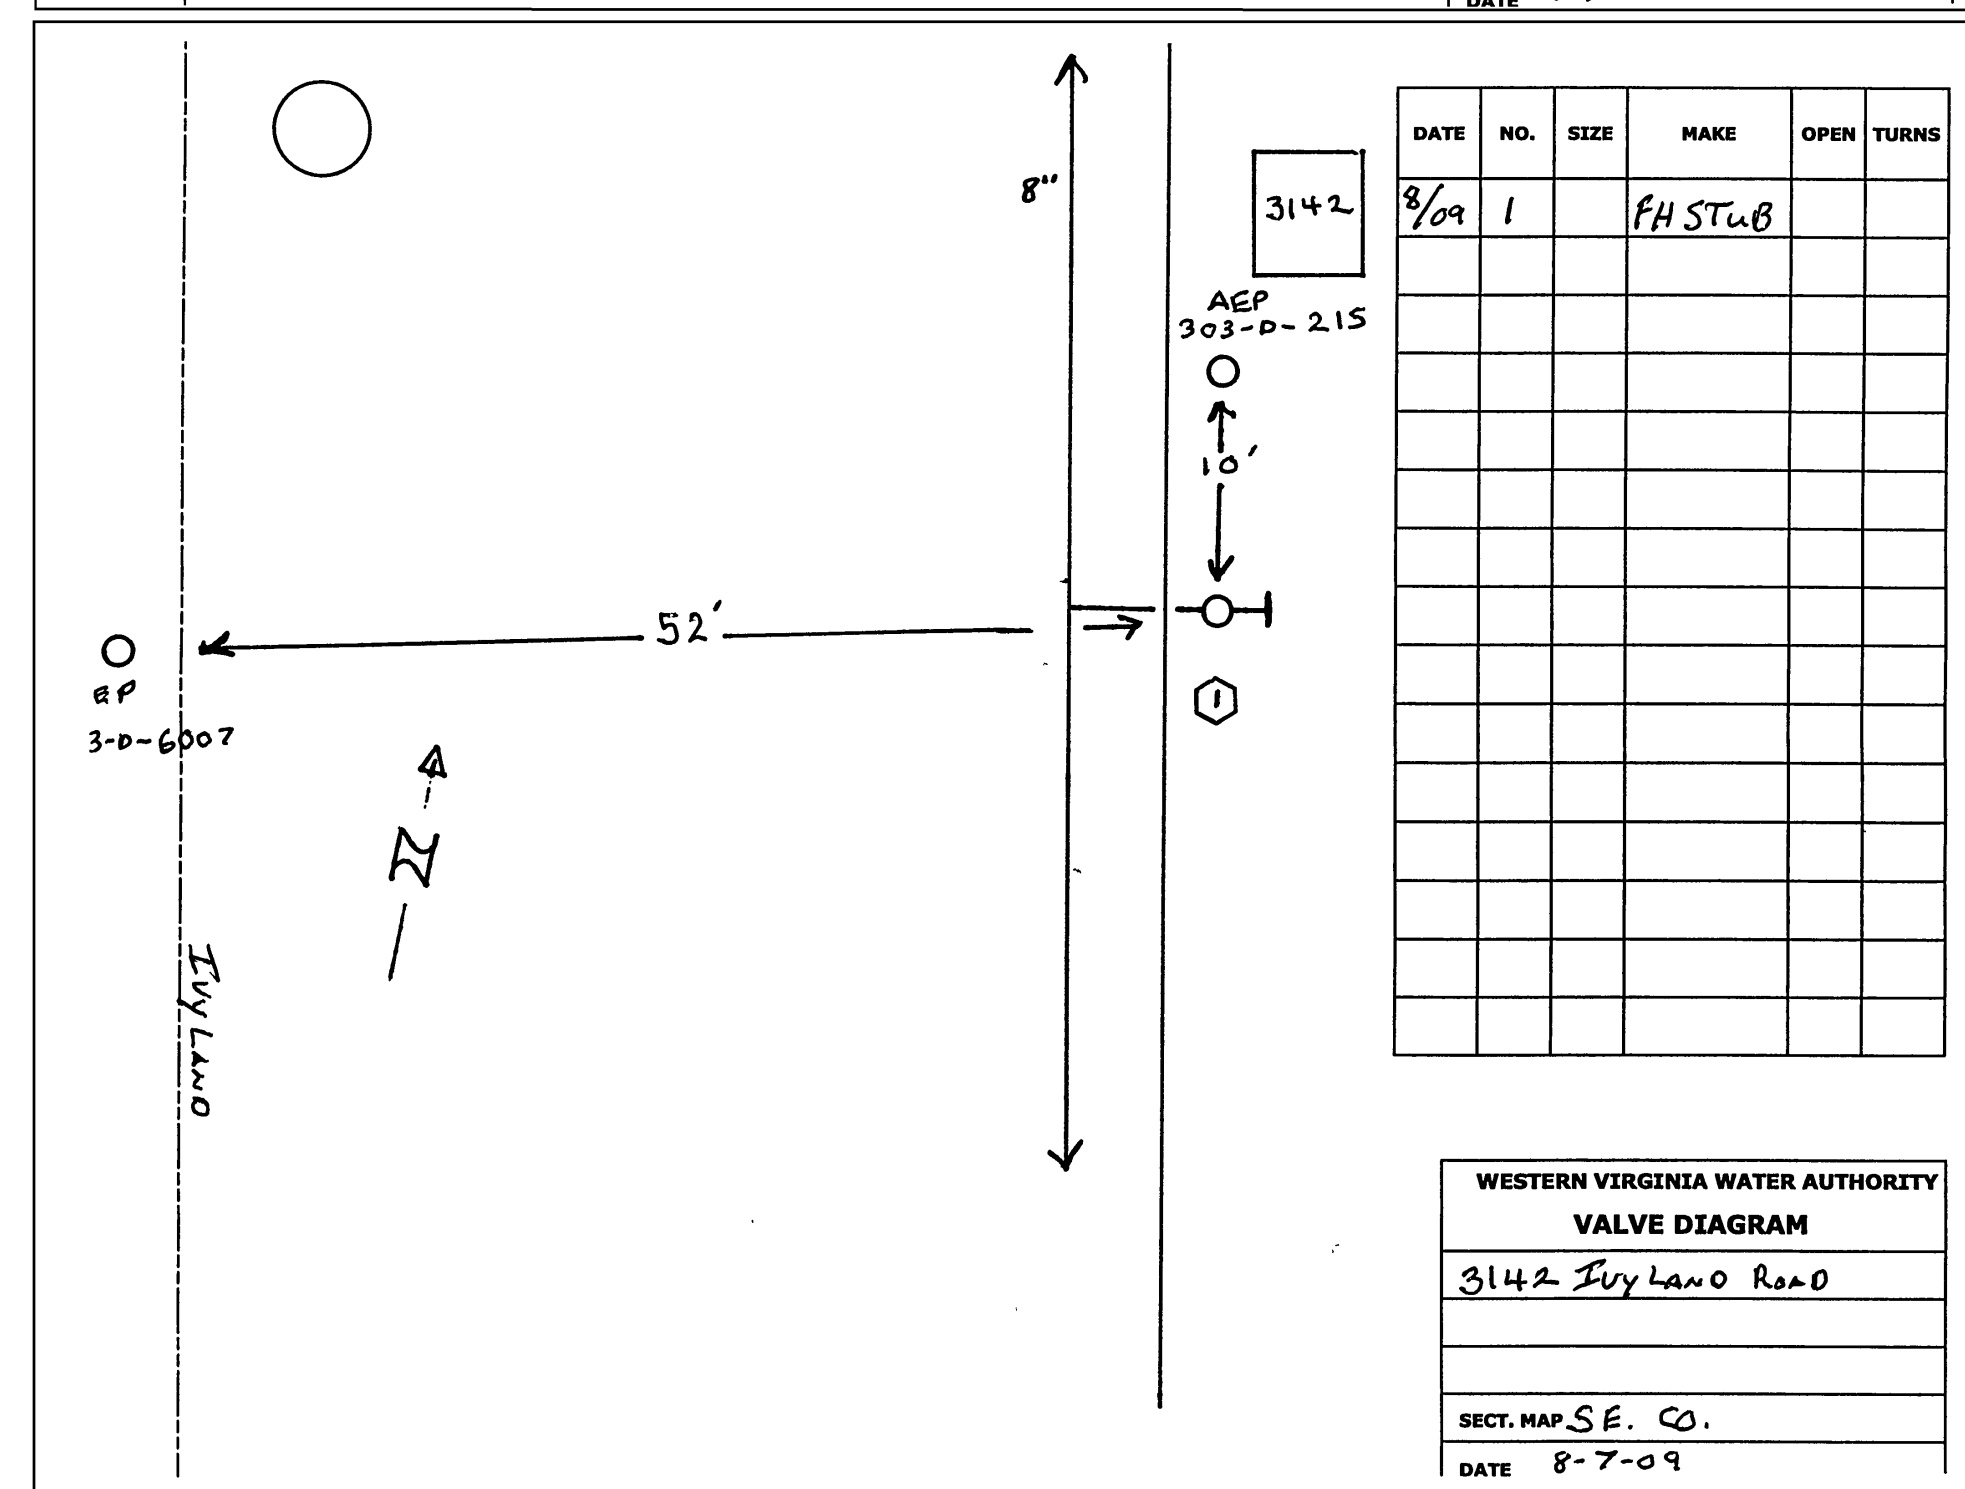
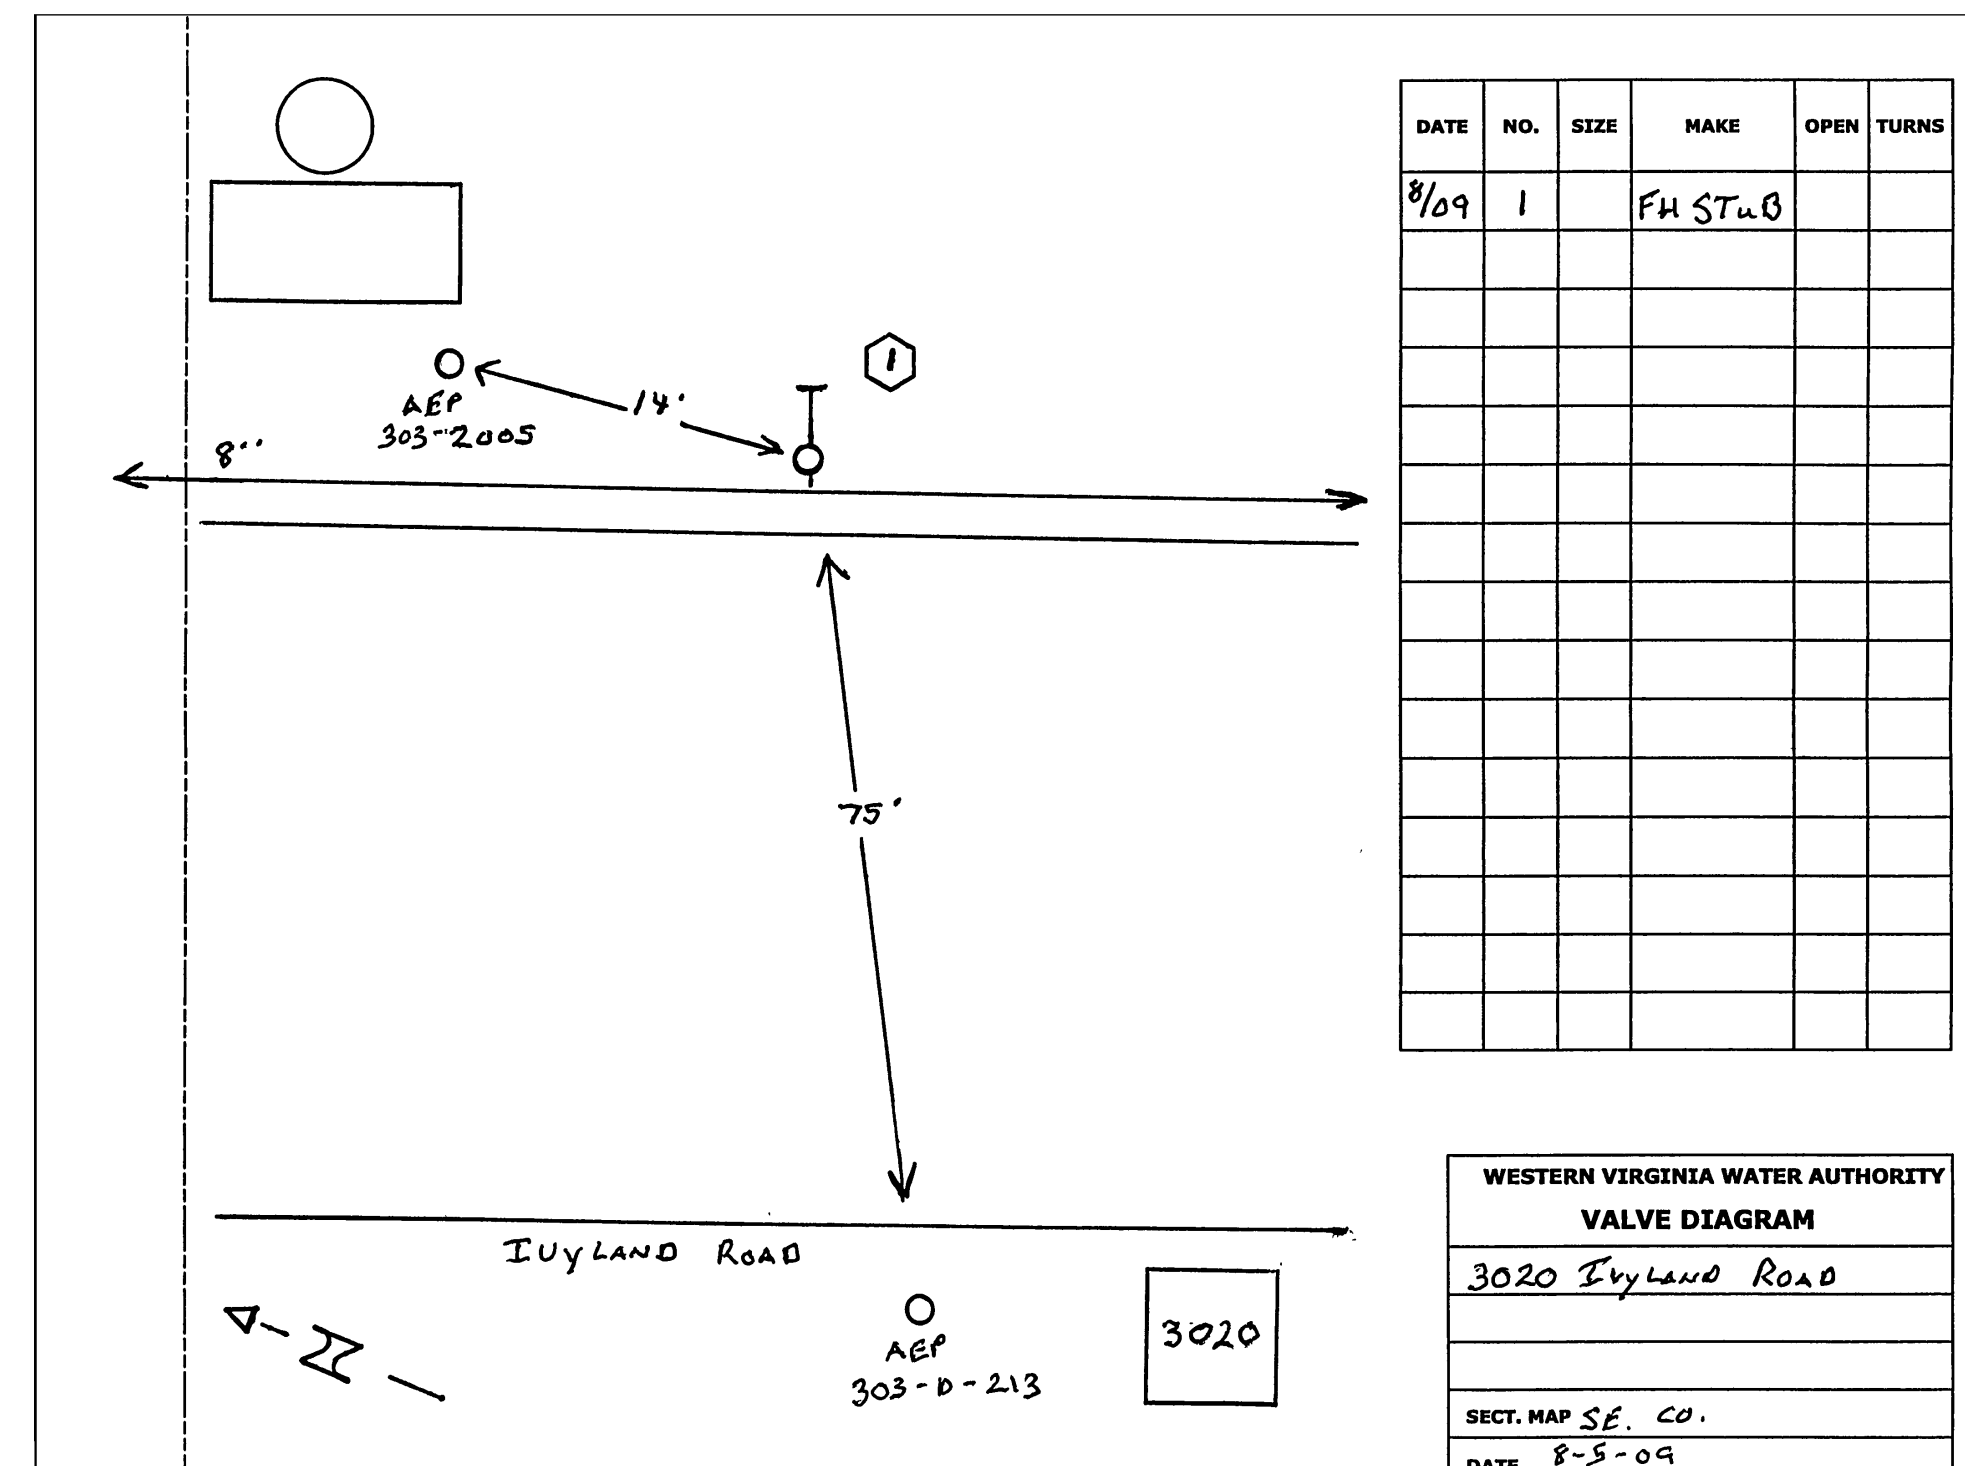
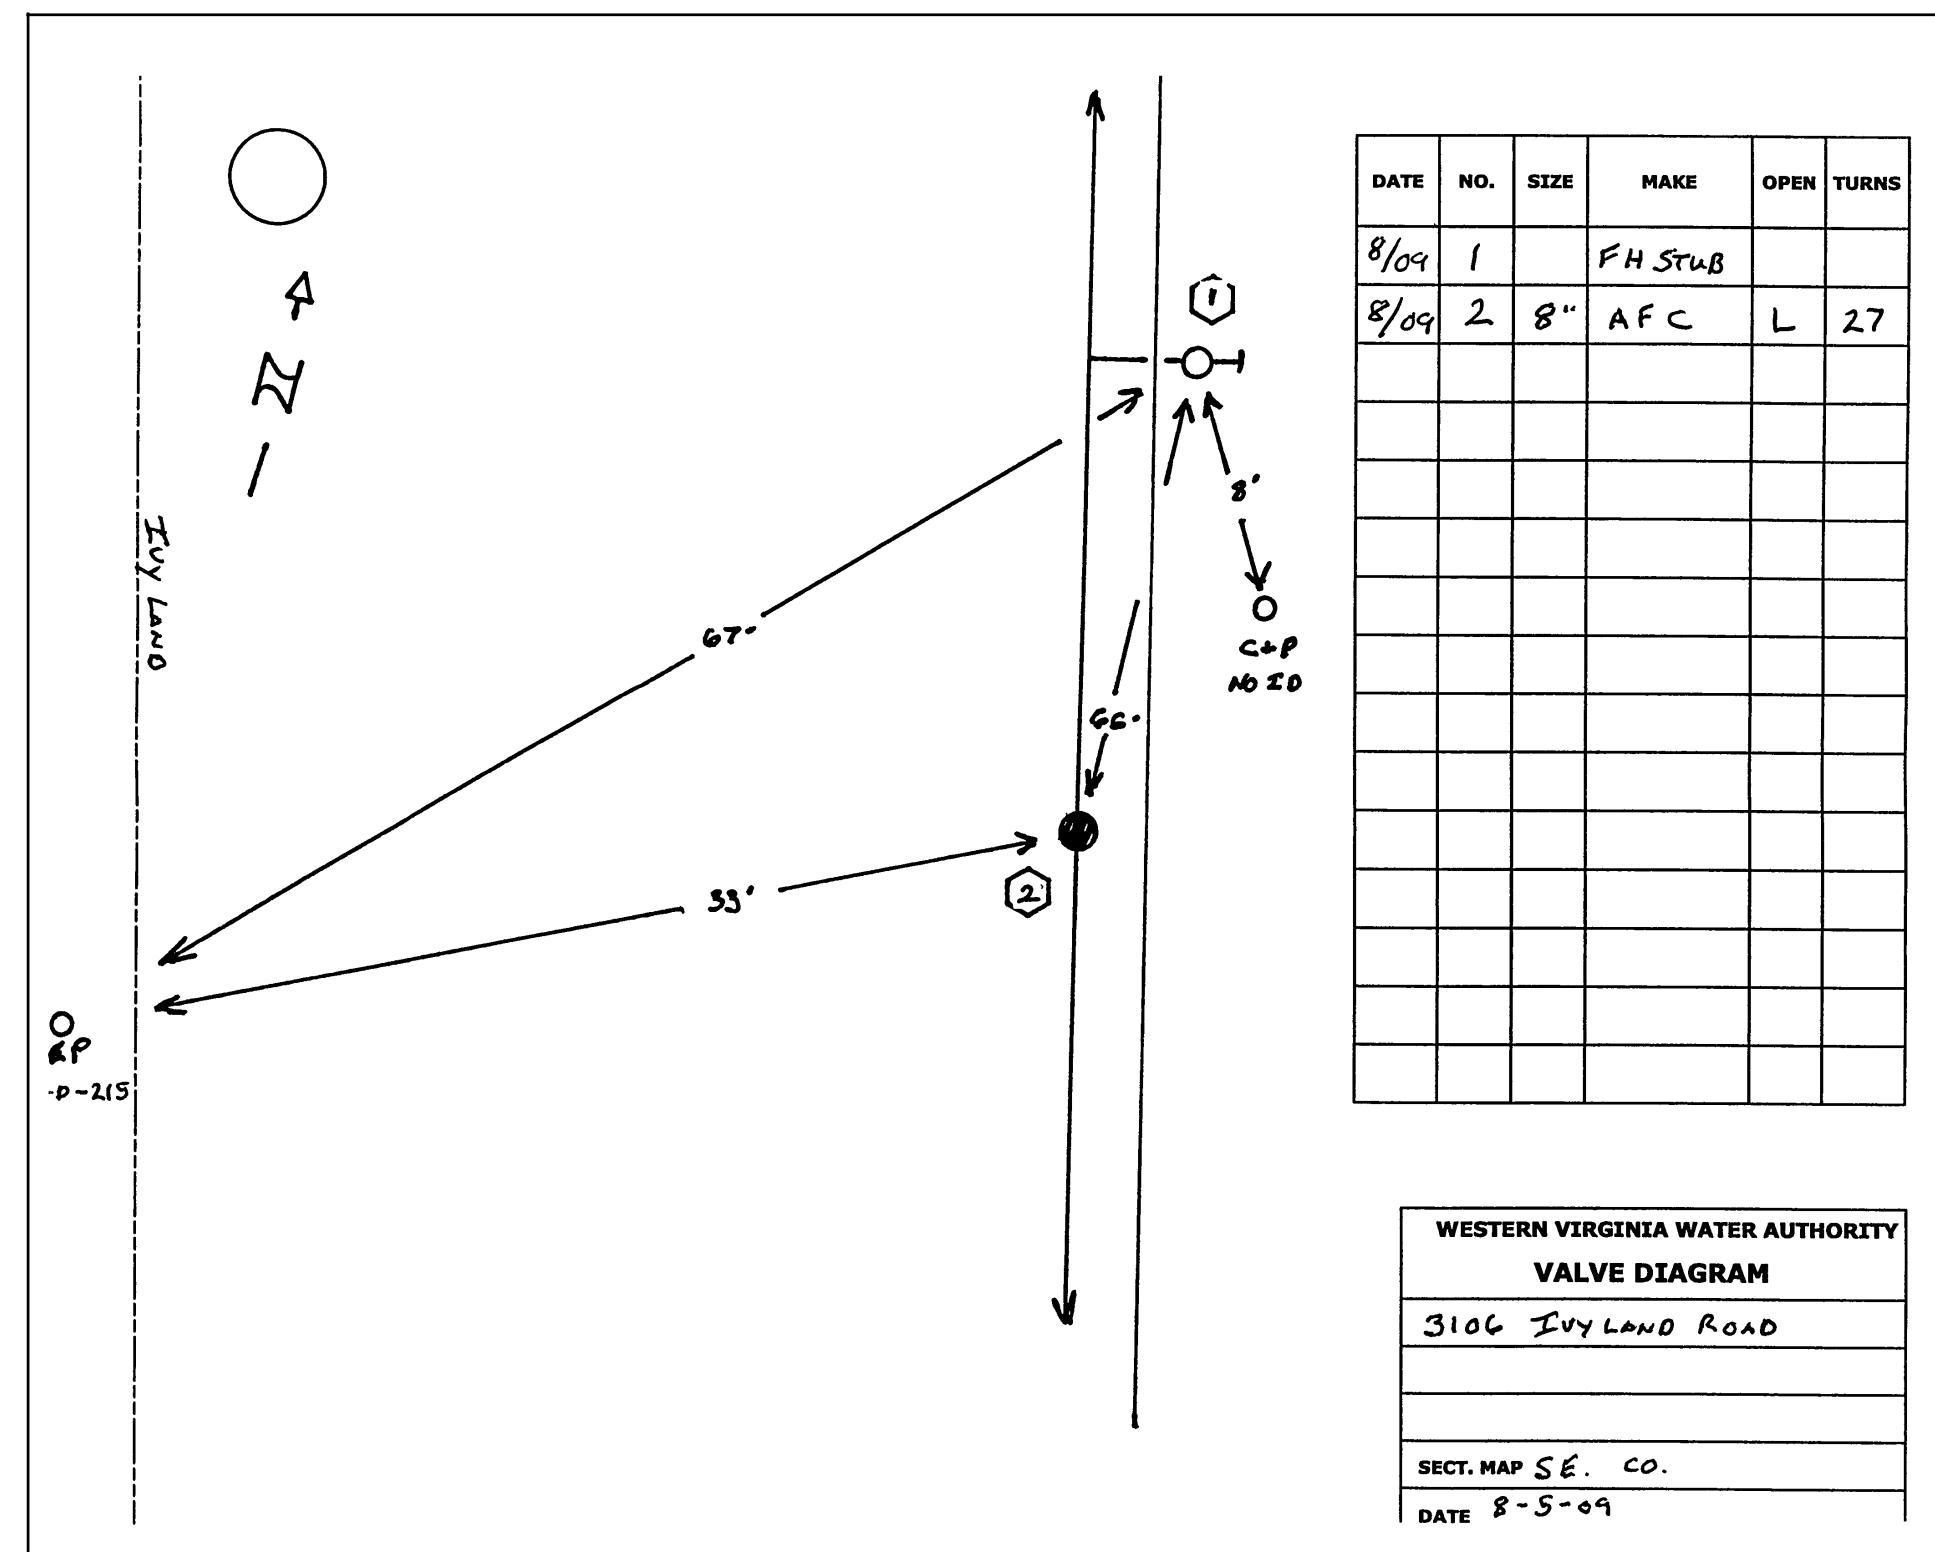


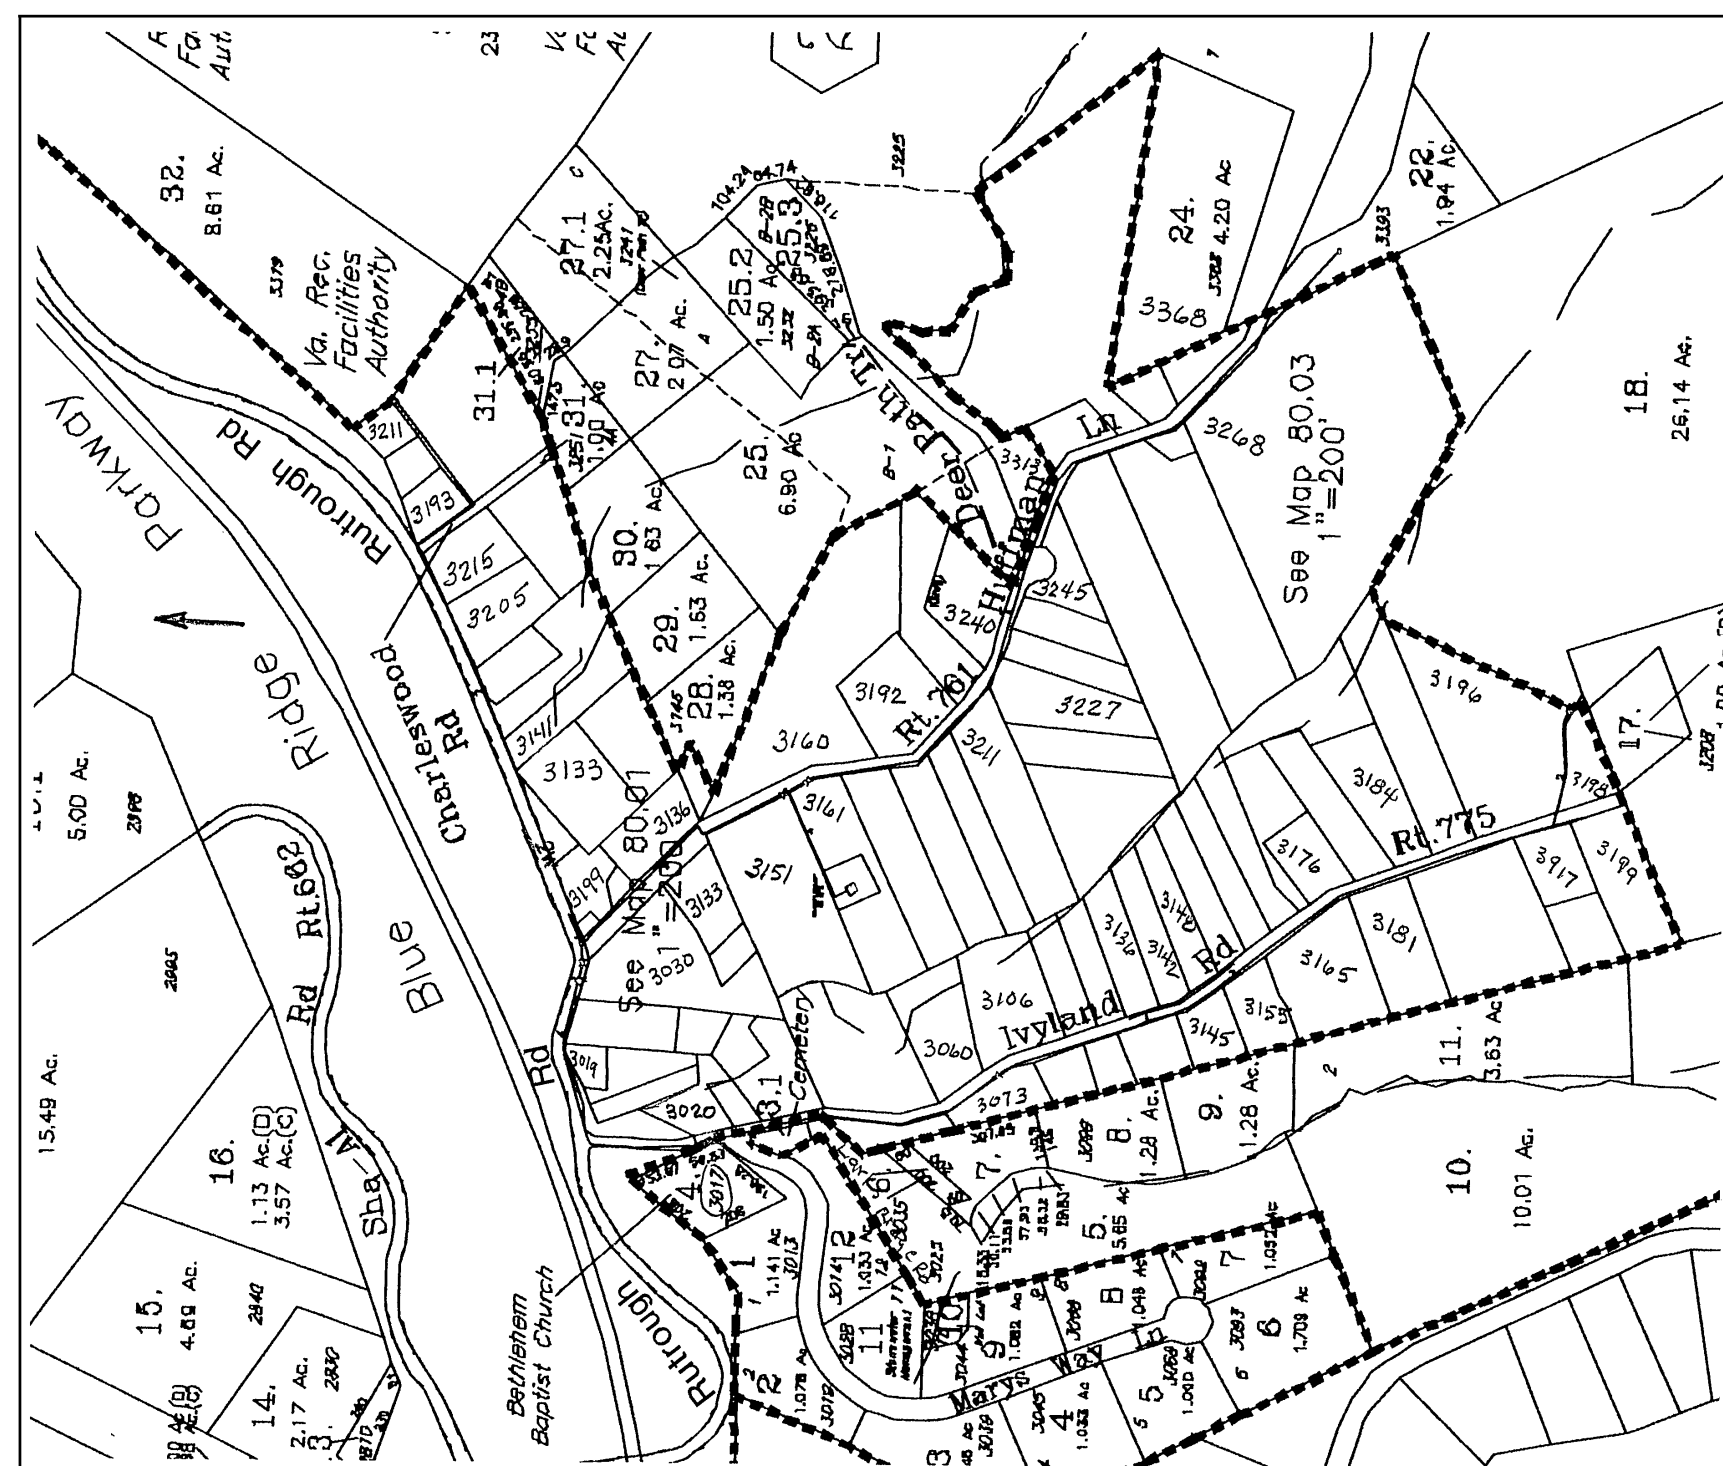

SEE PLAN SHEET 5 of 12 IVYLAND ROAD STA 10+00.00 TO STA 23+00.00
SEE PLAN SHEET 6 of 12 IVYLAND ROAD STA 23+00.00 TO STA 34+41.63

VALVE SHEETS

Delaney Court

Waterline Replacement

Western Virginia Water Authority
Roanoke County, Virginia