


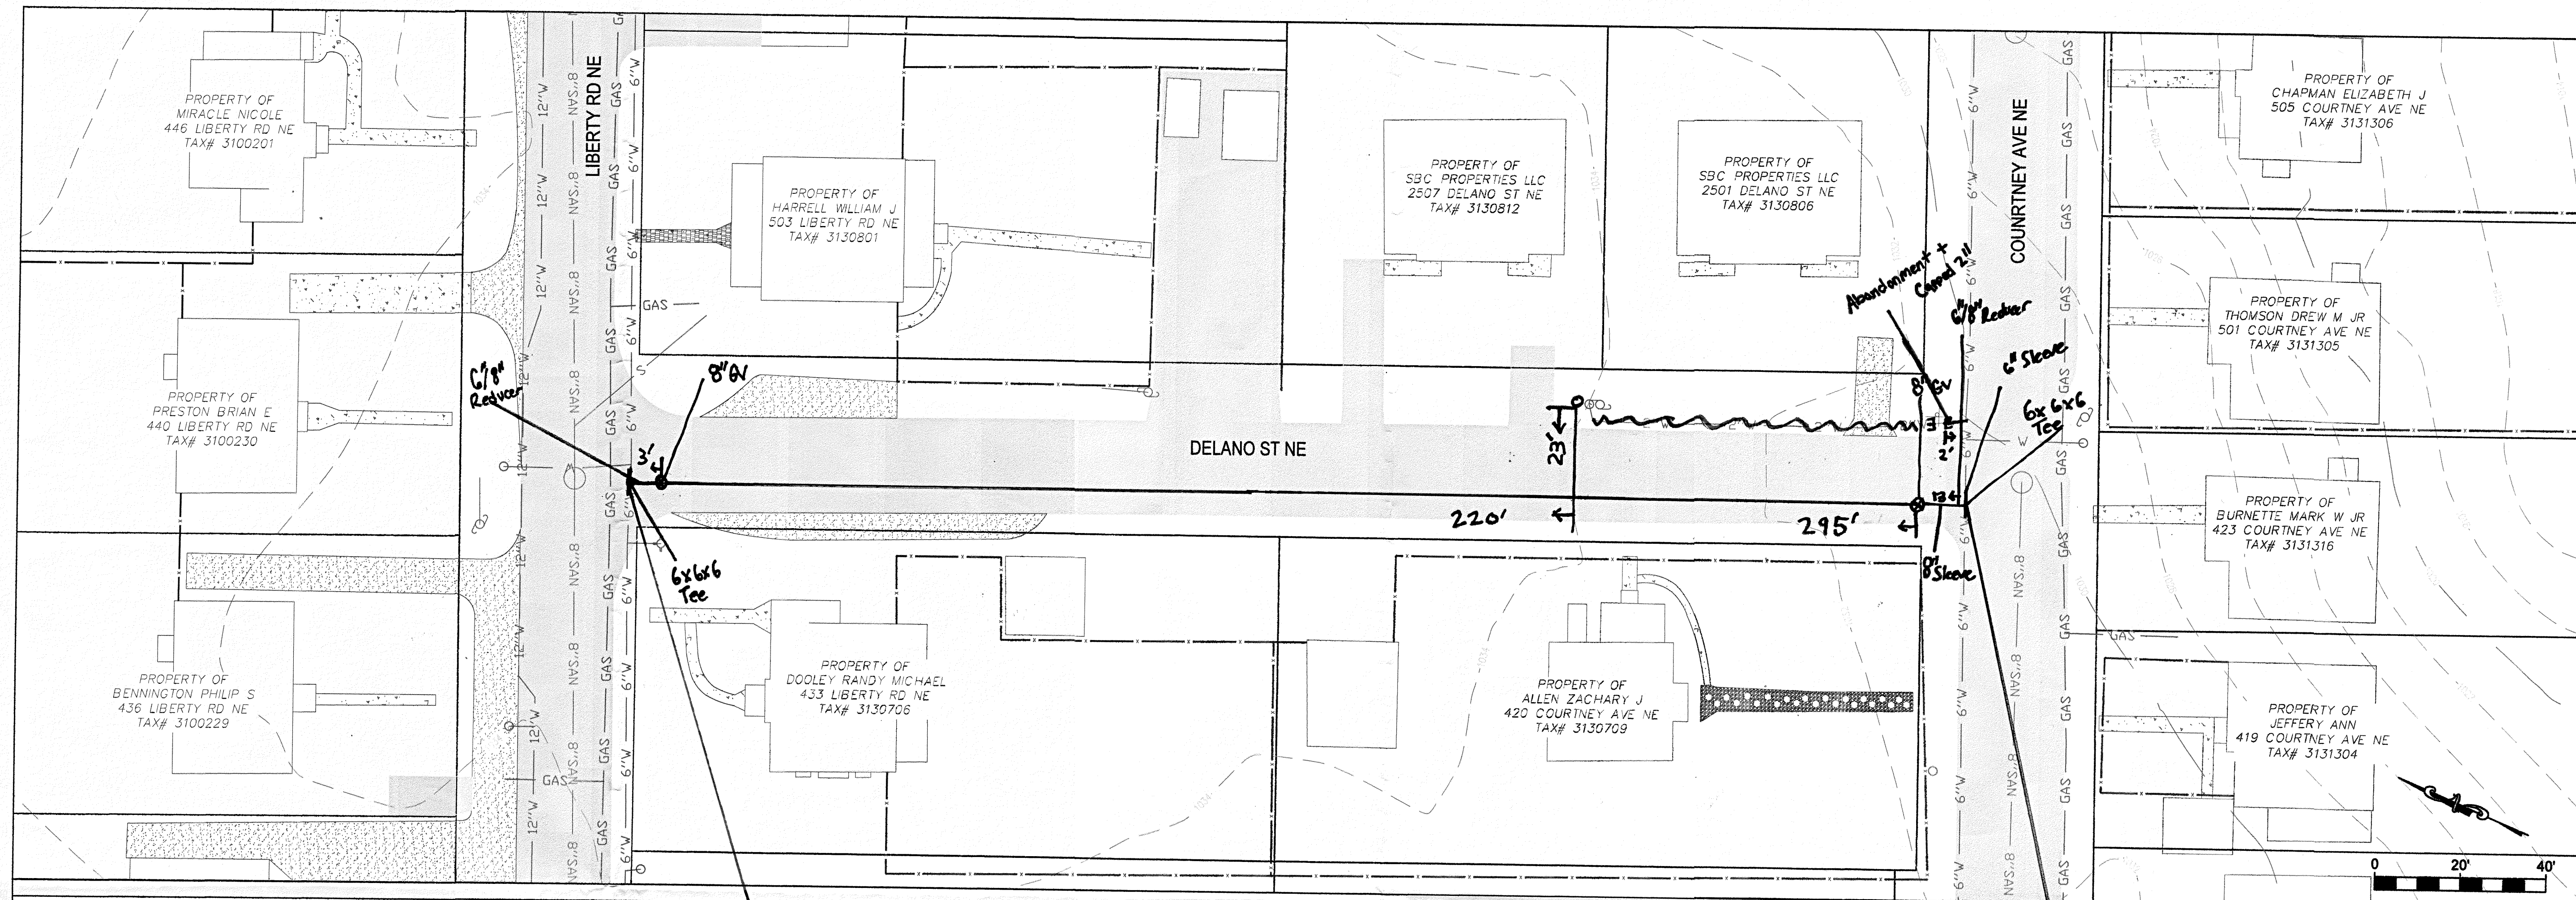


WESTERN VIRGINIA
WATER AUTHORITY
ENGINEERING SERVICES
601 S JEFFERSON ST, SUITE 300
ROANOKE, VA 24011
540-853-5700


DELANO ST NE WATERLINE REPLACEMENT

BASEMAP

Install Contractor	WVWA	
Construction Start Date	3/8/24	
Completion Date	3/29/24	
Water Main(s)		
Manufacturer	Griffin	
Diameter	8"	
Pipe Class	C151 Class 350	
Material	Ductile Iron (DIP)	
Comments	300'	
Water Service(s)		
Manufacturer	Endot	
Diameter	1"	
Pipe Class	C151 Class 250	
Material	Poly Vinyl Chloride	
Comments	25'	
Water Valve(s) 1		Water Valve(s) 2
Manufacturer	American Valve	
Valve Type	Gate	
Diameter	8"	
Direction to Open / Turns to Close	Right to Close	
Comments	Placed 2 valves	
Water Valve(s) 3		Water Valve(s) 4
Manufacturer		
Valve Type		
Diameter		
Direction to Close / Turns to Close		
Comments		
Hydrant(s)		
Authority ID #		
Manufacturer		
Model		
Cast Date		
Static Pressure		
Comments		

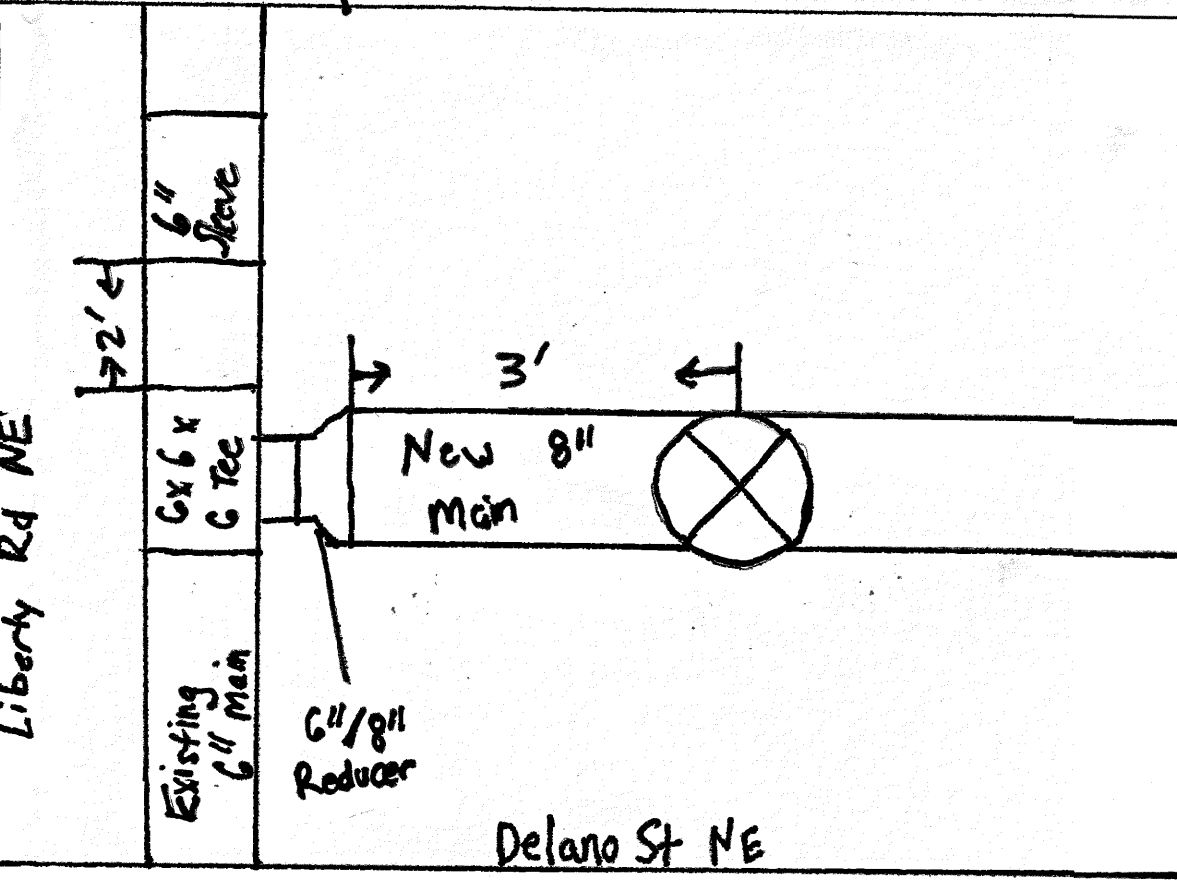

- GENERAL NOTES:**
- SEWER LATERALS SHOWN ARE BASED ON CURRENT MAPPING. ADDITIONAL LATERALS & CONFLICTS SHALL BE INVESTIGATED PRIOR TO EXCAVATION.
 - PROPERTY LINES SHOWN ON THIS PAGE ARE BASED ON GIS DATA AND HAVE NOT BEEN FIELD SURVEYED.

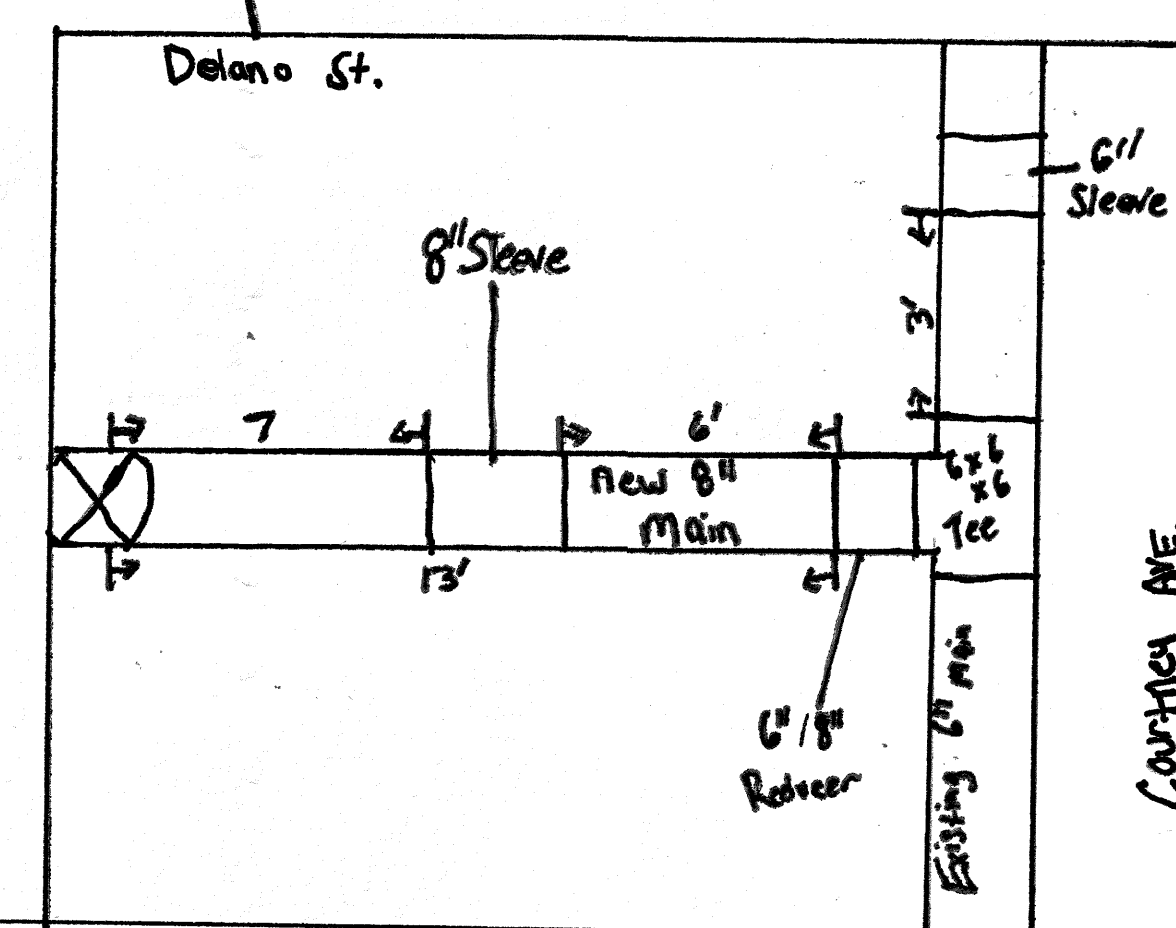

Rev	Description	Date	By
1	As build - Michael Christy	7-2-24	MRC
Design: WVWA			
Drawn: NSS			
Checked: MRC			
Approved:			
Date: FEB 2024			
Project: WCIP-446			
1			
Sheet 1 of 1			