
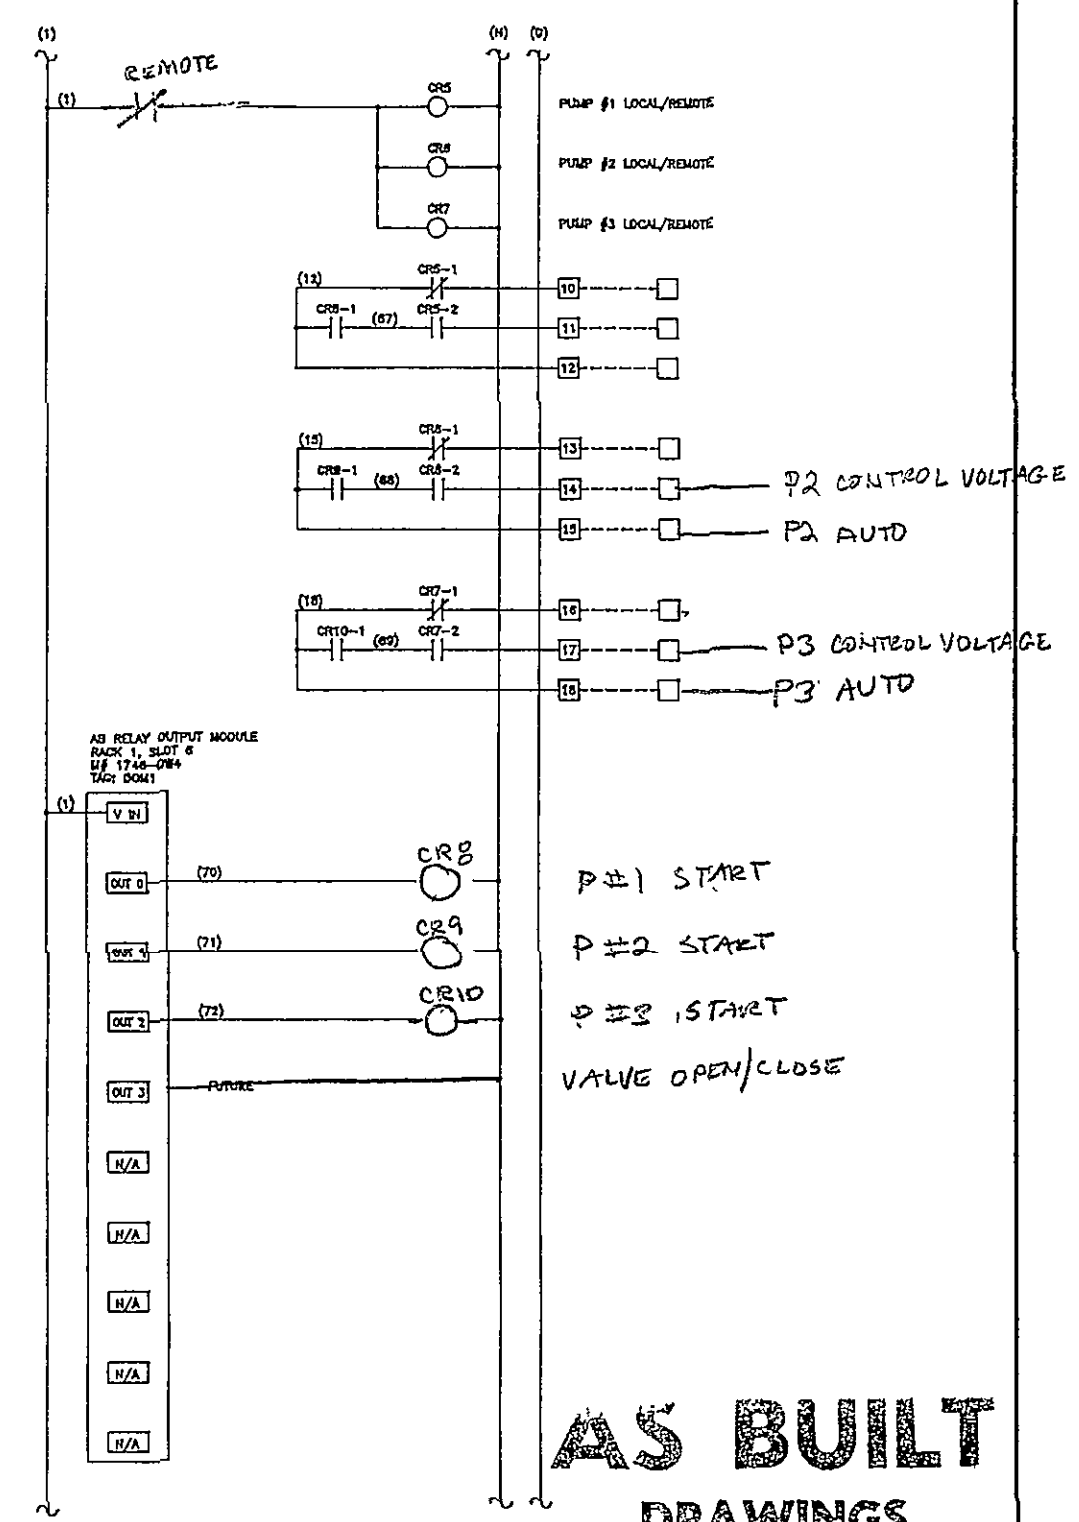
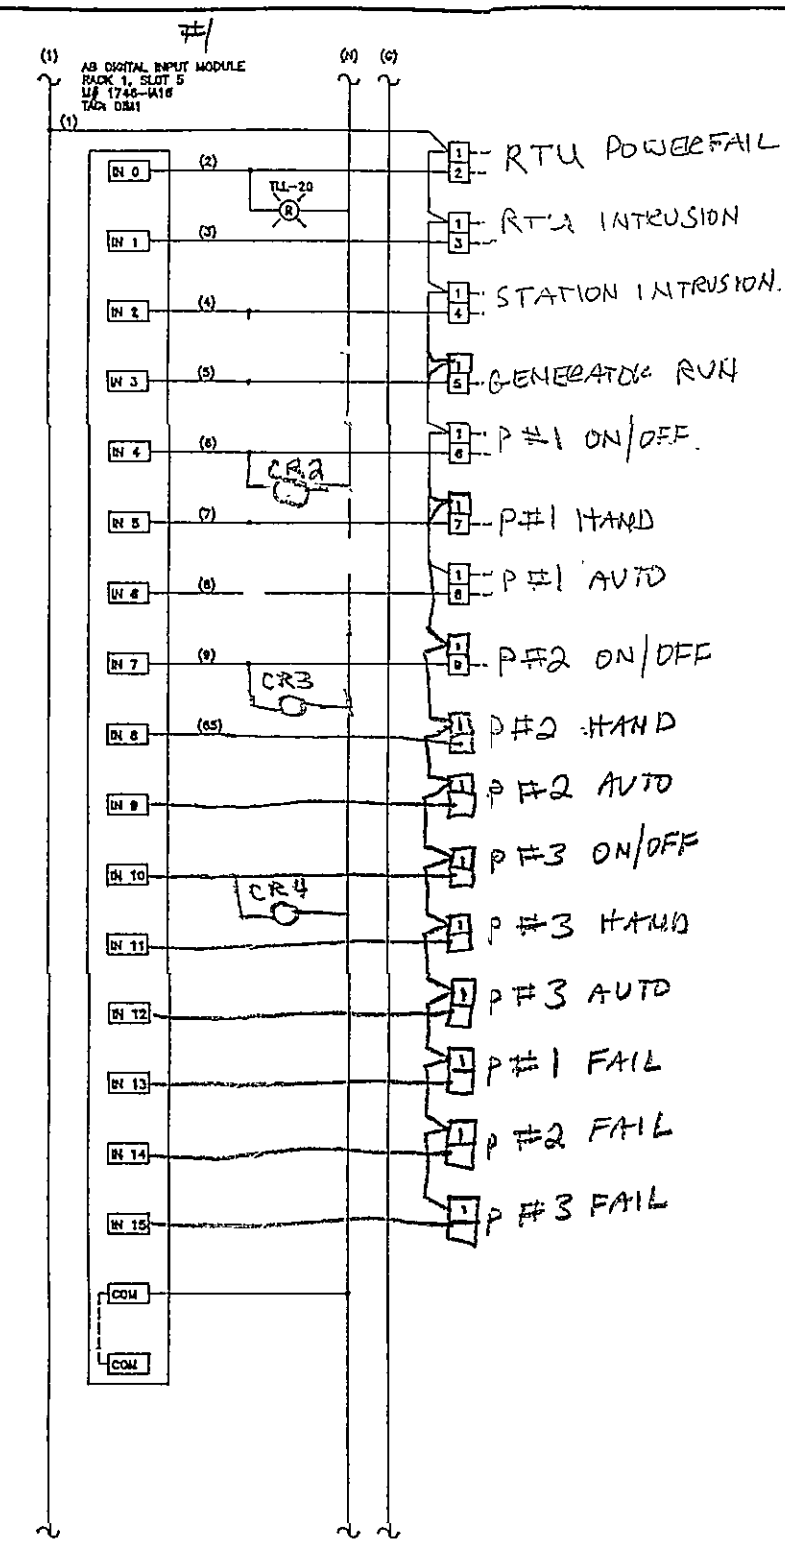


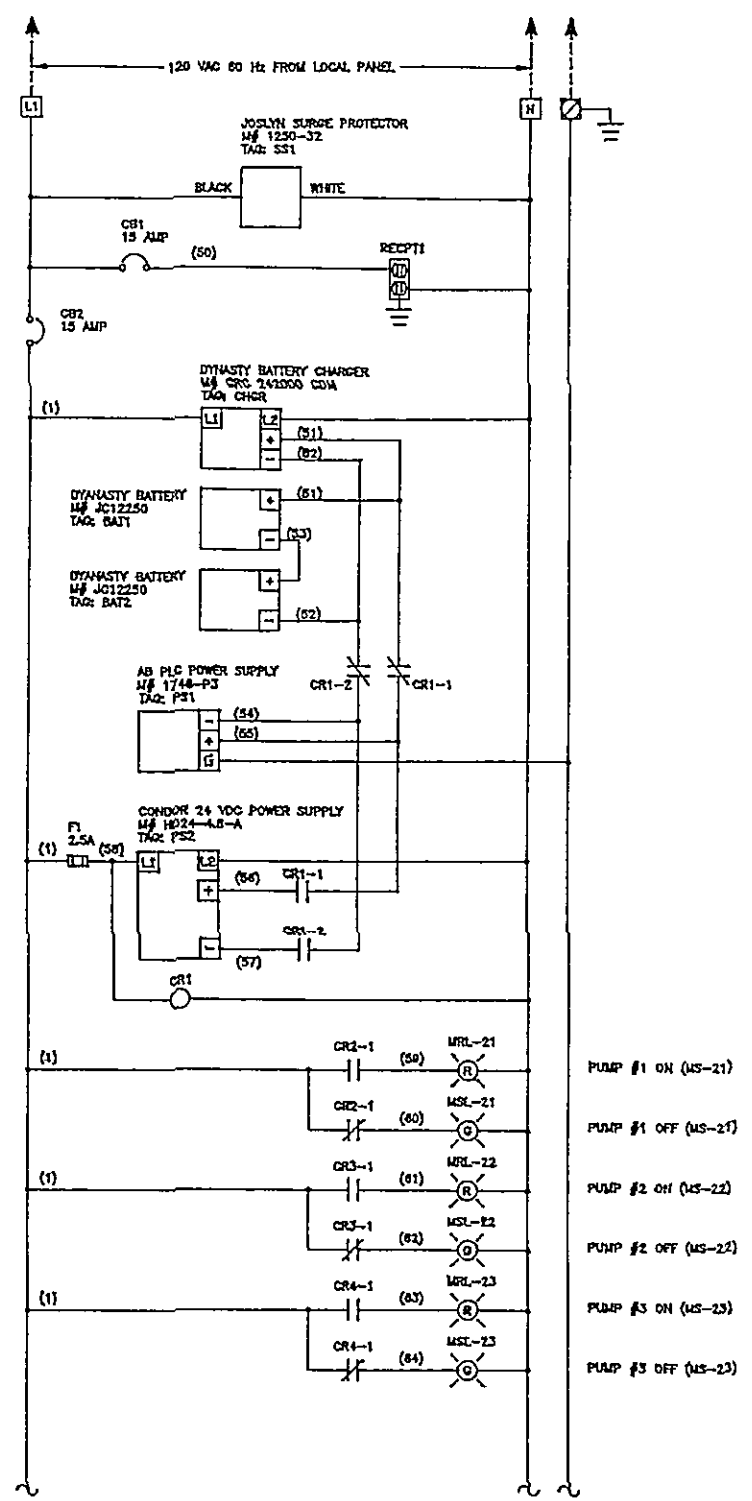

AS BUILT
DRAWINGS

REVISION NOTES
1) REVISED PER MEETING OF 1/28/94.

4828 DELRAY ST., NW
Delray Pump Station

CITY OF ROANOKE, VA - CARVINS COVE PH 1			
RTU & WIRING DIAGRAM			
REVISION	DATE	BY	REASON
1	2/7/94	RJW	REVISED PER MEETING OF 1/28/94
2	4/28/93	RJW	REVISED PER MEETING OF 1/28/94
3	5-24-93	SE	REVISED PER MEETING OF 1/28/94
4	4/28/93	RJW	REVISED PER MEETING OF 1/28/94
5	4/28/93	RJW	REVISED PER MEETING OF 1/28/94
6	4/28/93	RJW	REVISED PER MEETING OF 1/28/94

WWWA ID# 6QQG3J

D461-60