
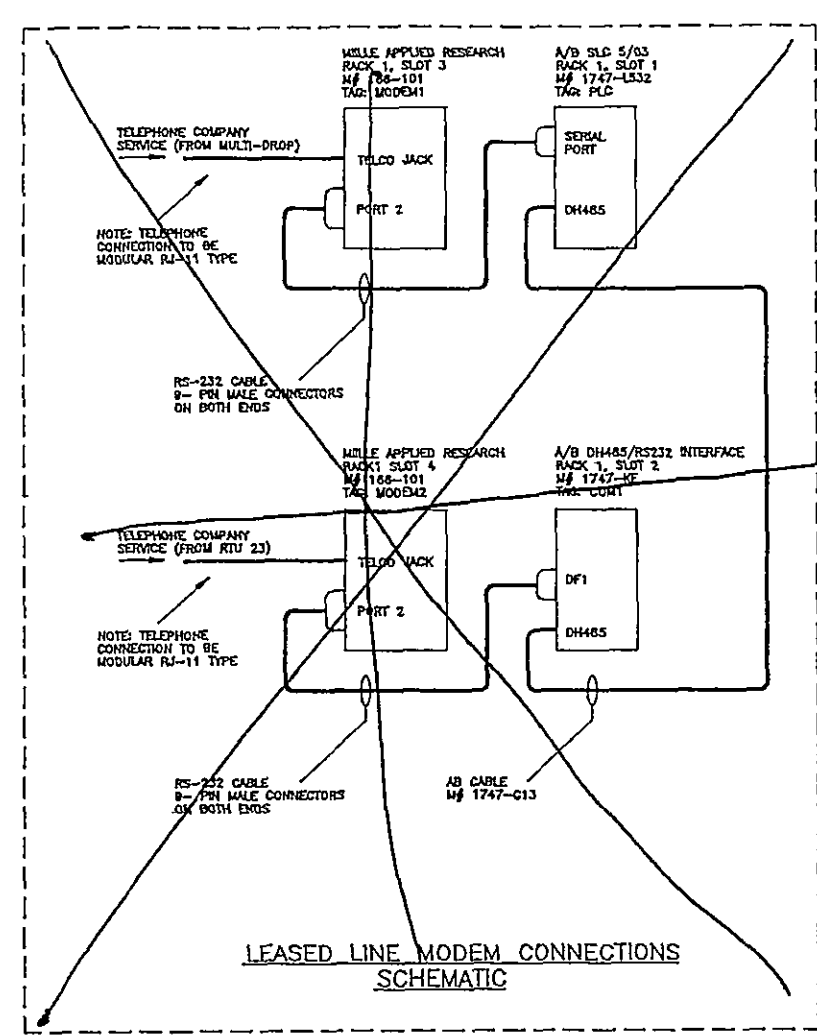
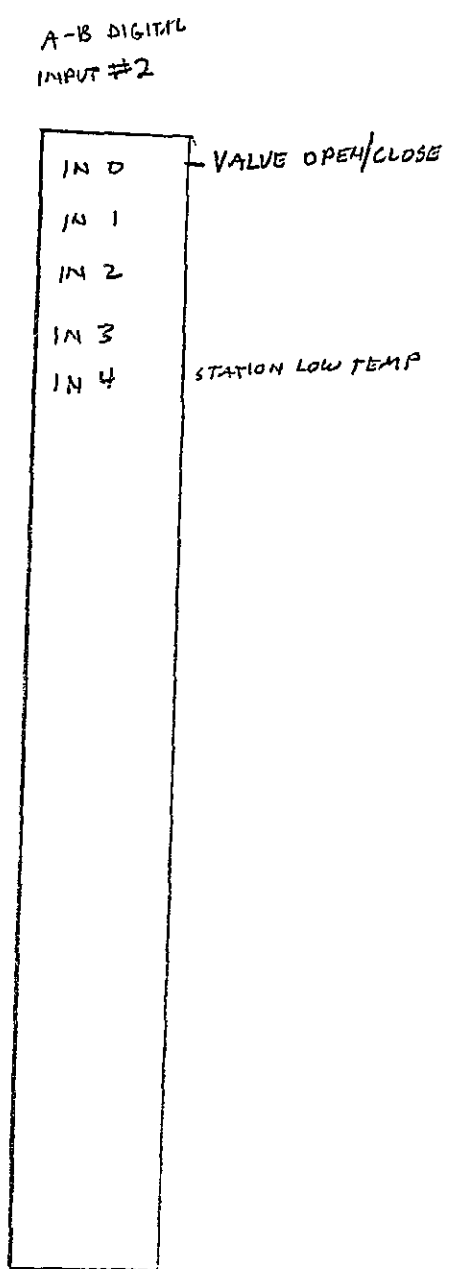


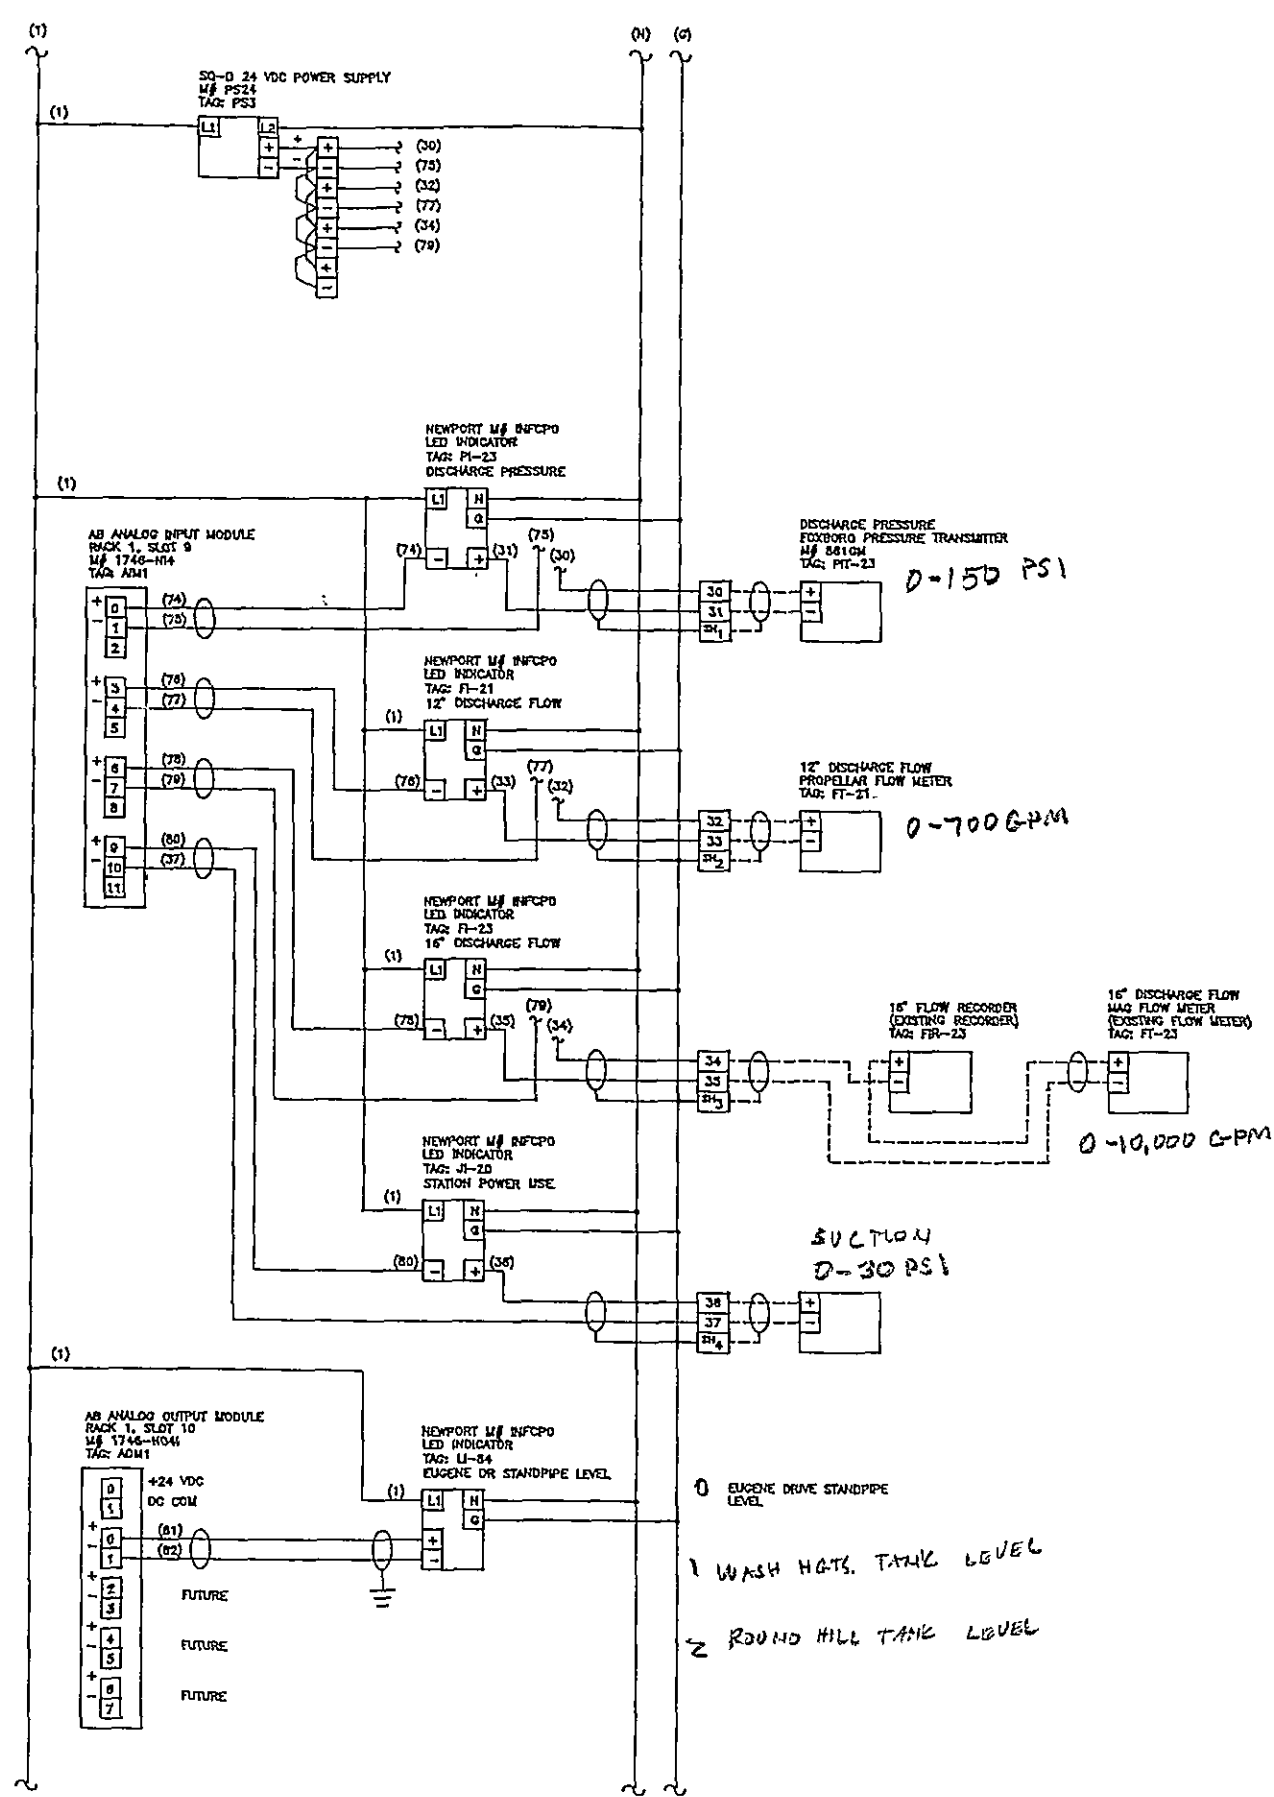

AS BUILT DRAWINGS

REVISION NOTES

1) REVISED PER SUBMITTAL COMMENTS.

4828 DELRAY ST., NW
Delray Pump Station
CITY OF ROANOKE, VA. - CARVINS COVE PH 1
RTU 8 WIRING DIAGRAM

NO.	DATE	BY	REVISION
1	2/7/94	RWW	REVISED PER SUBMITTAL COMMENTS
2	5-21-94	RWW	REVISED PER SUBMITTAL COMMENTS

DESIGNED BY	CHECKED BY	DATE	SCALE	PROJECT
RWW	RWS	4/25/1993		0461-61

WVWA ID# 6QQG3J