
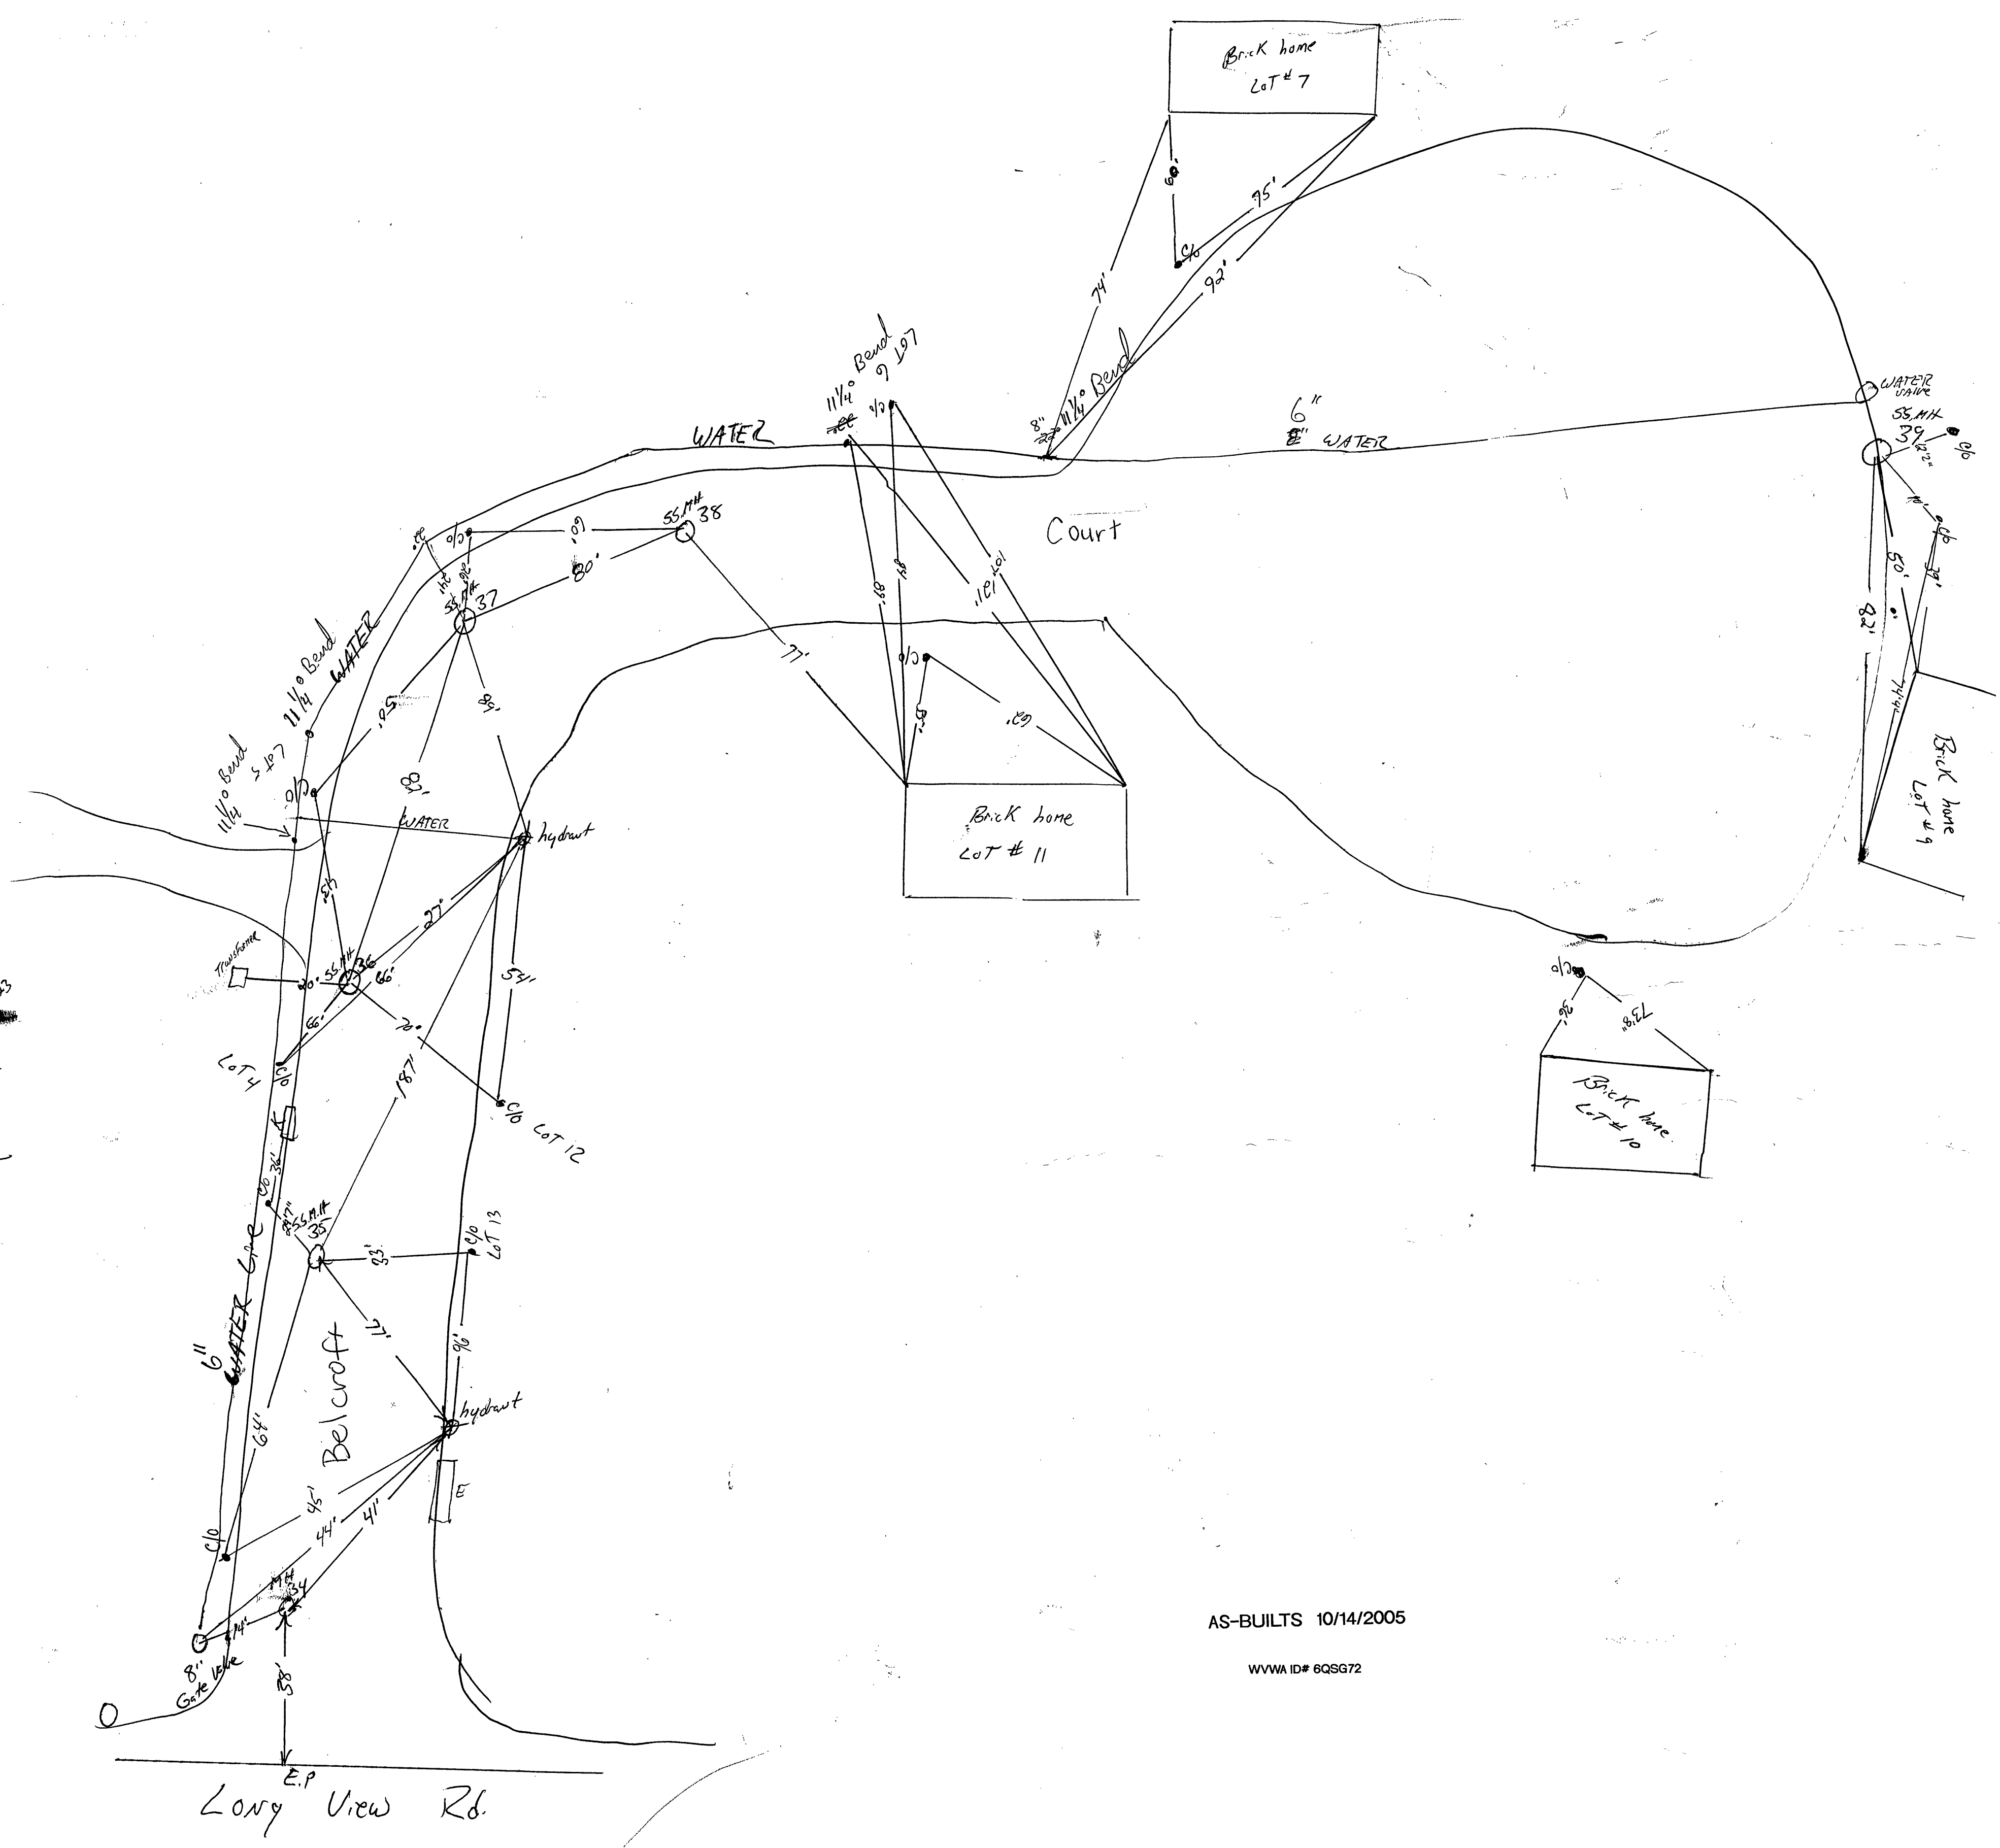


Name changed to
Devoncraft - Section 1
"Stone Manor" Section 3

Lot #	Sanitary Sewer	7-1-05
1	44' off M.H. 34 over 19' left	10'
2	27' off M.H. 35 over 11' left	10'
3	129' off M.H. 35 over 10' left	10'
4	37' off M.H. 36 over 16.5' left	9'
5	22' off M.H. 37 over 14.5' left	9'
6	22.5' off M.H. 38 over 16.5' left	8'
7	122' off M.H. 38 over 27' left	9'
8	11' off M.H. 39 @ 10.00	10'
9	11' off M.H. 39 @ 2.00	10'
10	144' off M.H. 38 over 57' right	9'
11	41' off M.H. 38 over 30' right	9'
12	132' off M.H. 35 over 27' right	8'
13	27' off M.H. 35 over 24' right	12'
14	10' off M.H. 33 over 10' right	8'
15	103' off M.H. 32 over 10' right	9'
16	10' off M.H. 32 @ 2.00 right	9'
17	102' off M.H. 31 over 10' right	8'
18	10' from M.H. 31 @ 2.00	8'
19	120' from M.H. 9 over 10' right	8'
20	15' from M.H. 9 over 10' right	10'

Boseman

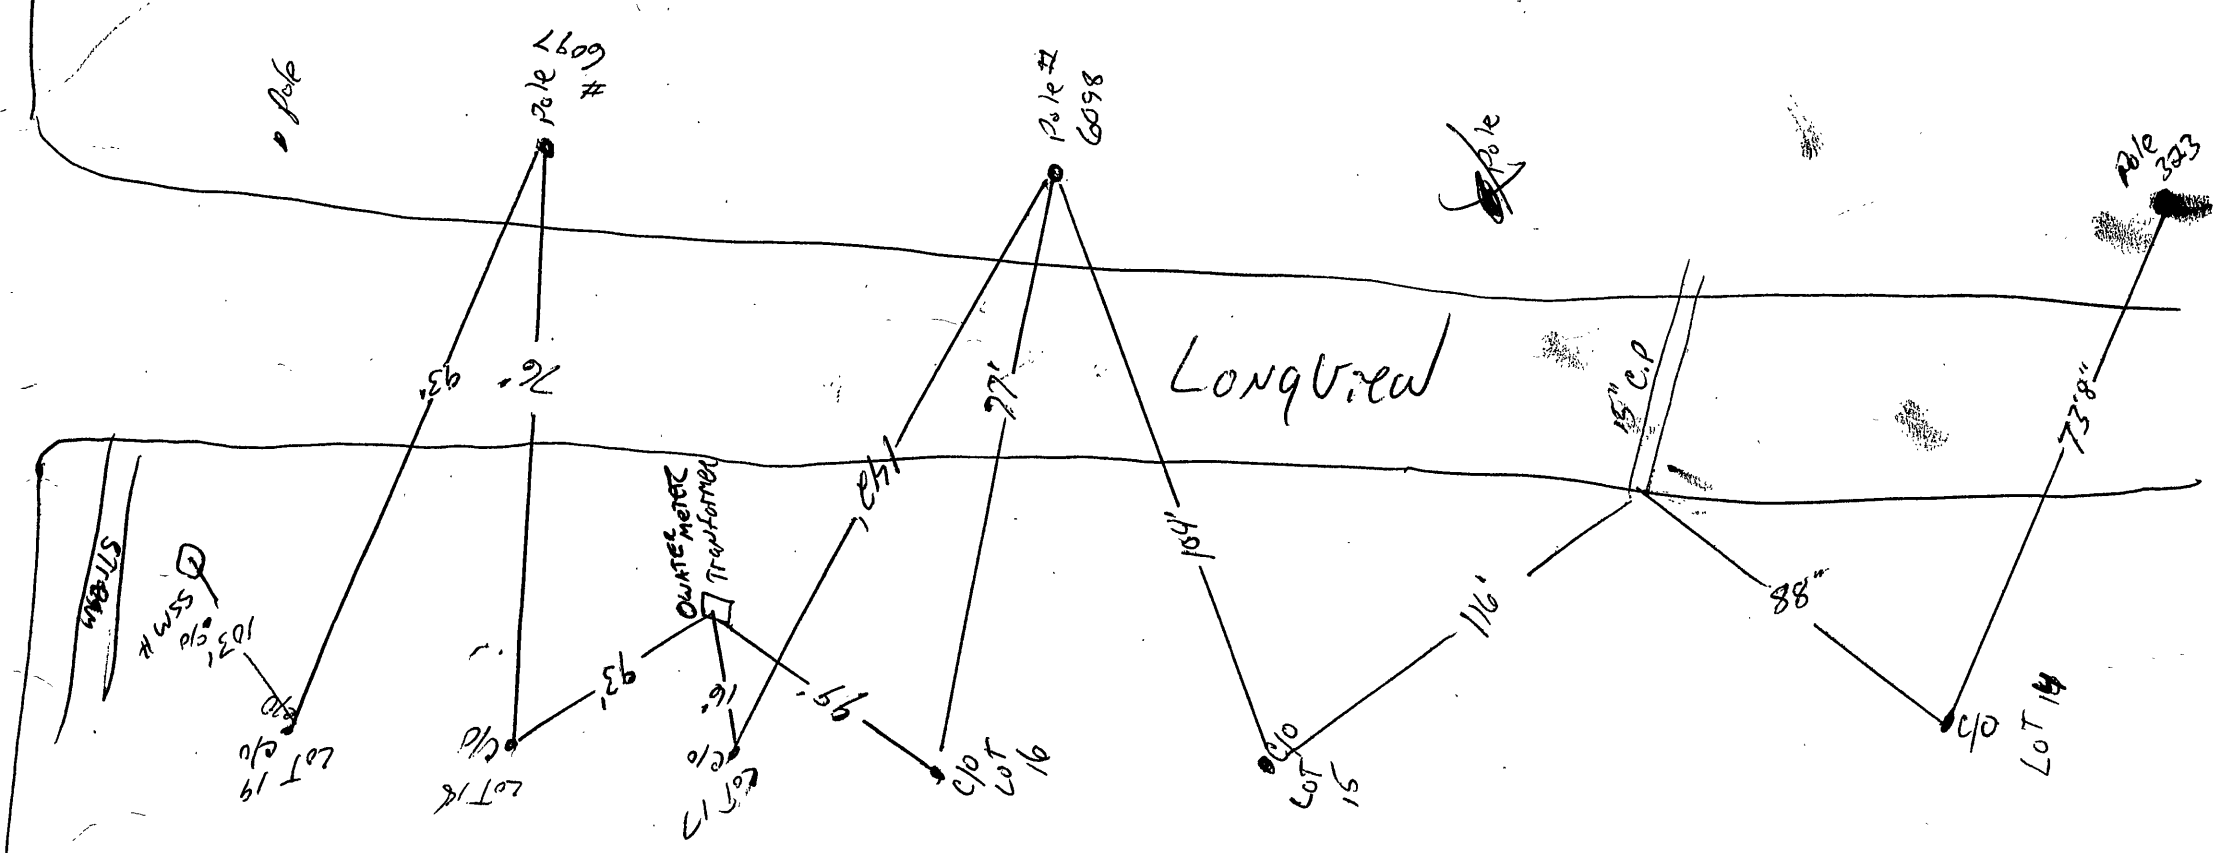

AS-BUILTS 10/14/2005

WWW ID# 6QSG72