


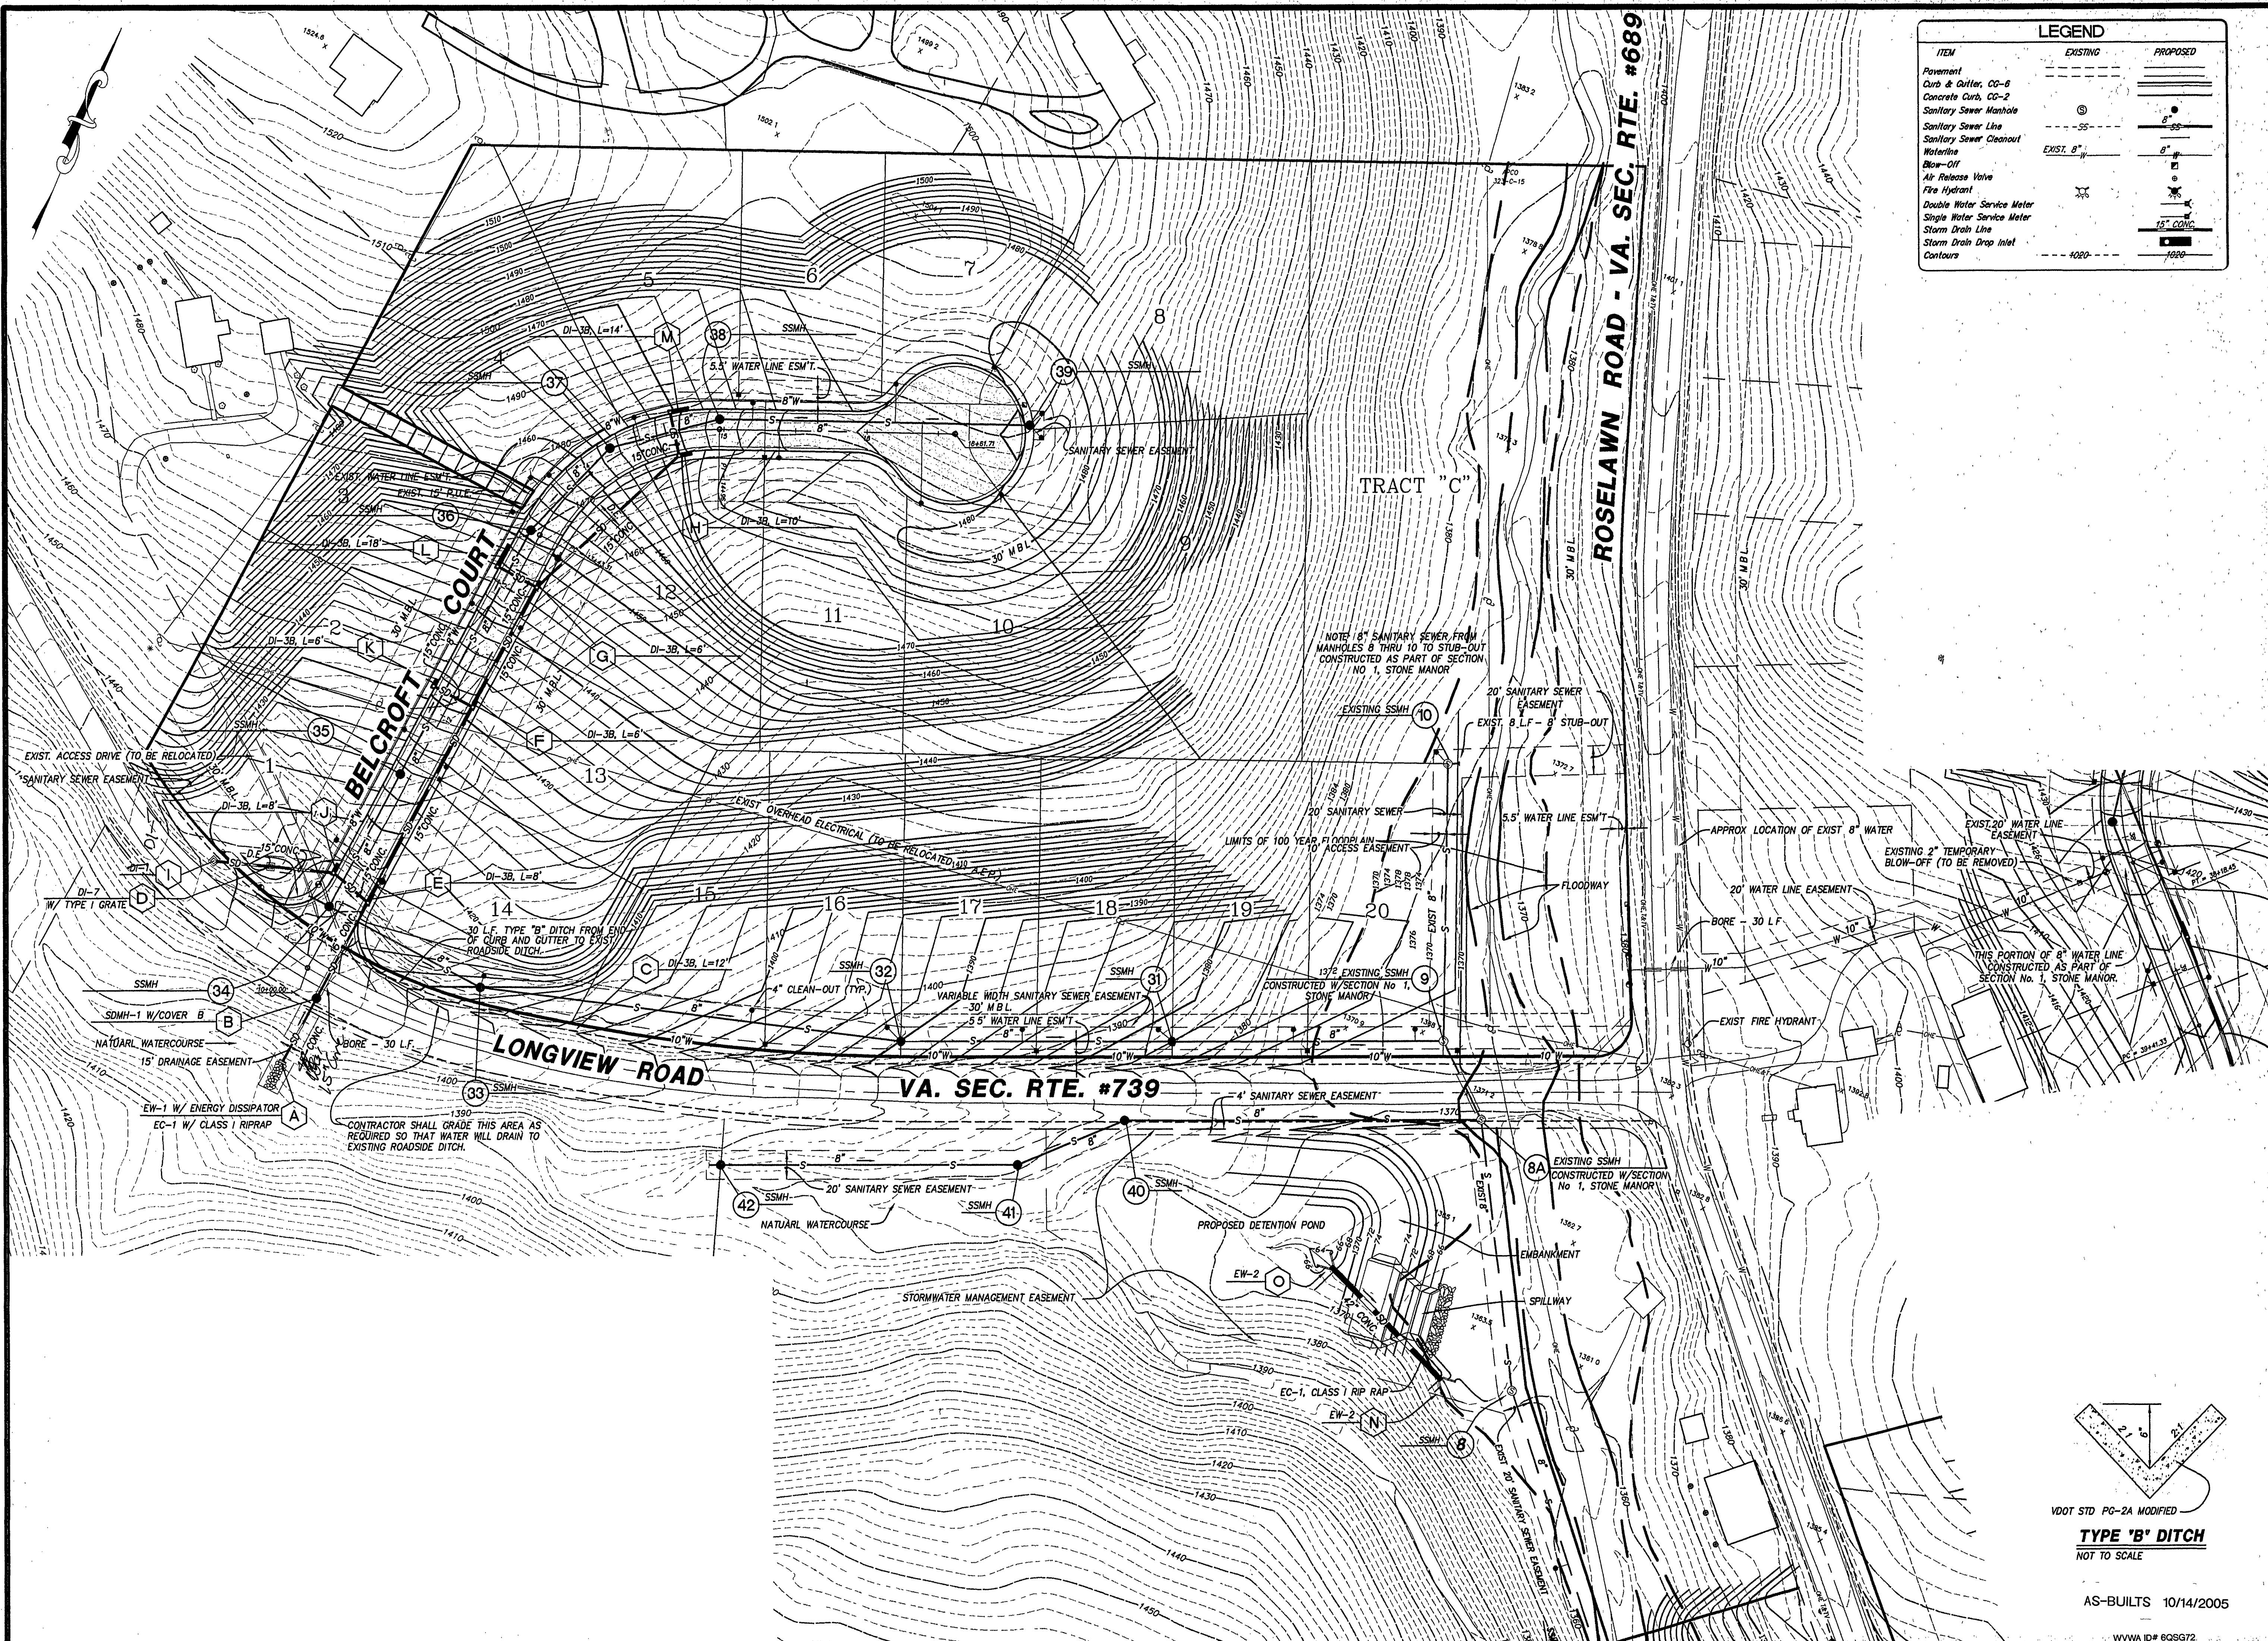

LEGEND		
ITEM	EXISTING	PROPOSED
Pavement	---	---
Curb & Gutter, CG-6	---	---
Concrete Curb, CG-2	---	---
Sanitary Sewer Manhole	⊙	⊙
Sanitary Sewer Line	---	---
Sanitary Sewer Cleanout	---	---
Waterline	---	---
Waterline	---	---
Blow-Off	---	---
Air Release Valve	---	---
Fire Hydrant	---	---
Double Water Service Meter	---	---
Single Water Service Meter	---	---
Storm Drain Line	---	---
Storm Drain Drop Inlet	---	---
Contours	---	---

LA

LUMSDEN ASSOCIATES, P.C.
ENGINEERS/SURVEYORS-PLANNERS
ROANOKE, VIRGINIA

COMMONWEALTH OF VIRGINIA
THOMAS C. DALE
No. 0330002
3/2/03
PROFESSIONAL ENGINEER

SECTION No. 3
"STONE MANOR"
PREPARED FOR
BOONE, BOONE & LOEB, INC.
WINDSOR HILLS MAGISTERIAL DISTRICT
ROANOKE COUNTY, VIRGINIA

NO.	DATE	DESCRIPTION
1		
2		
3		
4		
5		

DATE: 20 MARCH 2003
SCALE: 1" = 50'
COMMISSION NO.: 01-409
SHEET 6 OF 12

AS-BUILTS 10/14/2005
WWW.ID# 60SG72

VDOT STD PG-2A MODIFIED
TYPE 'B' DITCH
NOT TO SCALE