

WESTERN VIRGINIA WATER AUTHORITY DEYERLE AREA PHASE 2 WATERLINE REPLACEMENT

* * *
CITY OF ROANOKE

SITE SUMMARY

OWNER: WESTERN VIRGINIA WATER AUTHORITY
ADDRESS: 601 S. JEFFERSON ST.
SUITE 300
ROANOKE, VA 24011


CONTACT: EARL SMITH
TELEPHONE NO: 540-853-5792
FAX NO: 540-853-1017

LOCATION: WINDSOR ROAD, ROANOKE CITY

DRAPER ADEN ASSOCIATES REVIEW

THESE PLANS HAVE BEEN SUBJECTED TO TECHNICAL AND QUALITY REVIEWS BY:

NAME: PRINTED	SIGNATURE	DATE
PROJECT DESIGNER		
NAME: PRINTED	SIGNATURE	DATE
PROJECT MANAGER		
NAME: PRINTED	SIGNATURE	DATE
QUALITY REVIEWER		

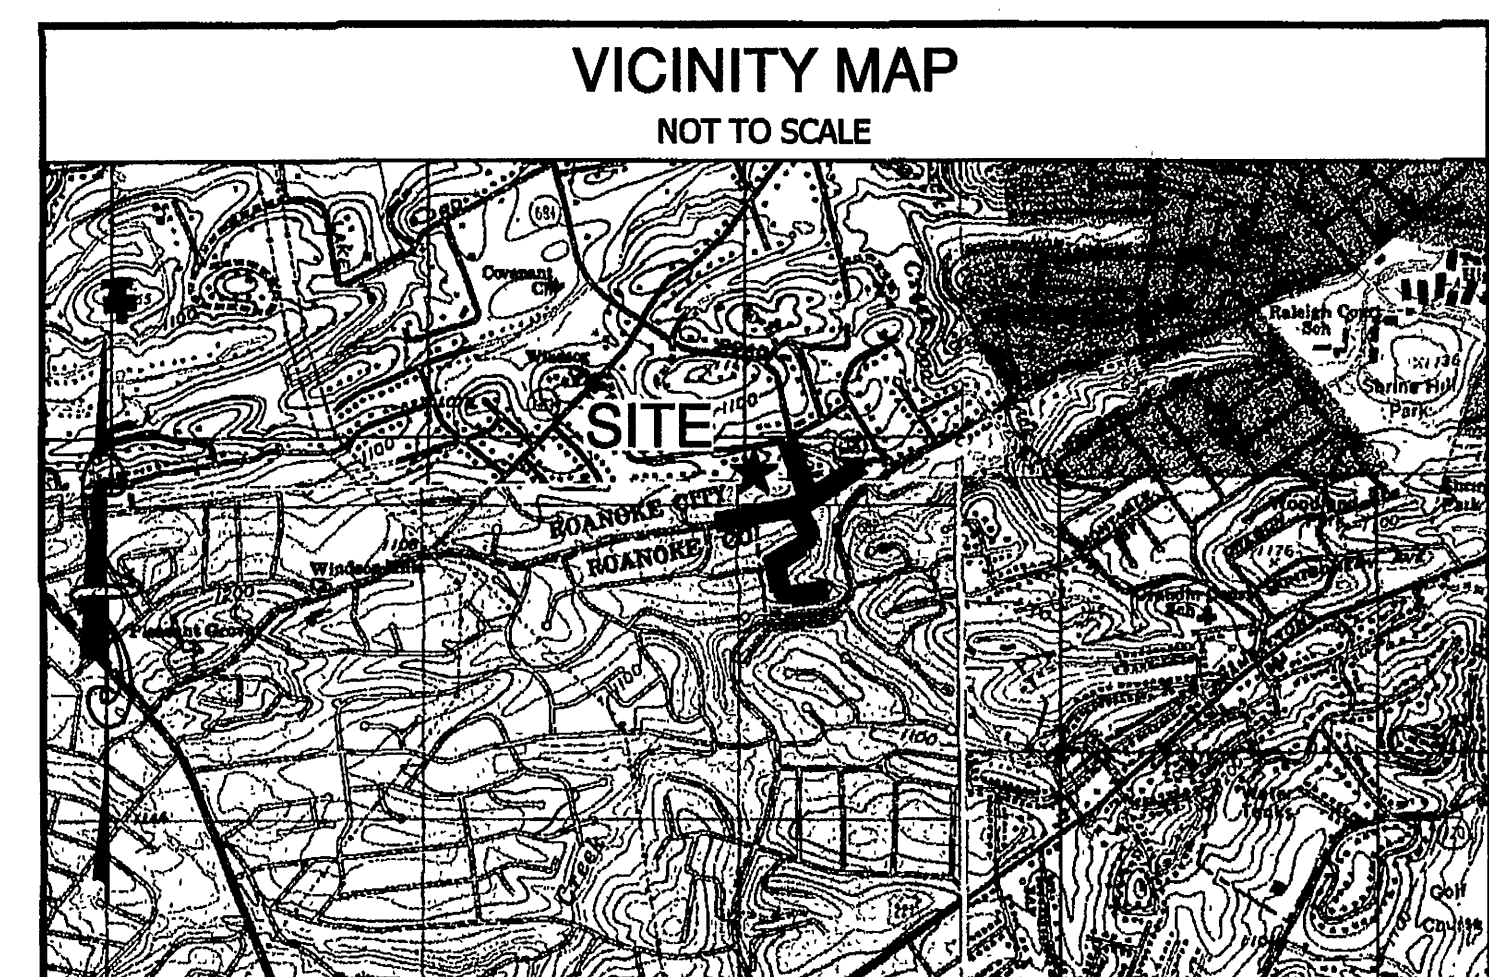

OCTOBER 16, 2007
REVISED: MARCH 2, 2009
* * * * *
B04202-08

NOTE: CONTRACTOR TO CONTACT
MISS UTILITY (1-800-552-7001)
AT LEAST 3 WORKING DAYS IN
ADVANCE OF PLANNED WORK.

DESIGN TICKET No.



These documents, including drawings and specifications, were prepared by Draper Aden Associates, Consulting Engineers, pursuant to a contract by and between Draper Aden Associates and Western Virginia Water Authority with respect to the project described in said contract. Any reuse or modification of said documents (whether hard copy or electronic) without written verification or adaptation by Draper Aden Associates for the specific purpose intended will be at the sole risk of the individual or entity utilizing said documents, drawings and specifications and such use is without the authorization of Draper Aden Associates. Draper Aden Associates, Consulting Engineers, shall have no legal liability resulting from any and all claims, damages, losses, and expenses, including attorney's fees arising out of the unauthorized use of these documents, drawings, specifications, reports, and studies prepared as a result of the aforesaid contract.


DRAWING LIST

NO.	DESCRIPTION
T-1	COVER SHEET
T-2	LEGEND SHEET & GENERAL NOTES
T-3	ESC MINIMUM STANDARDS & DETAILS
U-1	WATERLINE PLAN
U-2	WATERLINE PLAN
U-3	WATERLINE PLAN
U-4	WATERLINE PROFILES
U-5	WATERLINE PROFILES
U-6	WATERLINE PROFILES
U-7	WATERLINE PROFILES
U-8	DETAILS
U-9	DETAILS

CONSTRUCTION PROCEDURE REQUIREMENTS

- RIGHT-OF-WAY EXCAVATION PERMIT - PRIOR TO THE COMMENCEMENT OF ANY DIGGING, ALTERATION OR CONSTRUCTION WITHIN THE PUBLIC RIGHT-OF-WAY (STREETS, ALLEYS, PUBLIC EASEMENTS), A RIGHT-OF-WAY EXCAVATION PERMIT SHALL BE APPLIED FOR AND OBTAINED BY THE CONTRACTOR FROM THE CITY OF ROANOKE.
- LAND DISTURBANCE PERMIT - AN APPROVED EROSION AND SEDIMENT CONTROL PLAN FOR ANY BORROW/FILL SITES ASSOCIATED WITH THE PROJECT MUST BE SUBMITTED PRIOR TO THE ISSUANCE OF A LAND DISTURBANCE PERMIT.
- PLANS AND PERMITS - A COPY OF THE PLANS AS APPROVED BY THE CITY (SIGNED BY THE PROPER CITY OFFICIALS) AND ALL PERMITS ISSUED BY THE CITY SHALL BE AVAILABLE AT THE CONSTRUCTION SITE AT ALL TIMES OF ONGOING CONSTRUCTION.
- LOCATION OF UTILITIES - THE CONTRACTOR SHALL VERIFY THE LOCATION OF ALL EXISTING UTILITIES PRIOR TO THE COMMENCEMENT OF ANY CONSTRUCTION.
- CONSTRUCTION ENTRANCE - THE CONTRACTOR SHALL INSTALL AN ADEQUATE CONSTRUCTION ENTRANCE FOR ALL CONSTRUCTION RELATED EGRESS FROM THE SITE. SIZE AND COMPOSITION OF CONSTRUCTION ENTRANCE SHALL BE AS SHOWN ON THE PLANS.
- STREETS TO REMAIN CLEAN - IT SHALL BE THE RESPONSIBILITY OF THE CONTRACTOR TO INSURE THAT THE PUBLIC STREET ADJACENT TO THE CONSTRUCTION ENTRANCE REMAINS FREE OF MUD, DIRT, DUST, AND/OR ANY TYPE OF CONSTRUCTION MATERIALS OR LITTER AT ALL TIMES.
- BARRICADES/DITCHES - THE CONTRACTOR SHALL MAINTAIN THE INTEGRITY OF ALL EXCAVATED DITCHES AND SHALL FURNISH AND ENSURE THAT ALL BARRICADES PROPER AND NECESSARY FOR THE SAFETY OF THE PUBLIC ARE IN PLACE.
- SEWER AND PAVEMENT REPLACEMENT - CONSTRUCTION OF SANITARY SEWERS AND THE REPLACEMENT OF PAVEMENT SHALL BE IN ACCORDANCE WITH APPROVED STANDARDS AND SPECIFICATIONS OF THE CITY OF ROANOKE AND THE WESTERN VIRGINIA WATER AUTHORITY
- APPROVED PLANS/CONSTRUCTION CHANGES - ANY CHANGE OR VARIATION FROM CONSTRUCTION DESIGN AS SHOWN ON THE OFFICIALLY APPROVED PLANS SHALL BE APPROVED BY THE EROSION AND SEDIMENT CONTROL AGENT PRIOR TO SAID CHANGES OR VARIATION IN CONSTRUCTION BEING MADE.
- FINAL ACCEPTANCE/CITY - THE OWNER OR DEVELOPER SHALL FURNISH THE CITY OF ROANOKE'S PLANNING BUILDING AND DEVELOPMENT DEPARTMENT WITH A FINAL CORRECT SET OF AS-BUILT PLANS PRIOR TO FINAL ACCEPTANCE BY THE CITY.

APPROVALS

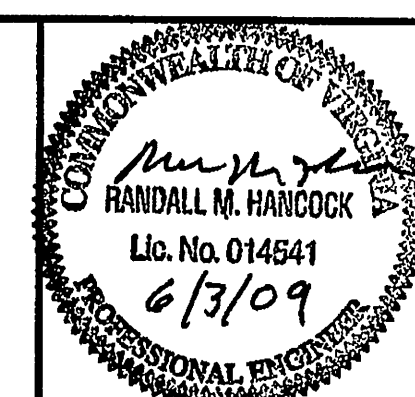

Draper Aden Associates
Engineering • Surveying • Environmental Services
Richmond, VA
Charlottesville, VA
Hampton Roads, VA

Blackburg, VA
2206 South Main Street
Blackburg, VA 24060-0291
540-525-1100
www.daa.com

COVER SHEET
DEYERLE AREA PHASE 2 WATERLINE REPLACEMENT

WESTERN VIRGINIA WATER AUTHORITY
CITY OF ROANOKE, VIRGINIA

REVISIONS
DECEMBER 10, 2008
PER CITY COMMENTS

AS-BUILT
RECEIVED
NOV 12 2009
By: [Signature]

DESIGNED BY: RMH
DRAWN BY: DLD
CHECKED BY: RMH
SCALE: N/A
DATE: 10-24-07
PROJECT NUMBER: B04202-08
T-1