


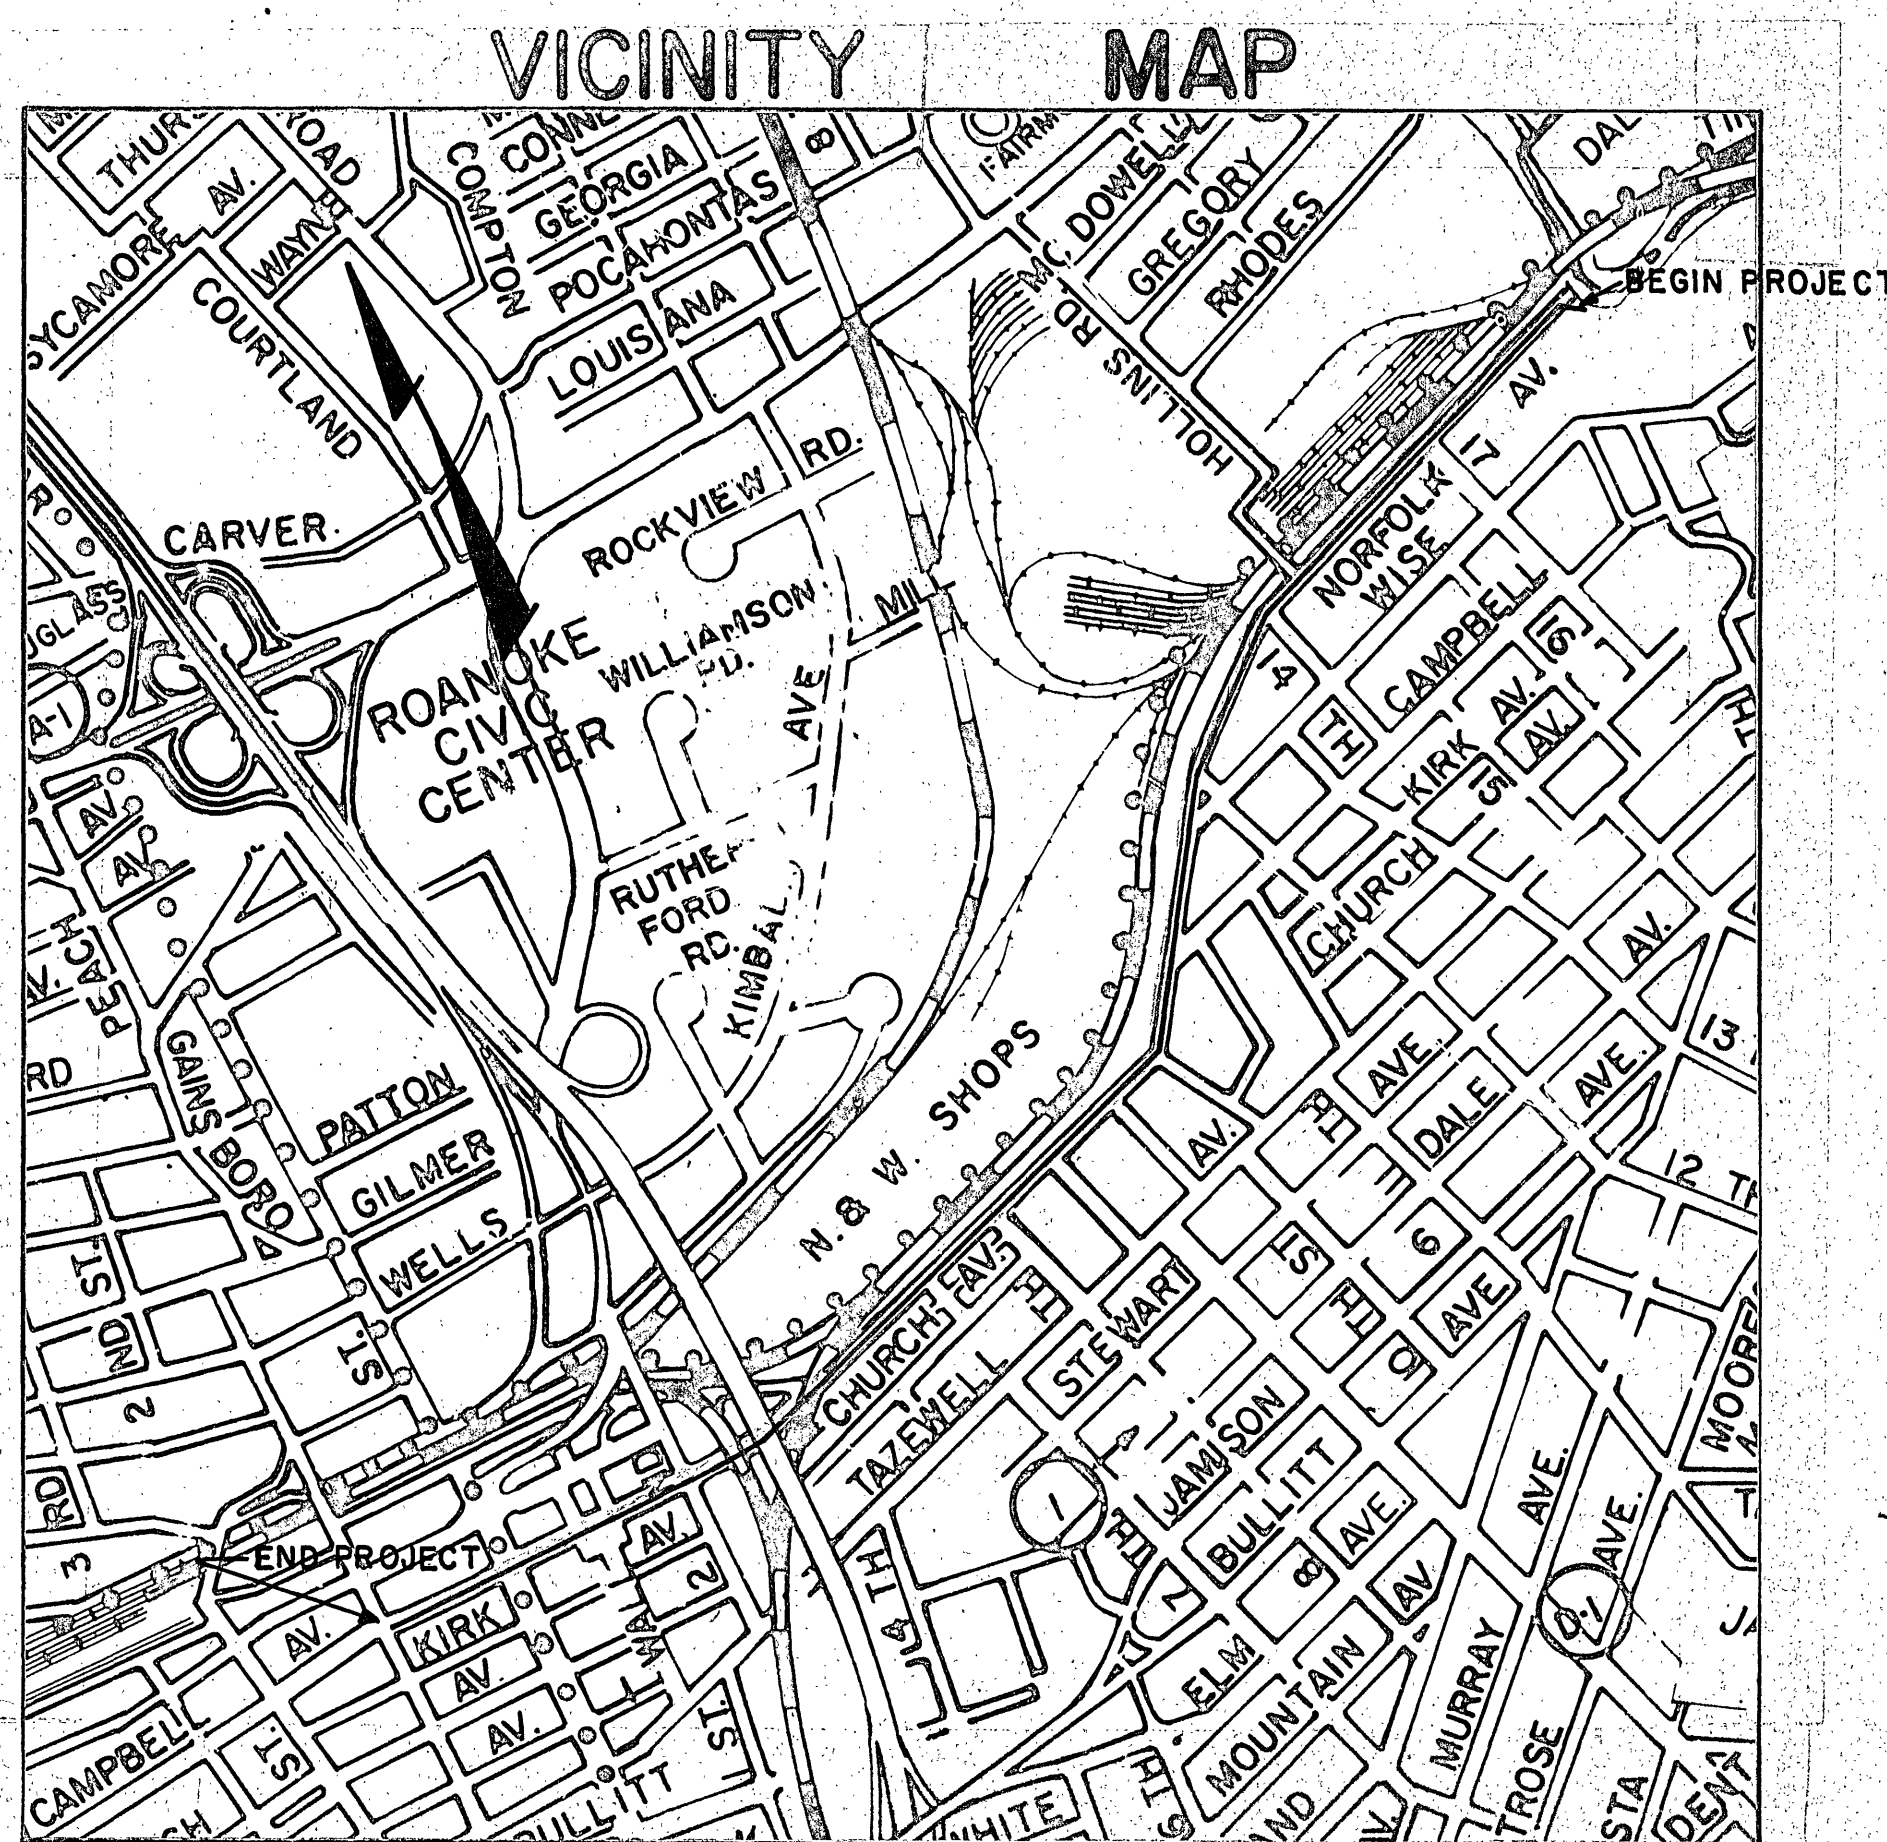

ROANOKE, VIRGINIA

OFFICE OF CITY ENGINEER CONSTRUCTION PLAN

PROPOSED DOWNTOWN- NORFOLK AVE. SANITARY SEWER INTERCEPTOR REPLACEMENT FROM: 1st & CAMPBELL, S.W. TO: TINKER CREEK

PROJECT NO. : C-510-510-01

INDEX OF SHEETS

SHEET NO.	DESCRIPTION
1	COVER SHEET
2	QUANTITIES, GENERAL NOTES & LEGEND
3	PLAN - PROFILE
4	" "
5	" "
6	" "
7	" "
8	" "
9	" "
10	" "
11	" "
12	" "
13	" "
14	SIPHON DETAILS
15	DETAILS
16	METERING CHAMBER

INSPECTOR'S COPY

As-Built
(done)

7 of 16	9-29-75		
2, 4, 6, 8 of 16	12-12-75		
11, 13, 15	4-6-76		
2, 3, 5, 6, 9, 13, 14, 16	1-23-78		
Add sheet 17	1-23-78		
SHEET NO.	DATE	SHEET NO.	DATE
	PLANS REVISED		

APPROVED FOR CONSTRUCTION	
12-13-79	Charles L. Mitchell
DATE	CITY ENGINEER
DATE	
DATE	
APPROVED
DATE
APPROVED
DATE

SHEET 1 OF 16 17
PLAN NO. 5450