

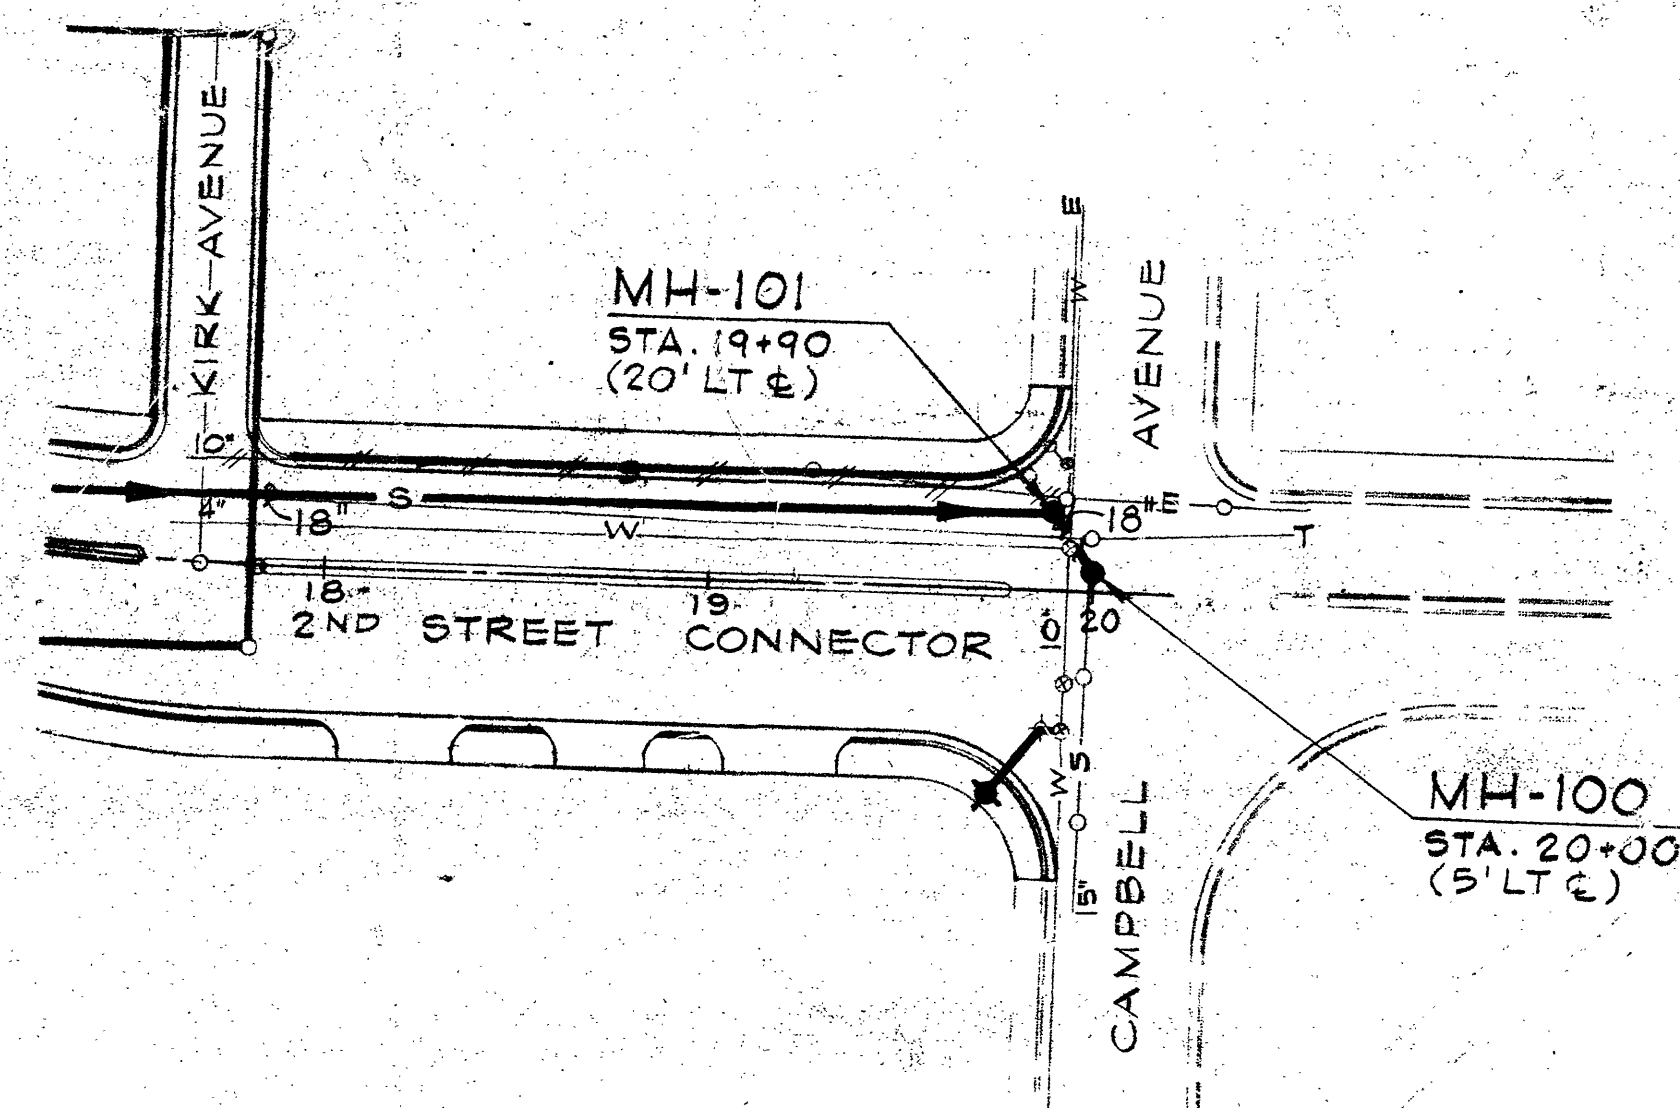


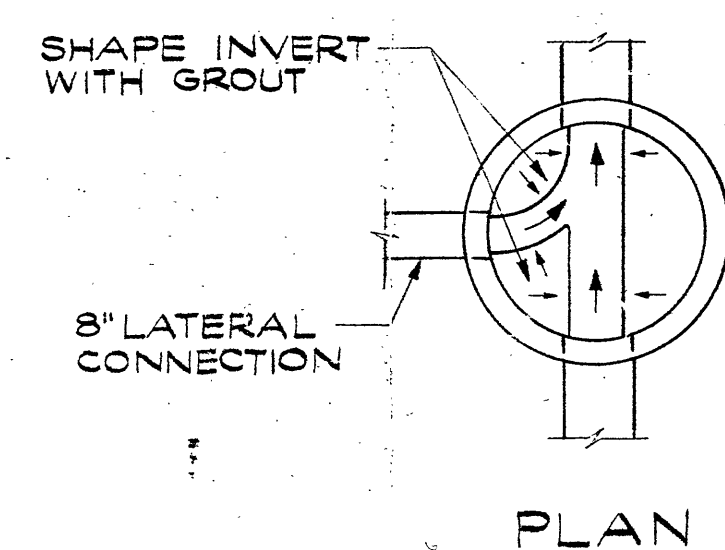


INSERT

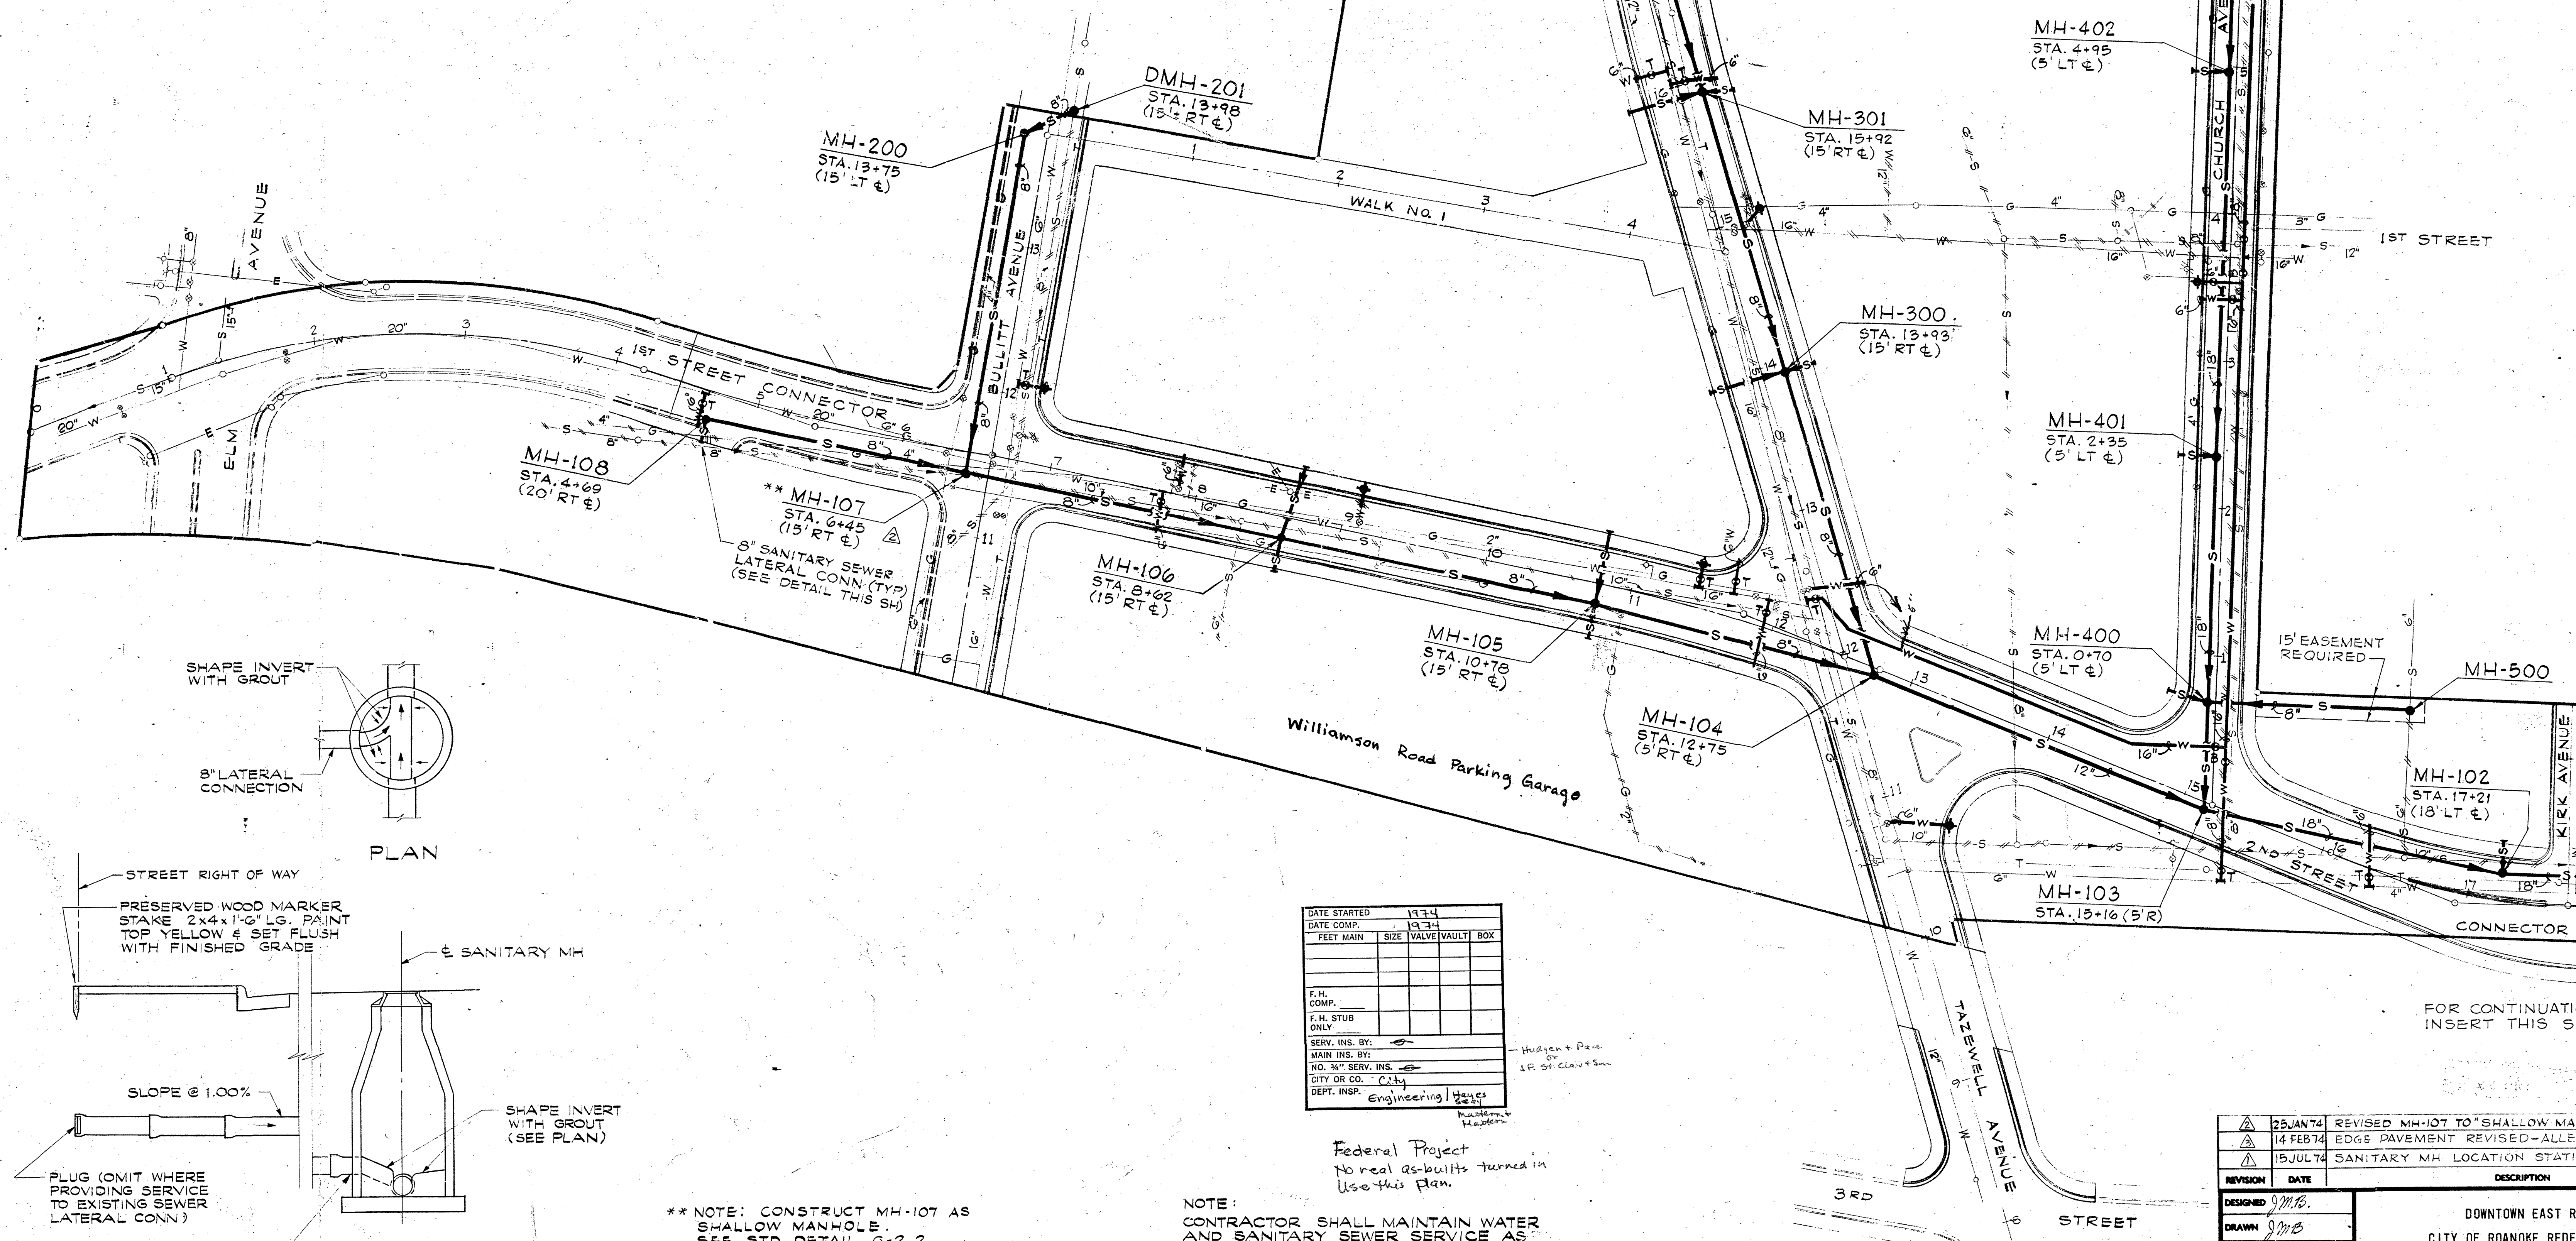

PLAN

STREET RIGHT OF WAY
PRESERVED WOOD MARKER
STAKE 2x4x1'-6" LG. PAINT
TOP YELLOW & SET FLUSH
WITH FINISHED GRADE

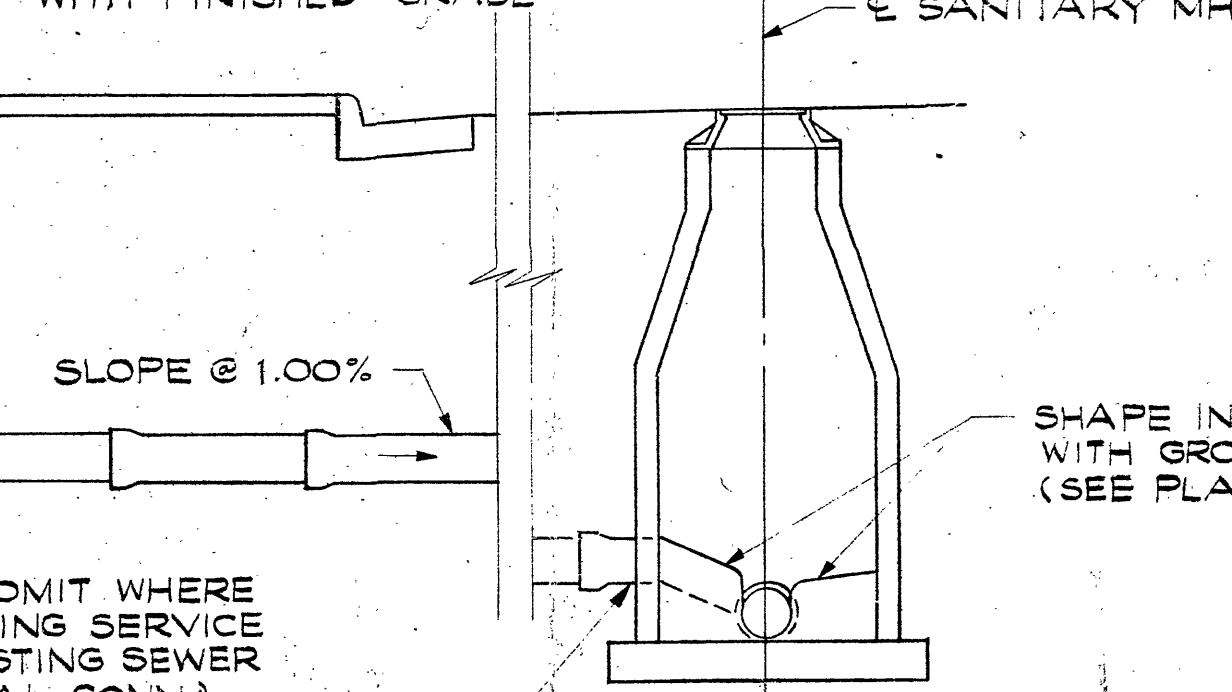

ELEVATION

SANITARY SEWER LATERAL STUB-OUT
NO SCALE

** NOTE: CONSTRUCT MH-107 AS
SHALLOW MANHOLE.
SEE STD DETAIL C-2.2

NOTE:
CONTRACTOR SHALL MAINTAIN WATER
AND SANITARY SEWER SERVICE AS
REQUIRED (SEE WATER AND SEWER
SECTIONS OF SPECIFICATIONS.)

DATE STARTED	1974
DATE COMP.	1974
FEET MAIN	SIZE VALVE VAULT BOX
F.H. COMP.	
F.H. STUB ONLY	
SERV. INS. BY:	
MAIN INS. BY:	
NO. 1/2" SERV. INS.	
CITY OR CO.	City
DEPT. INSP.	Engineering

Federal Project
No real as-builts turned in
Use this plan

WATER DEPARTMENT
CITY OF ROANOKE, VA.
DOWNTOWN EAST
RENEWAL PROJECT
SEPT. 6, 1974

DESIGNED	JMB	REVISION	25 JAN 74	REVISED MH-107 TO "SHALLOW MANHOLE"	JMB	WM2
DRAWN	JMB		14 FEB 74	EDGE PAVEMENT REVISED-ALLEY NO. 1	JMB	WM2
CHECKED	REC		15 JUL 74	SANITARY MH LOCATION STATIONS ADJUSTED	JMB	WM2
APPROVED	JMB					
SUBMITTED	JMB					
HAYES, SEAY, MATTERN & MATTERN ARCHITECTS - ENGINEERS						
DOWNTOWN EAST RENEWAL PROJECT CITY OF ROANOKE REDEVELOPMENT AUTHORITY						
SANITARY SEWER & WATER PLAN						
SCALE 1"=50'			DATE AUG 1973		SHEET 10	
					COMMA NO. 3678	