


11039comp01-01-cv01 plt

FOR


DUNBAR STREET & CARVER AVENUE SANITARY SEWER REPLACEMENTS

DATE: September 25, 2014

PREPARED FOR

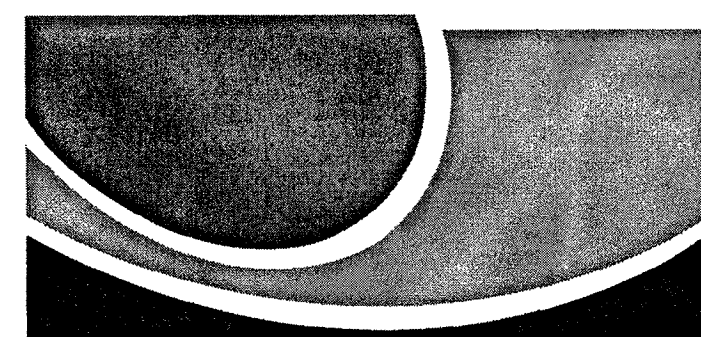

WESTERN VIRGINIA
WATER AUTHORITY

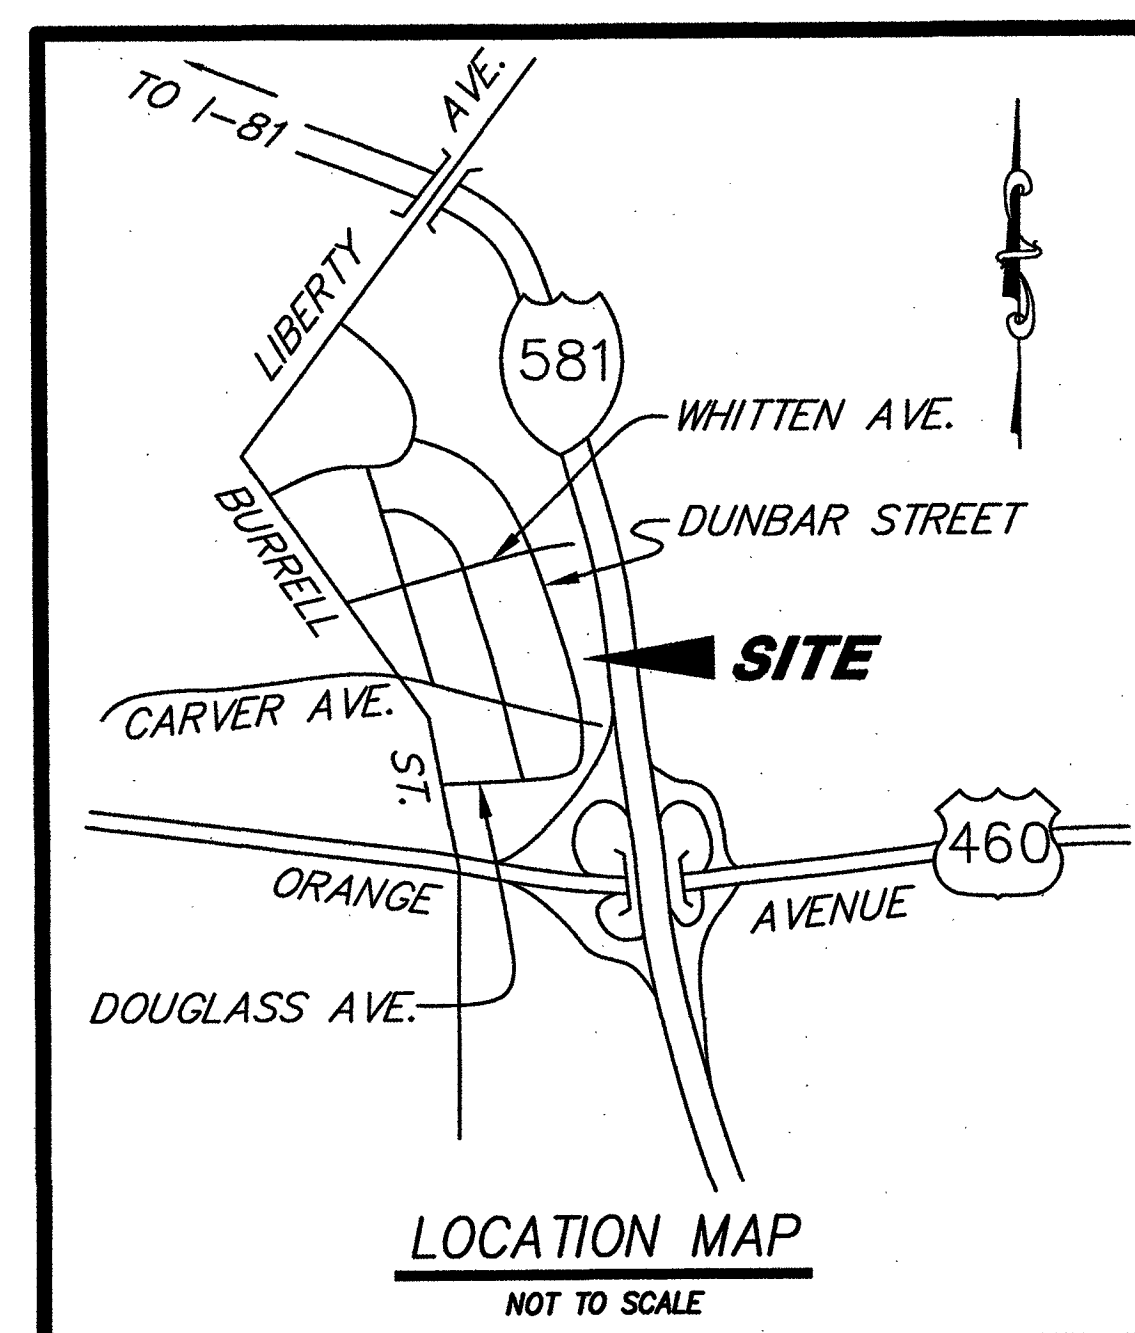

--INDEX OF DRAWINGS--



SHEET No.	DESCRIPTION
1.	COVER SHEET
2.	NOTES & DETAILS
3.	PLAN AND PROFILE DUNBAR STREET
4.	PLAN AND PROFILE DUNBAR STREET
5.	PLAN AND PROFILE CARVER AVENUE
6.	SANITARY SEWER DETAILS
7.	SANITARY SEWER DETAILS
8.	ESC NOTES AND DETAILS

Earl Smith

LA

LUMSDEN ASSOCIATES, P.C.
ENGINEERS-SURVEYORS-PLANNERS

PHONE: (540) 774-4411
FAX: (540) 772-9445
E-MAIL: MAIL@LUMSDENPC.COM

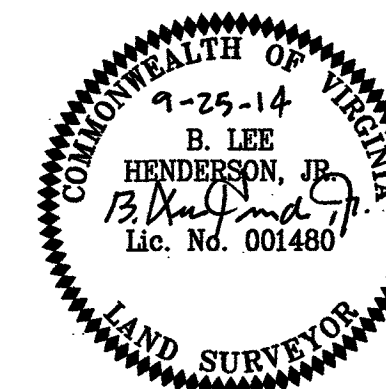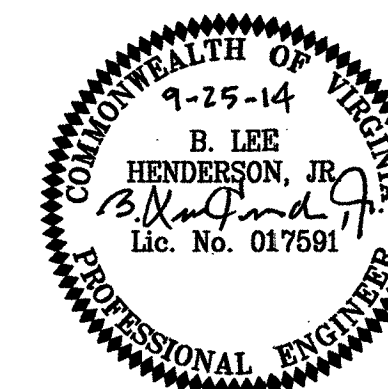[illegible]

As Built

RECEIVED
OCT 13 2015

p:\drawings\2011\11039\eng\11039comp01.dwg