

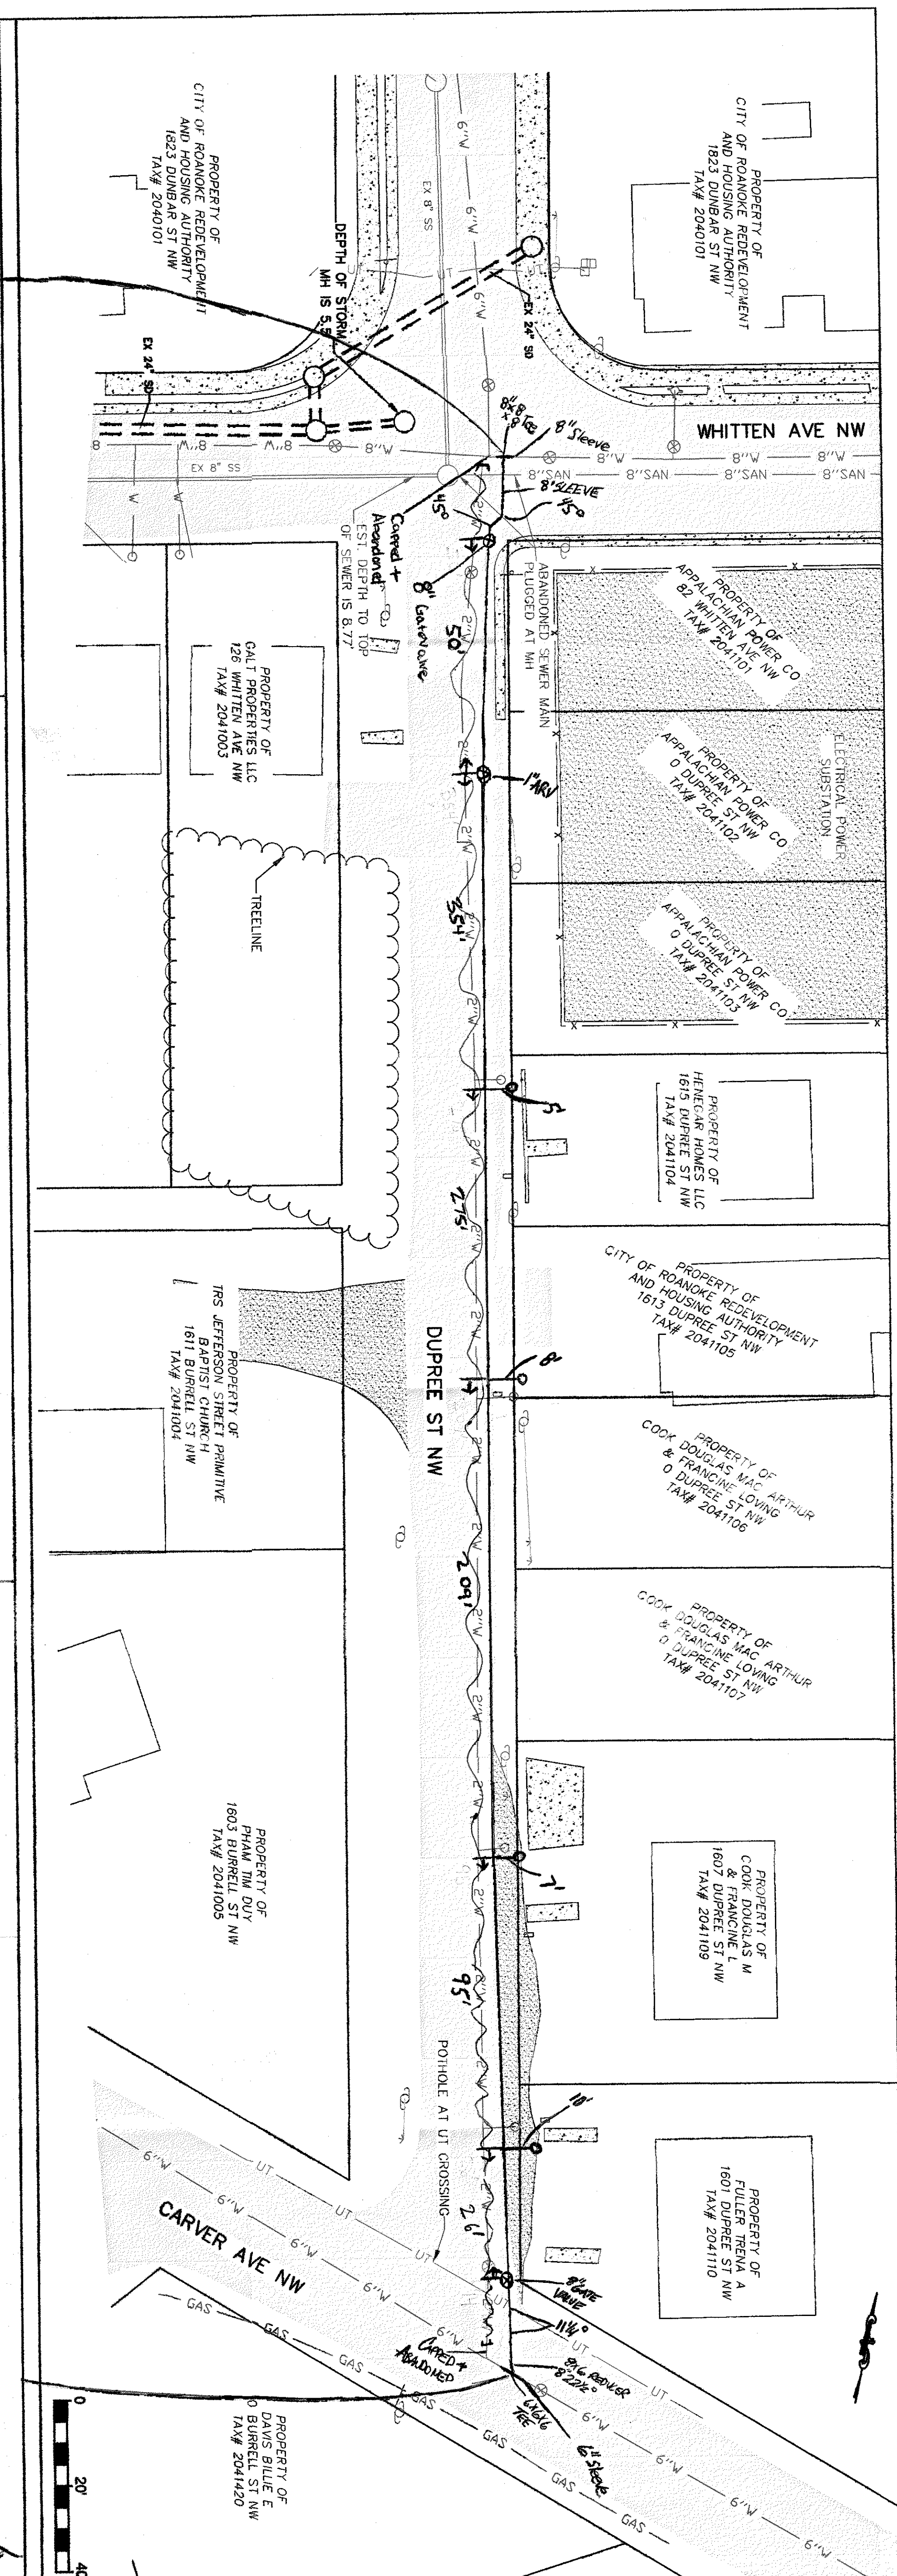


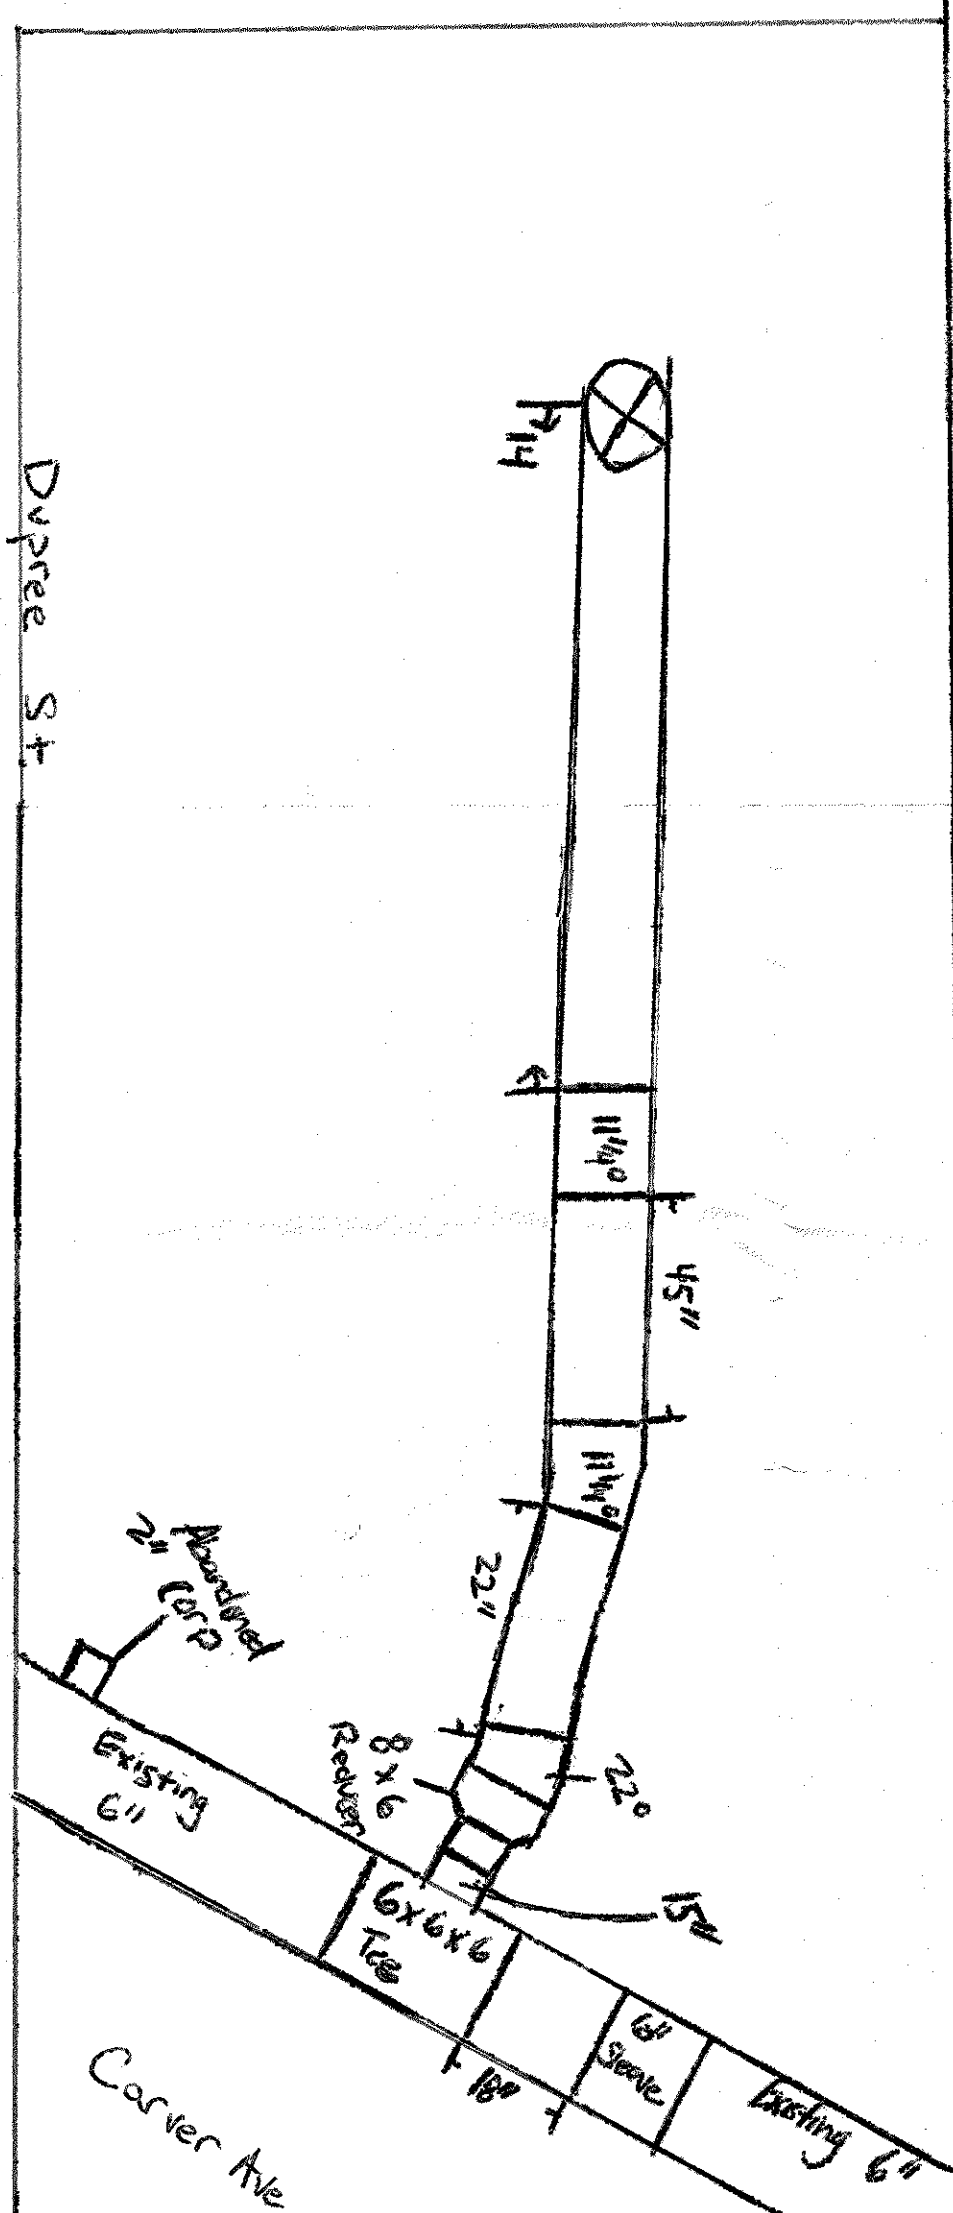

GENERAL NOTES:
1. PROPERTY LINES SHOWN ON THIS PAGE ARE BASED ON GIS DATA AND HAVE NOT BEEN FIELD SURVEYED.

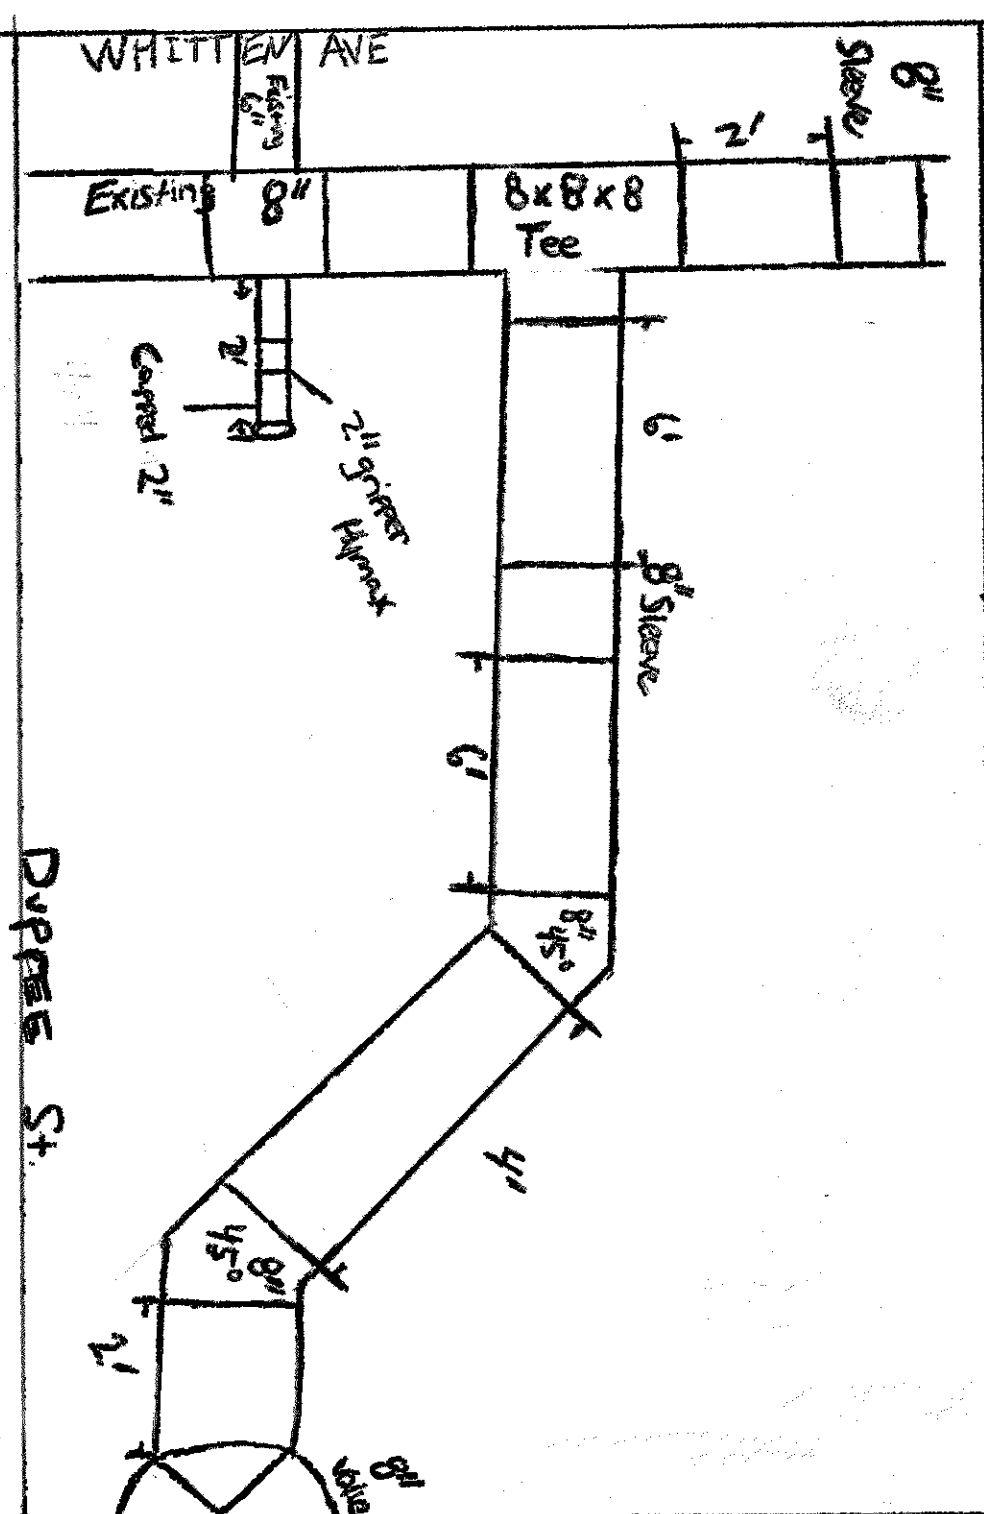

DUNBAR & DUPREE 2" WATERLINE REPLACEMENT					
BASEMAP					
By		Date	Description	Rev	Design:
					Drawn:
					Checked:
					Approved:
					Date:
					Project:

Sheet 2 of 2



WESTERN VIRGINIA
WATER AUTHORITY

ENGINEERING SERVICES
601 S JEFFERSON ST, SUITE 300
ROANOKE, VA 24011
540-853-5700