


DRAFTING ROOM
Received: BY TE DATE 3/21/81
Assigned: TO TE DATE 3/21/81
Started: BY TE DATE 3/21/81
Completed: BY TE DATE 3/21/81
PLEASE RETURN TO
CALVIN DAME AT
READ ROAD SHOP

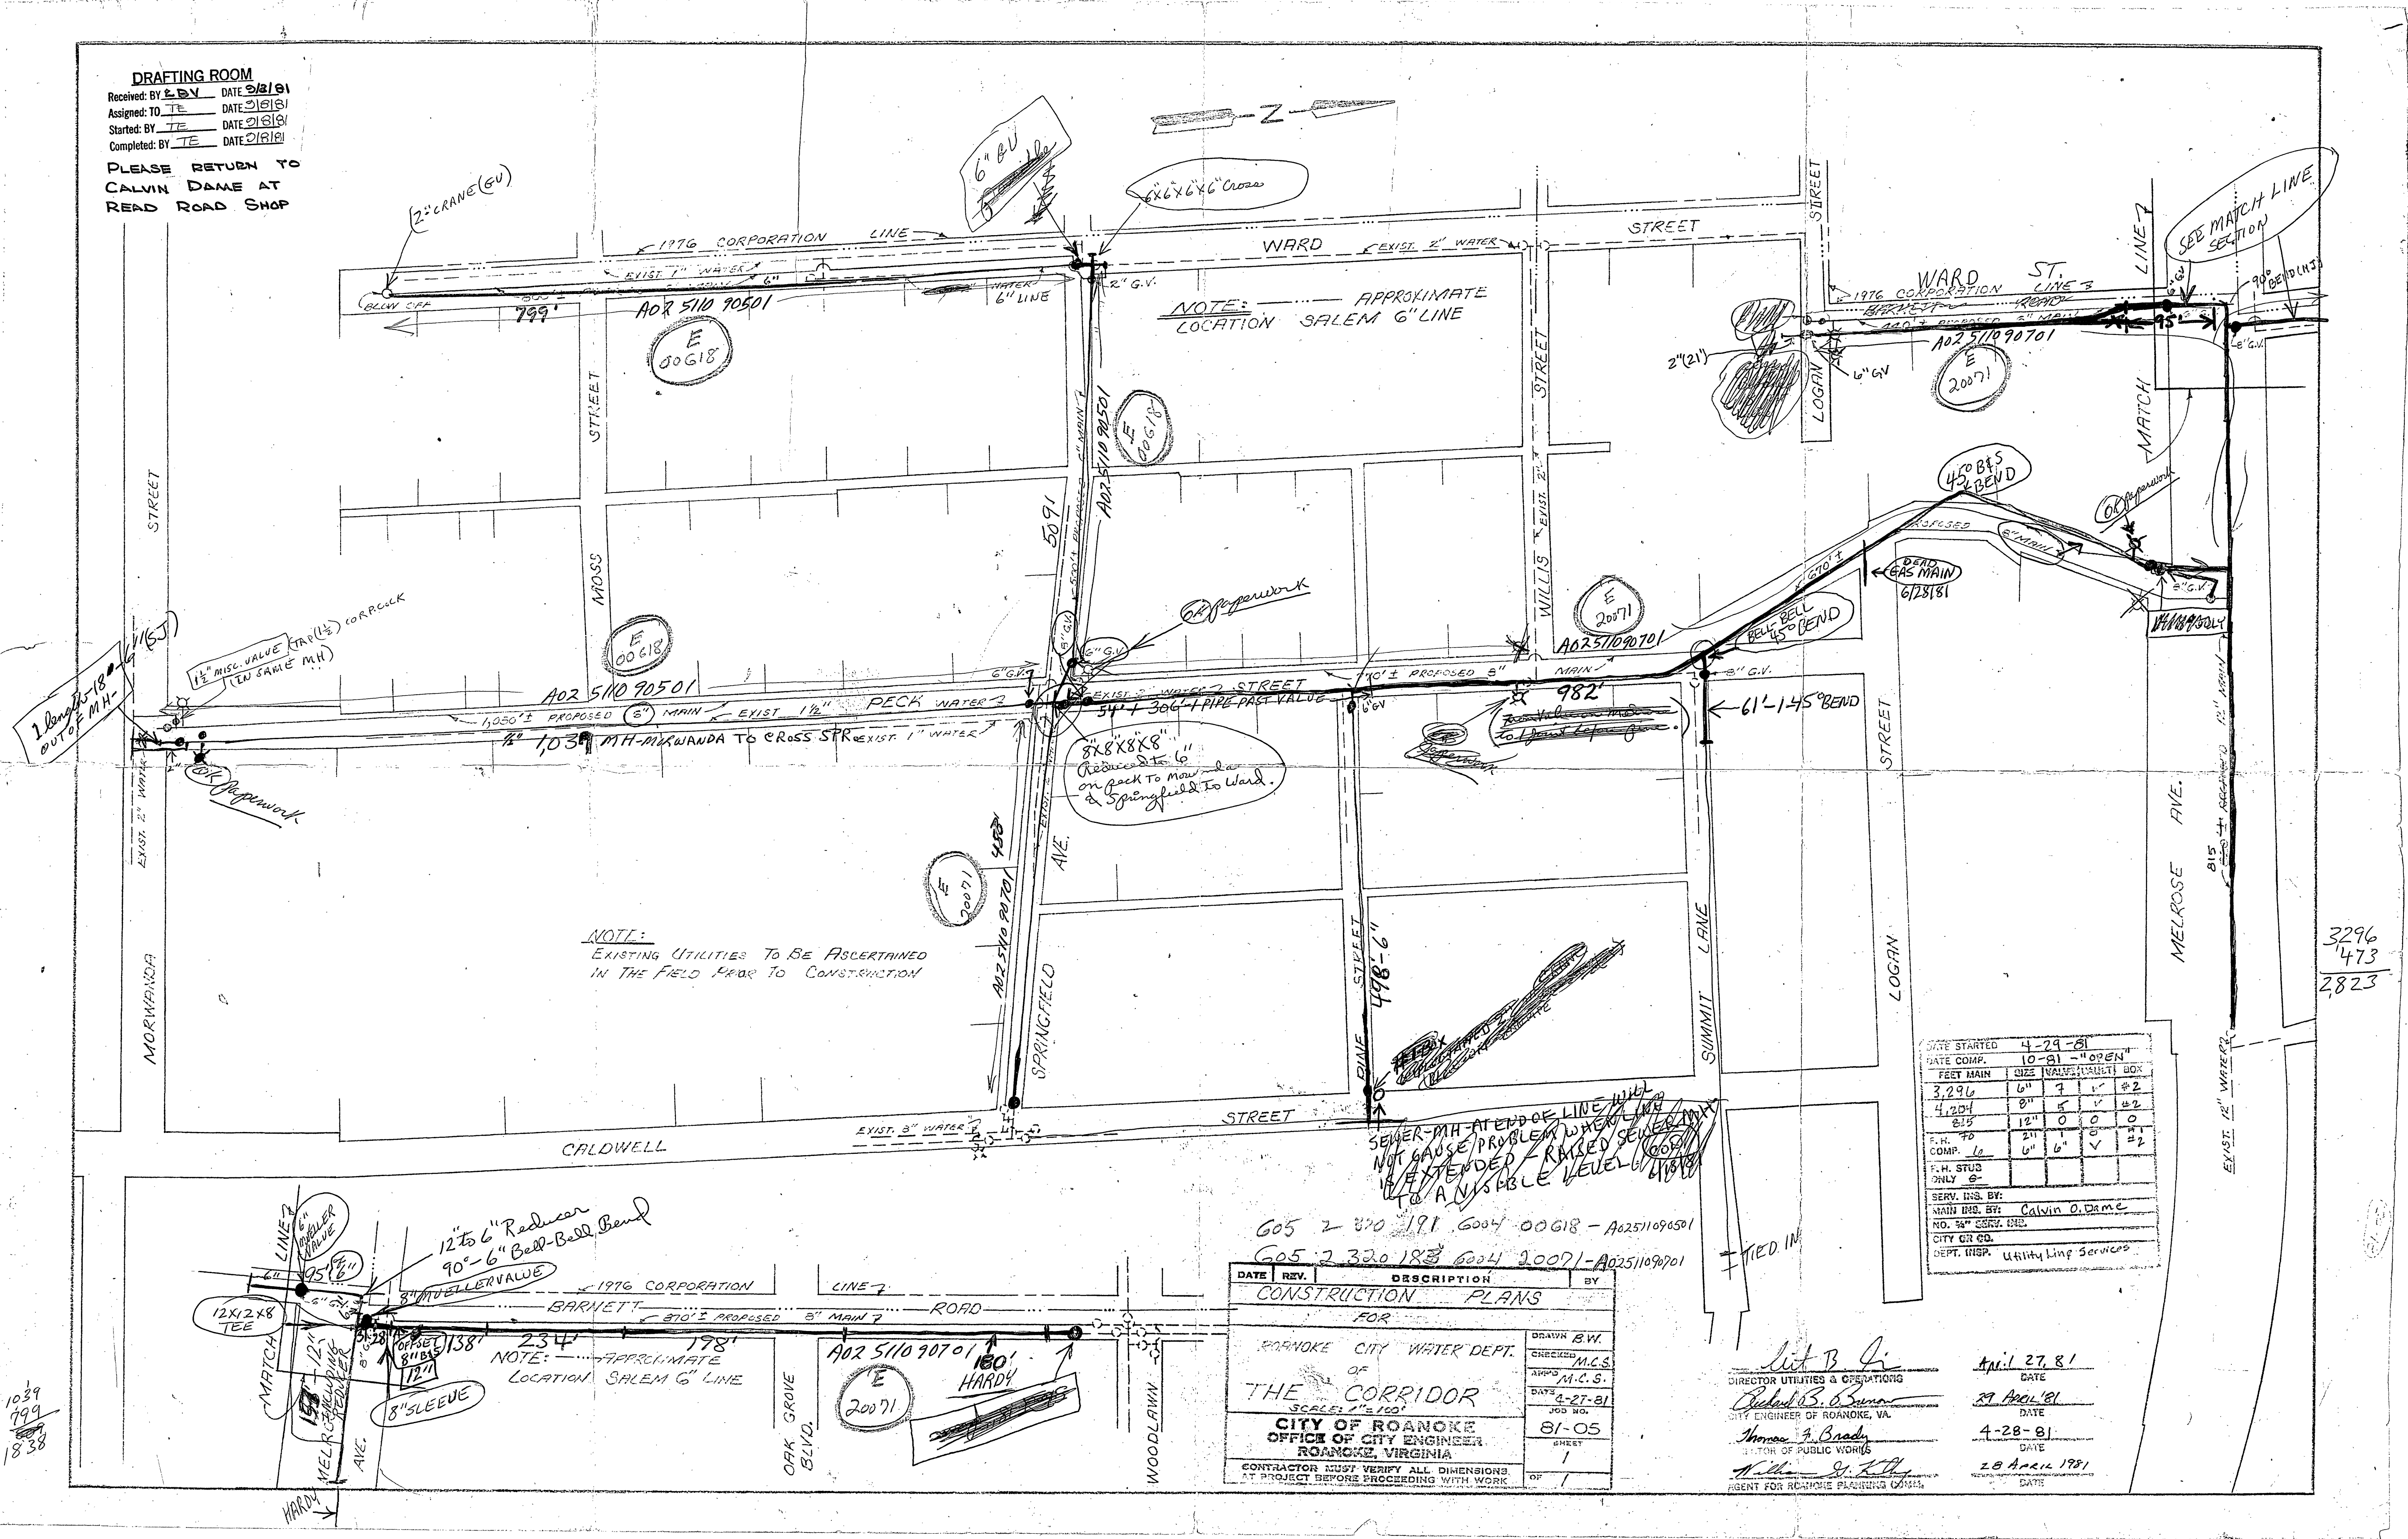

NOTE: APPROXIMATE LOCATION SALEM 6" LINE

NOTE: EXISTING UTILITIES TO BE ASCERTAINED IN THE FIELD PRIOR TO CONSTRUCTION

605 2 320 191 6004 00618 - A02511096501
605 2 320 183 6004 20071 - A0251109701

DATE	REV.	DESCRIPTION	BY
CONSTRUCTION PLANS			
FOR			
ROANOKE CITY WATER DEPT.			
OF			
THE CORRIDOR			
SCALE: 1"=100'			
CITY OF ROANOKE			
OFFICE OF CITY ENGINEER			
ROANOKE, VIRGINIA			
CONTRACTOR MUST VERIFY ALL DIMENSIONS AT PROJECT BEFORE PROCEEDING WITH WORK			

DRAWN	CHECKED	DATE	JOB NO.	SHEET	OF
B.W.	M.C.S.	4-27-81	81-05	1	1

DATE STARTED	4-29-81				
DATE COMP.	10-81 - "OPEN"				
FEET MAIN	SIZES	VALUES	MAULT	BOX	
3,296	6"	7	1	#2	
4,204	8"	5	1	#2	
815	12"	0	0	0	
F.H. TO	21"	1	8	#1	
COMP. 10	6"	6"	✓	#2	
F.H. STUD ONLY	6"				
SERV. INS. BY:					
MAIN INS. BY:	Calvin O. Dame				
NO. 34" SERV. INS.					
CITY OR CO.					
DEPT. INSP.	Utility Line Services				

lit B. G.
DIRECTOR UTILITIES & OPERATIONS
APR 25 1981
CITY ENGINEER OF ROANOKE, VA
Thomas J. Brady
DIRECTOR OF PUBLIC WORKS
APR 28 1981
AGENT FOR ROANOKE PLANNING COM.

APR 27 81
DATE
27 APR 81
DATE
4-28-81
DATE
28 APR 1981
DATE

1039
799
1838

3296
473
2823