


AS BUILT

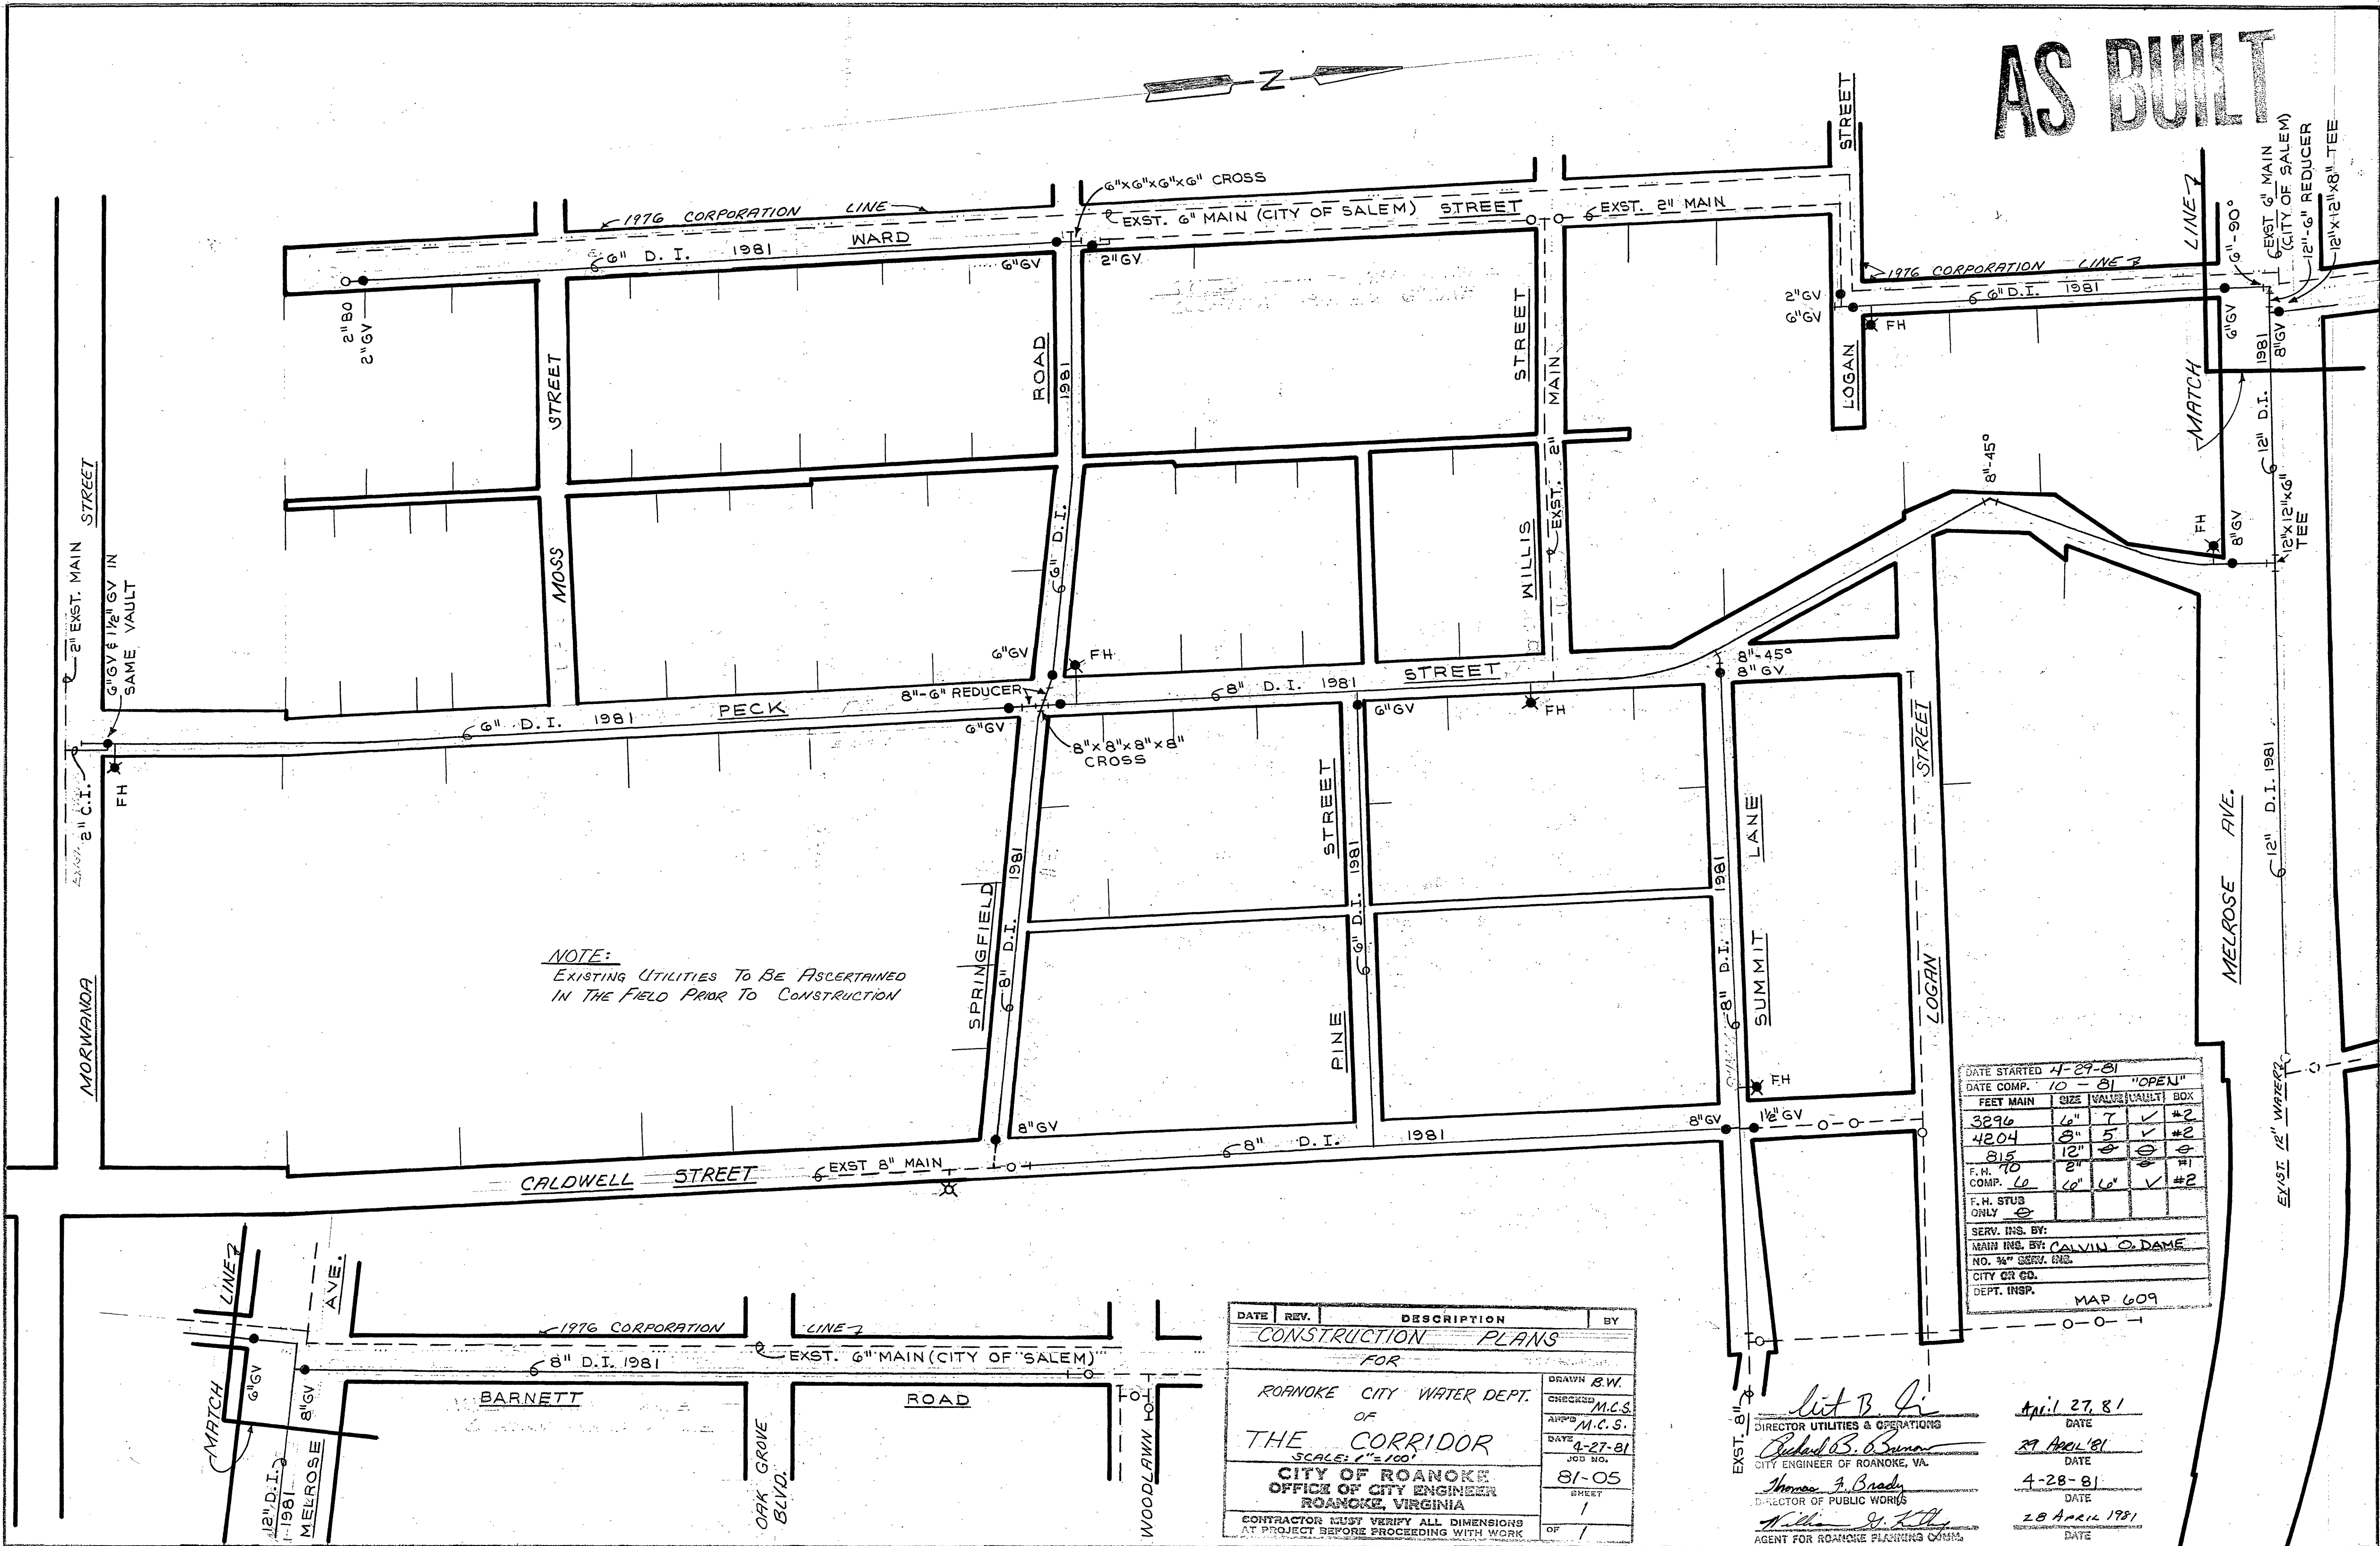

NOTE:
EXISTING UTILITIES TO BE ASCERTAINED
IN THE FIELD PRIOR TO CONSTRUCTION

DATE	REV.	DESCRIPTION	BY
CONSTRUCTION PLANS			
FOR			
ROANOKE CITY WATER DEPT.			
OF			
THE CORRIDOR			
SCALE: 1"=100'			
CITY OF ROANOKE			
OFFICE OF CITY ENGINEER			
ROANOKE, VIRGINIA			
CONTRACTOR MUST VERIFY ALL DIMENSIONS AT PROJECT BEFORE PROCEEDING WITH WORK			

DATE	REV.	DESCRIPTION	BY
4-27-81	1	81-05	
SHEET 1 OF 1			

DATE	REV.	DESCRIPTION	BY
4-27-81	1	81-05	
SHEET 1 OF 1			

DATE STARTED 4-27-81				
DATE COMP. 10-81 "OPEN"				
FEET MAIN	SIZE	VALVE/VAULT	BOX	
3296	6"	7	✓	#2
4204	8"	5	✓	#2
815	12"	8	✓	#1
F.H. COMP.	10	2"	✓	#2
F.H. STATUS	ONLY			
SERV. INS. BY:				
MAIN INS. BY: CALVIN O. DAME				
NO. 94" SERV. INS.				
CITY GR. CO.				
DEPT. INSP.				
MAP 609				

lit B. G.
DIRECTOR UTILITIES & OPERATIONS
CITY ENGINEER OF ROANOKE, VA.
Thomas J. Brady
DIRECTOR OF PUBLIC WORKS
H. Williams
AGENT FOR ROANOKE PLANNING COMM.

April 27, 81
DATE
27 April 81
DATE
4-28-81
DATE
28 April 1981
DATE