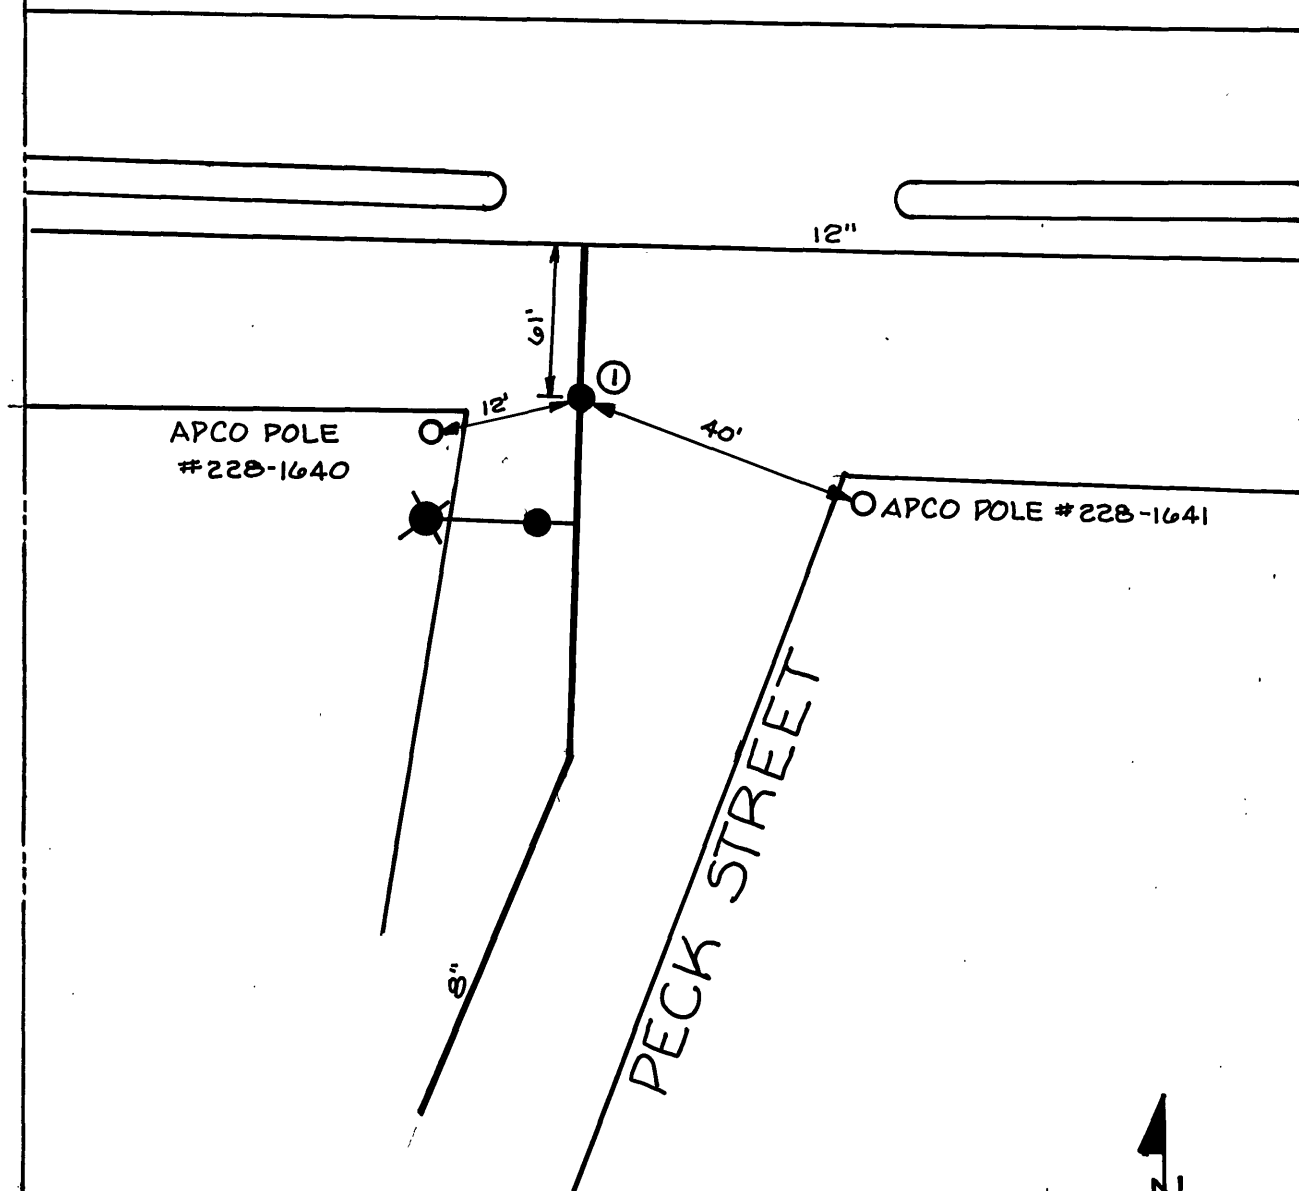


MELROSE AVE.

[illegible]

CITY OF ROANOKE—WATER DEP'T VALVE DIAGRAM

MELROSE AVE.	AND
PECK ST.	

N.W.

SEC. MAP 609

DATE 8-81

PAGE NO.

