


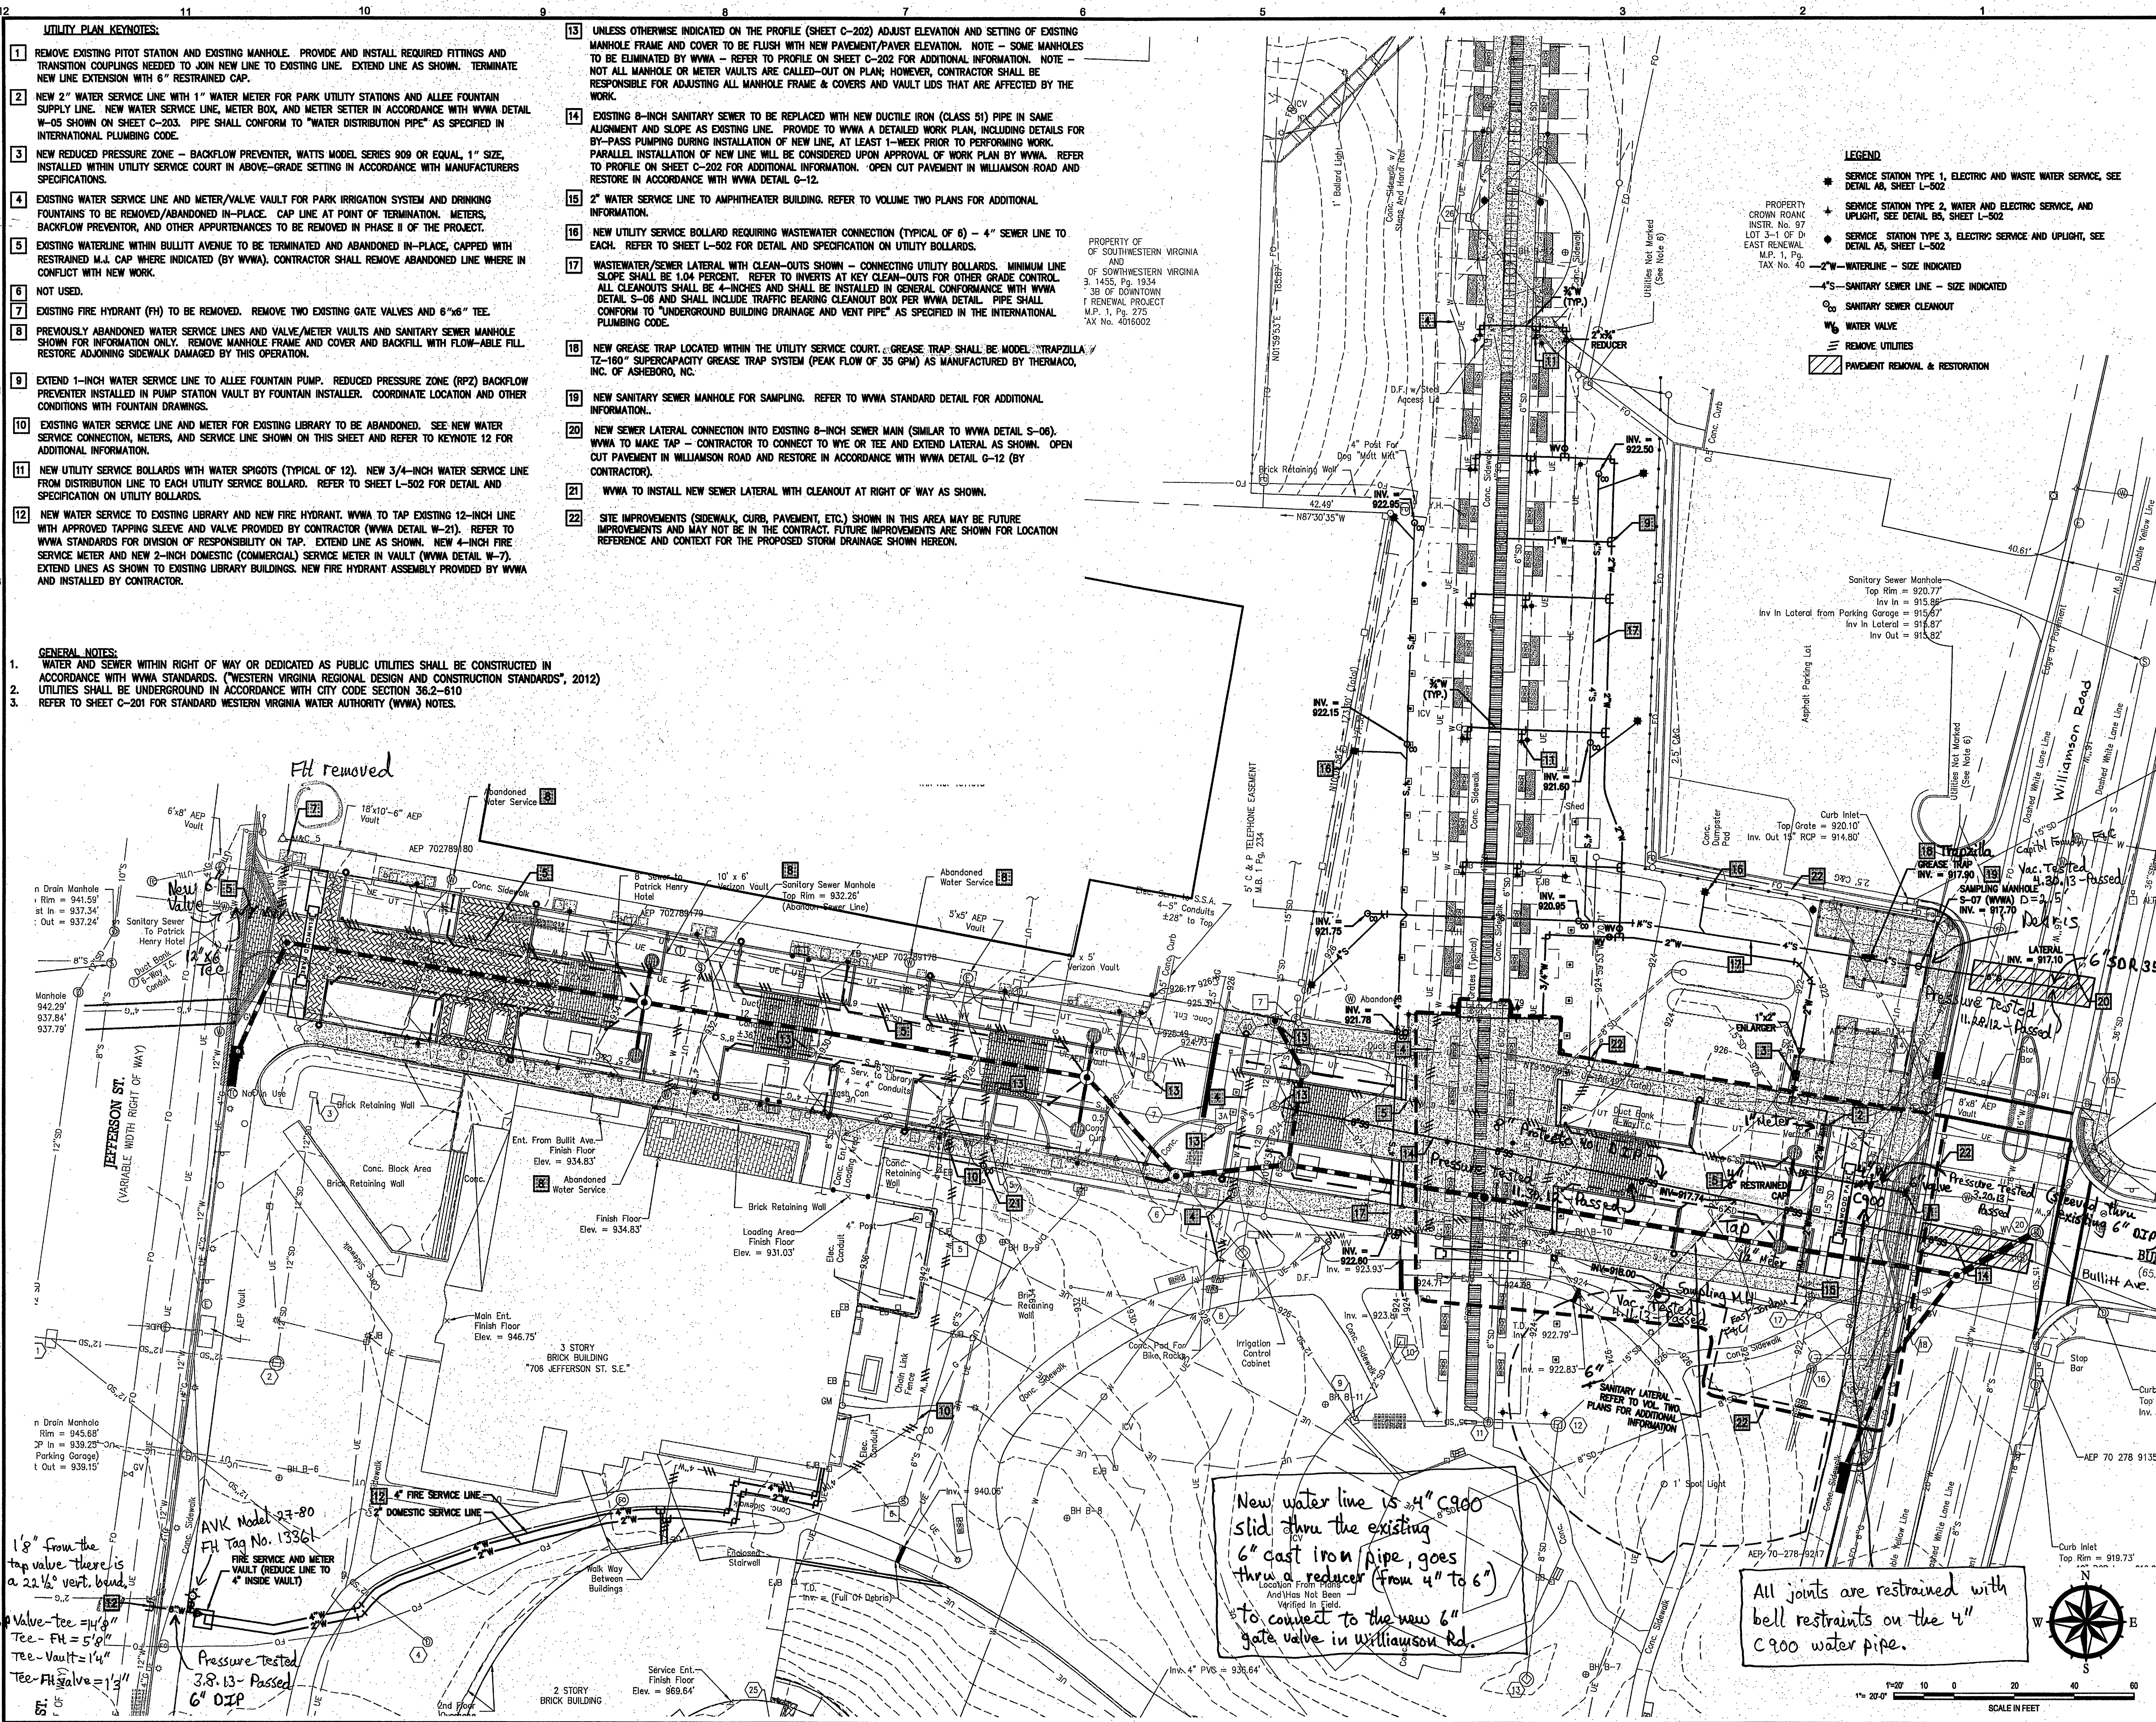


HILL STUDIO
Landscape Architecture
Architecture
Community Planning
Historic Preservation
120 W. Campbell Ave. SW
Roanoke, VA 24011
tel: 540-342-5263 fax: 540-345-5625
www.hillstudio.com

ELMWOOD PARK
IMPROVEMENTS
VOLUME ONE
ROANOKE
VIRGINIA

SPECTRUM DESIGN
Mattern & Craig
CIVIL ENGINEERS & LANDSCAPE ARCHITECTS
201 FIRST STREET, S.W.
ROANOKE, VIRGINIA 24011
TEL: 540-342-5263
FAX: 540-345-5625
www.matternandcraig.com

The 1717 Design Group, Inc.

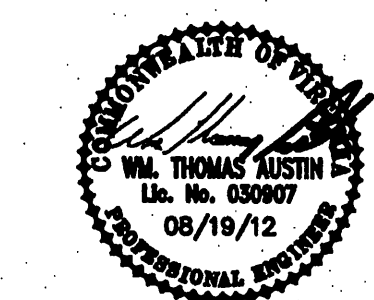

Title: **UTILITY PLAN
BULLITT AVENUE
(ARTWALK) AND
MAGNOLIA ALLEE**

Date: 8/19/12

Revisions:

Drawn By: DPH, GW, CC
Reviewed By: DPH, GW, CC
Project No. 1133.01
Sheet No.

C-200

As-Built ² Ken Winslow 5.1.13