


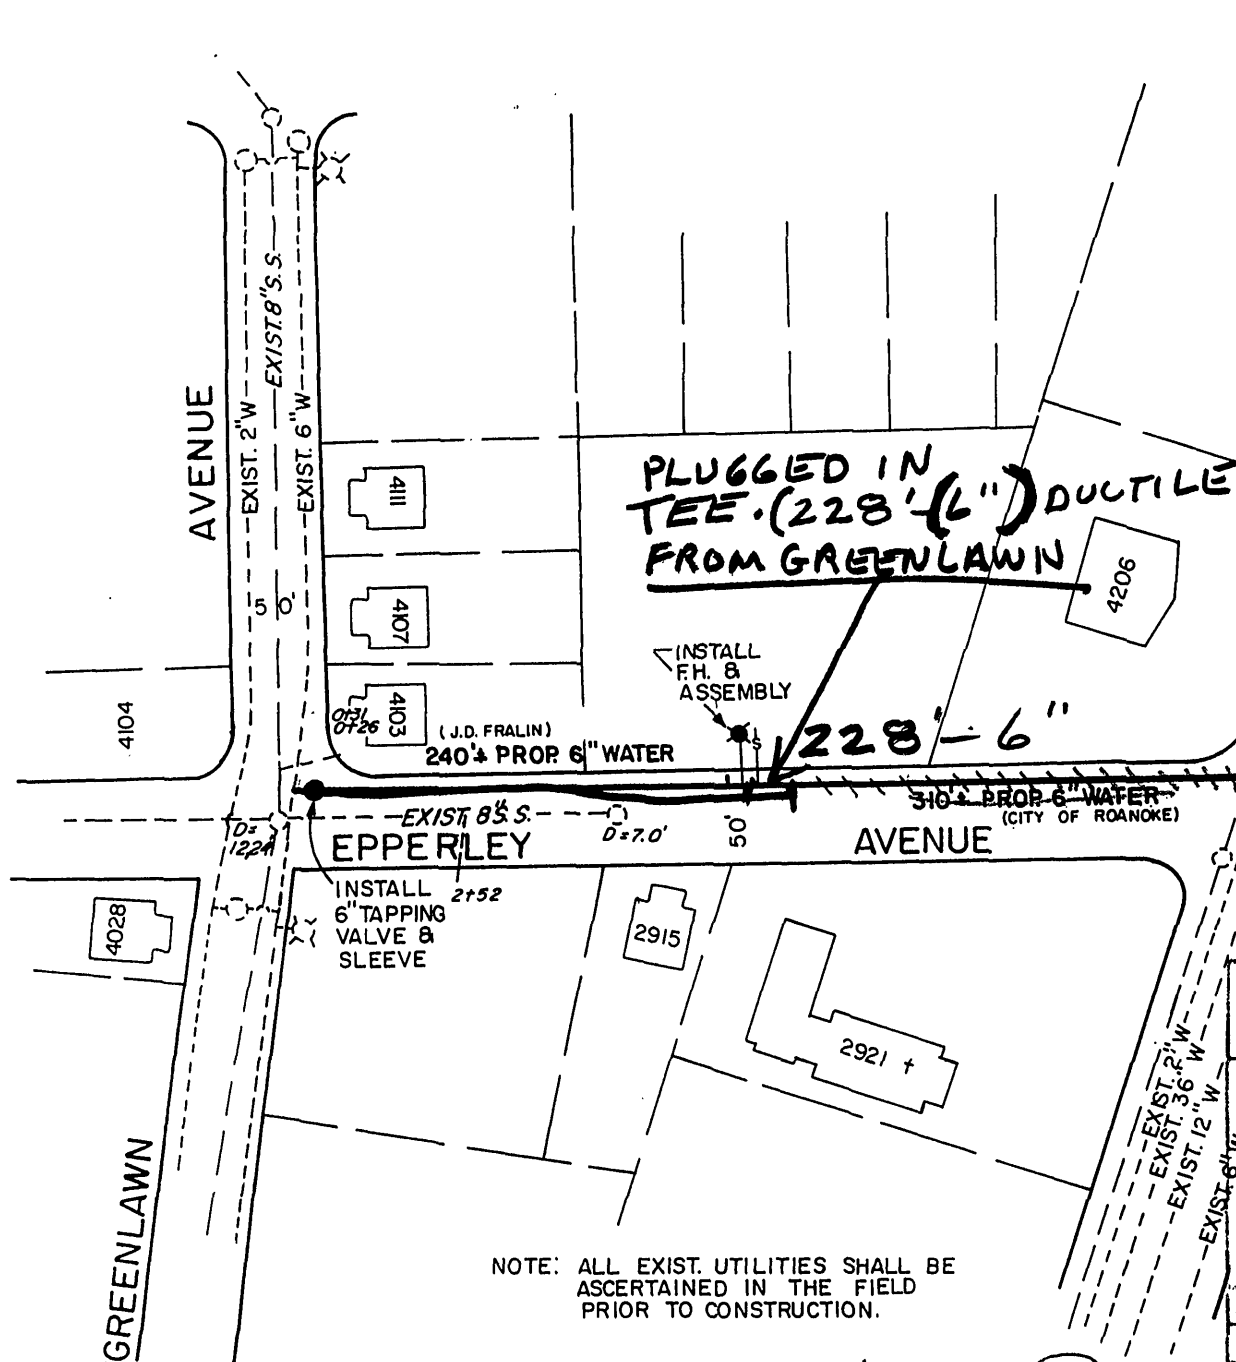

DATE STARTED	6-27-96			
DATE COMP.	7-1-96			
FEET MAIN	228	SIZE	6"	VALVE VAULT BOX
			6"	PC#2
F.H. COMP.	1			
F.H. STUB ONLY	0			
SERV. INS. BY:	James D. Dams			
MAIN INS. BY:	James D. Dams			
NO. & SERV. INS.				
CITY OR AD.	City			
DEPT. INSP.	U.I.S.			

WATER DEPARTMENT
ROANOKE VIRGINIA

EPPERLEY AVENUE, N.W.
GREENLAWN AVENUE TO
WILLIAMSON ROAD

SCALE: 1" = 100'

DATE: 5/31/96

DIST. MAP: 216

PLAN NO: 96-05

6/3/96
DIRECTOR UTILITIES & OPERATIONS
William F. Clark 4/3/96

MANAGER UTILITY LINE SERVICES