


HARTSOOK BLEW SE

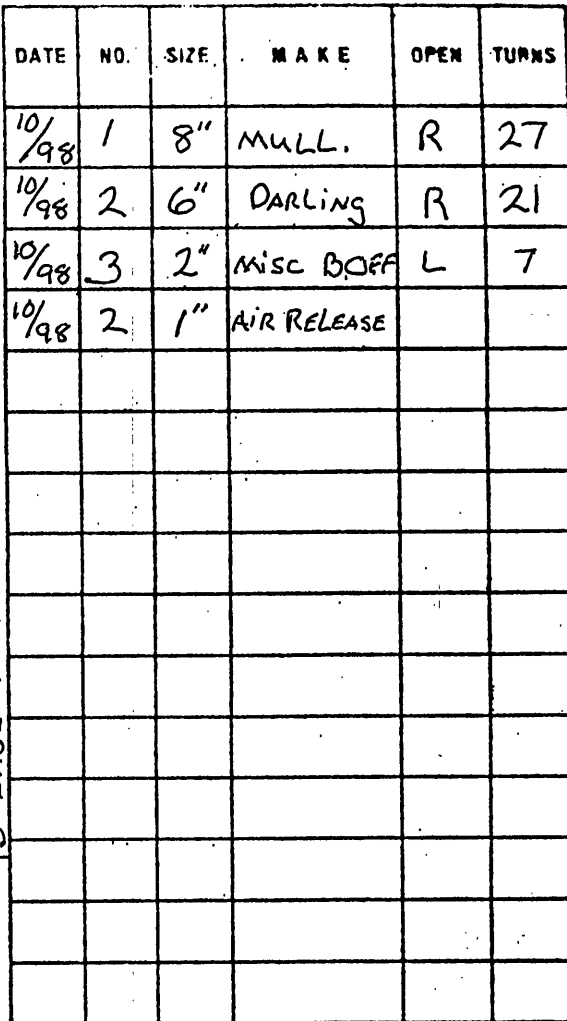

700 Block of HART SOAK BLVD.
SE

SEC. MAP. 448

DATE 10-6-98 PAGE NO. _____