


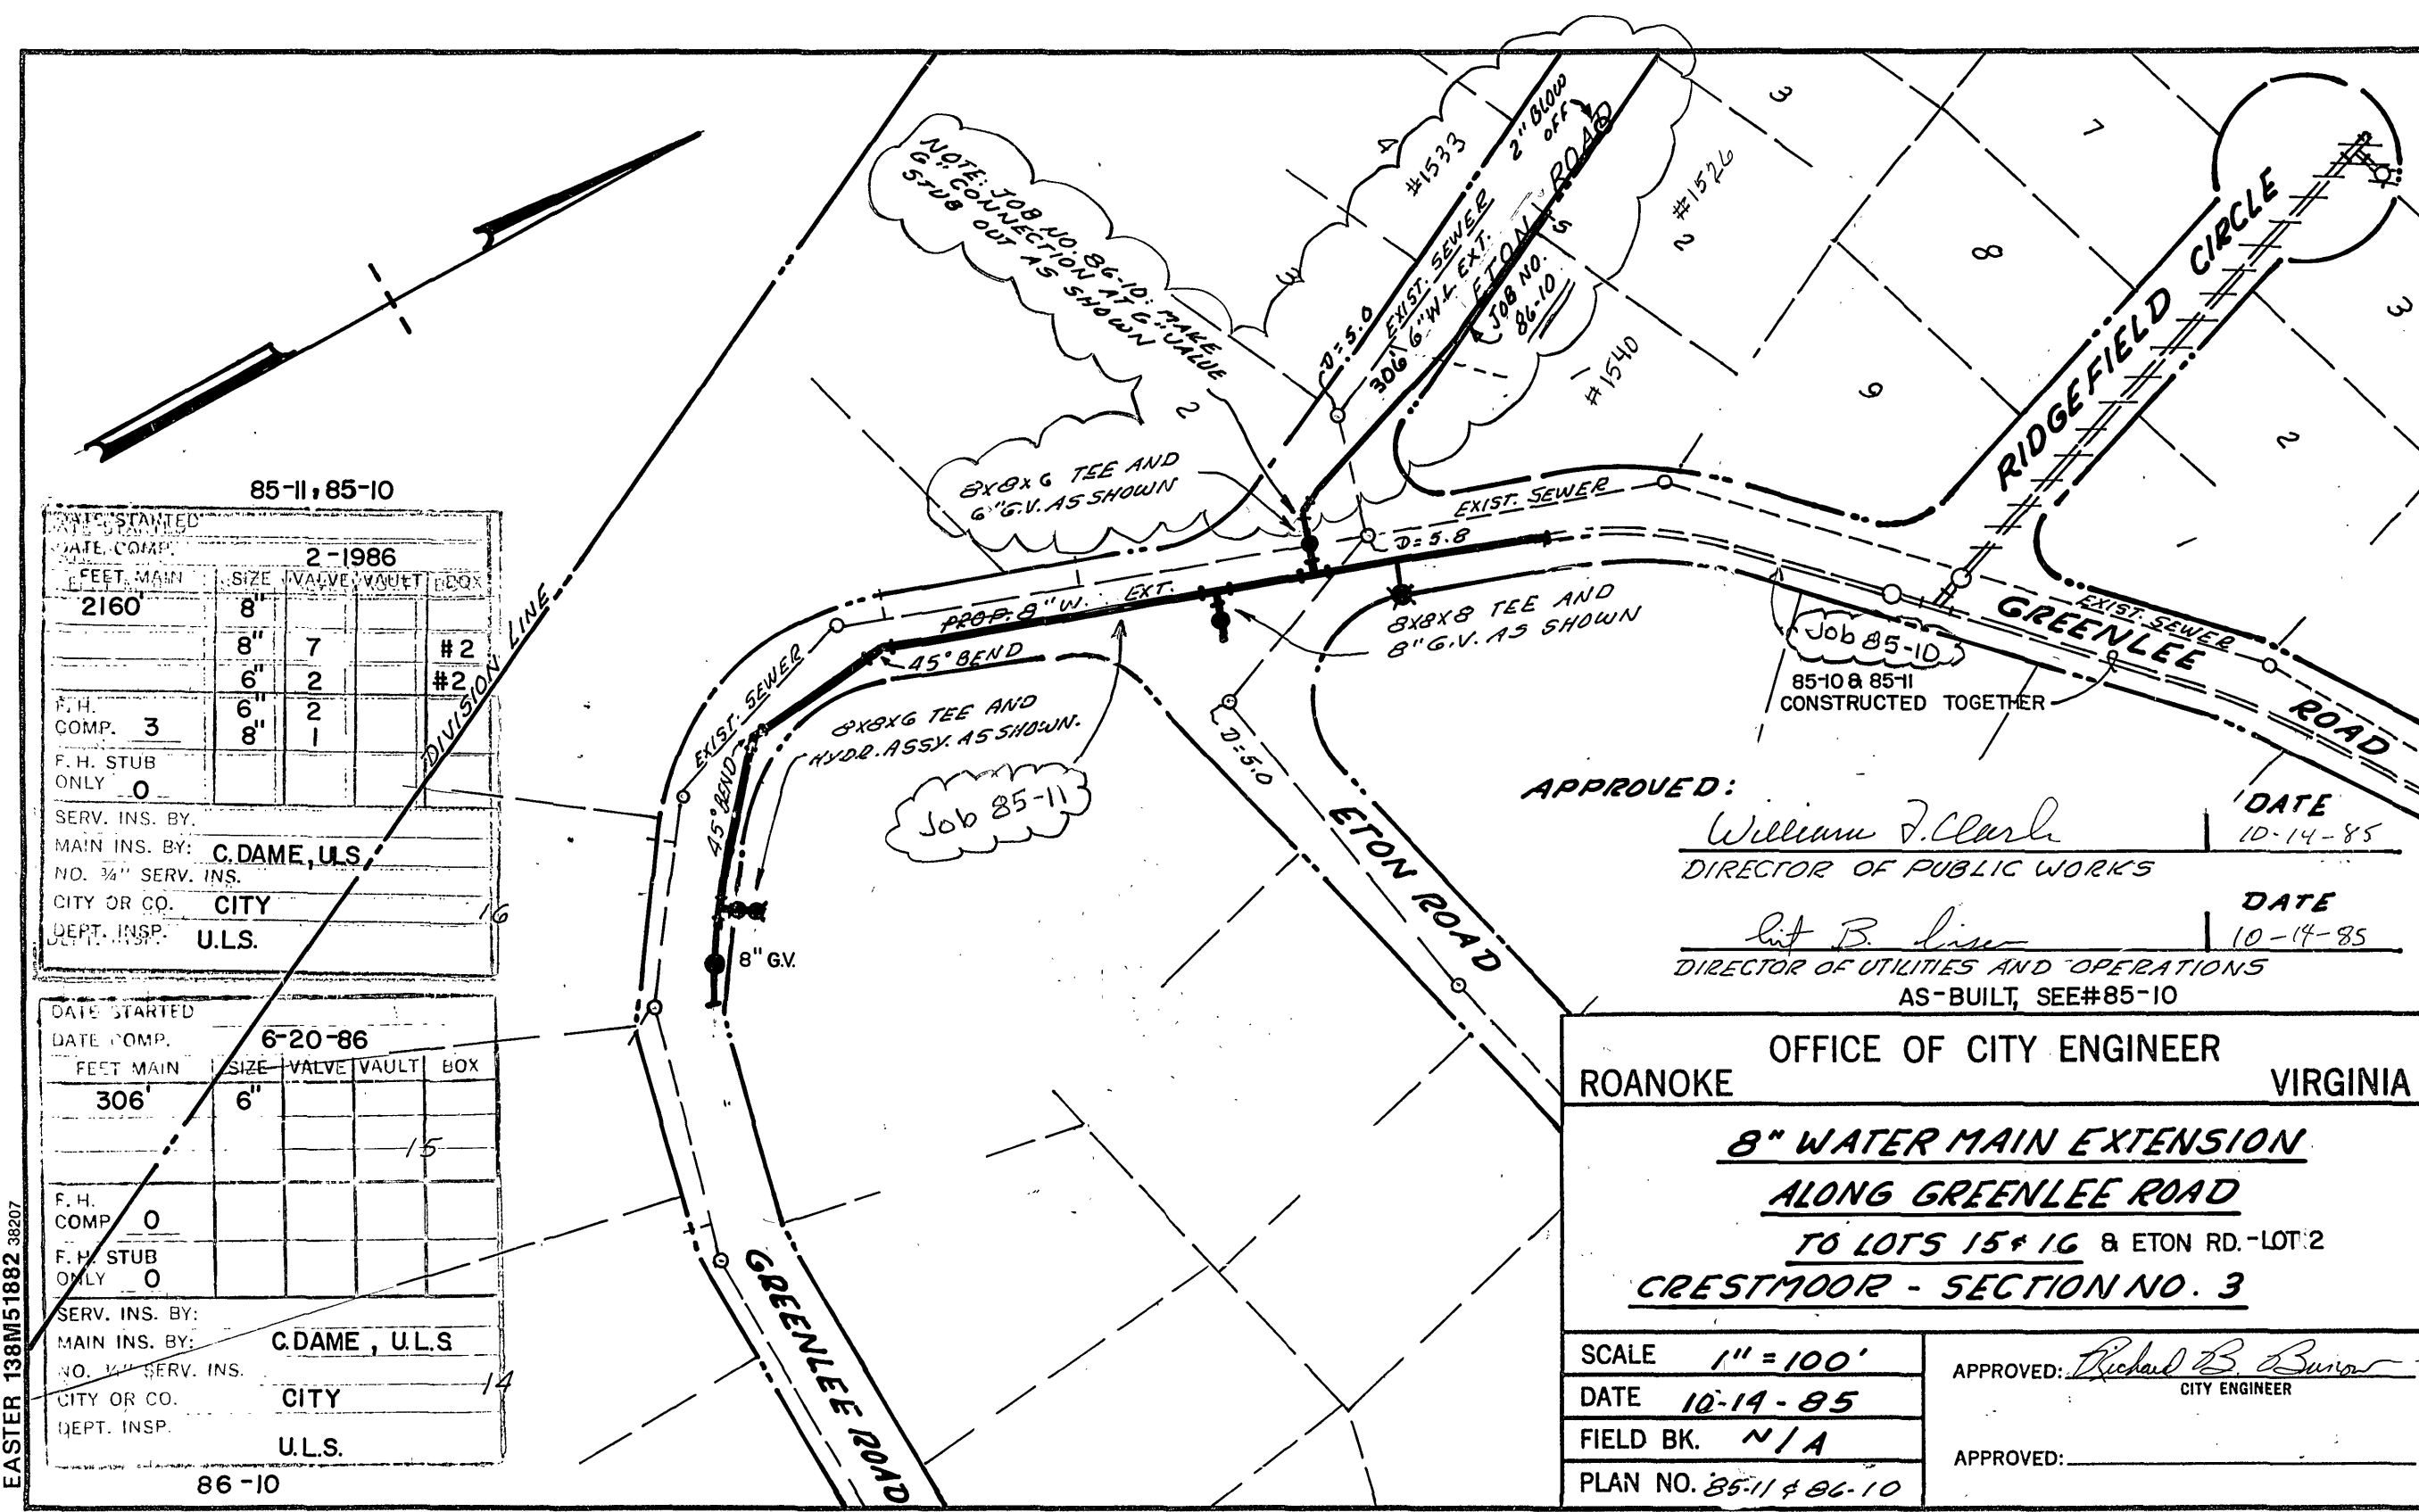

85-11, 85-10

DATE STARTED				
DATE COMP. 2-1986				
FEET MAIN	SIZE	VALVE	VAULT	BOX
2160	8"			#2
	8"	7		
	6"	2		#2
F.H. COMP. 3	6"	2		
F.H. STUB ONLY 0	8"	1		
SERV. INS. BY.				
MAIN INS. BY: C.DAME, U.S.				
NO. 3/4" SERV. INS.				
CITY OR CO. CITY				
DEPT. INSP. U.S.				

DATE STARTED				
DATE COMP. 6-20-86				
FEET MAIN	SIZE	VALVE	VAULT	BOX
306'	6"			
				15
F.H. COMP. 0				
F.H. STUB ONLY 0				
SERV. INS. BY.				
MAIN INS. BY: C.DAME, U.S.				
NO. 1/2" SERV. INS.				
CITY OR CO. CITY				
DEPT. INSP. U.S.				

86-10

APPROVED: William J. Clark DATE 10-14-85
DIRECTOR OF PUBLIC WORKS

Ed B. Liser DATE 10-14-85
DIRECTOR OF UTILITIES AND OPERATIONS
AS-BUILT, SEE#85-10

ROANOKE OFFICE OF CITY ENGINEER VIRGINIA

**8" WATER MAIN EXTENSION
ALONG GREENLEE ROAD
TO LOTS 15 & 16 & ETON RD.-LOT 2
CRESTMoor - SECTION NO. 3**

SCALE 1" = 100'
DATE 10-14-85
FIELD BK. N/A
PLAN NO. 85-11 & 86-10

APPROVED: Richard B. Buisson
CITY ENGINEER

APPROVED: _____

EASTER 138M51882 38207