


VA TRUCK CENTER WATERLINE
REALIGNMENT



BASEMAP

Rev	Date	By	Description
1	7/12/24	RC	Red line in-field design
2	7/11/24	RC	Project Completion

Designed: WWA
Drawn: AJH
Checked: NSS, AJC
Approved:
Date: JUNE 2024
Project: WCIP 456

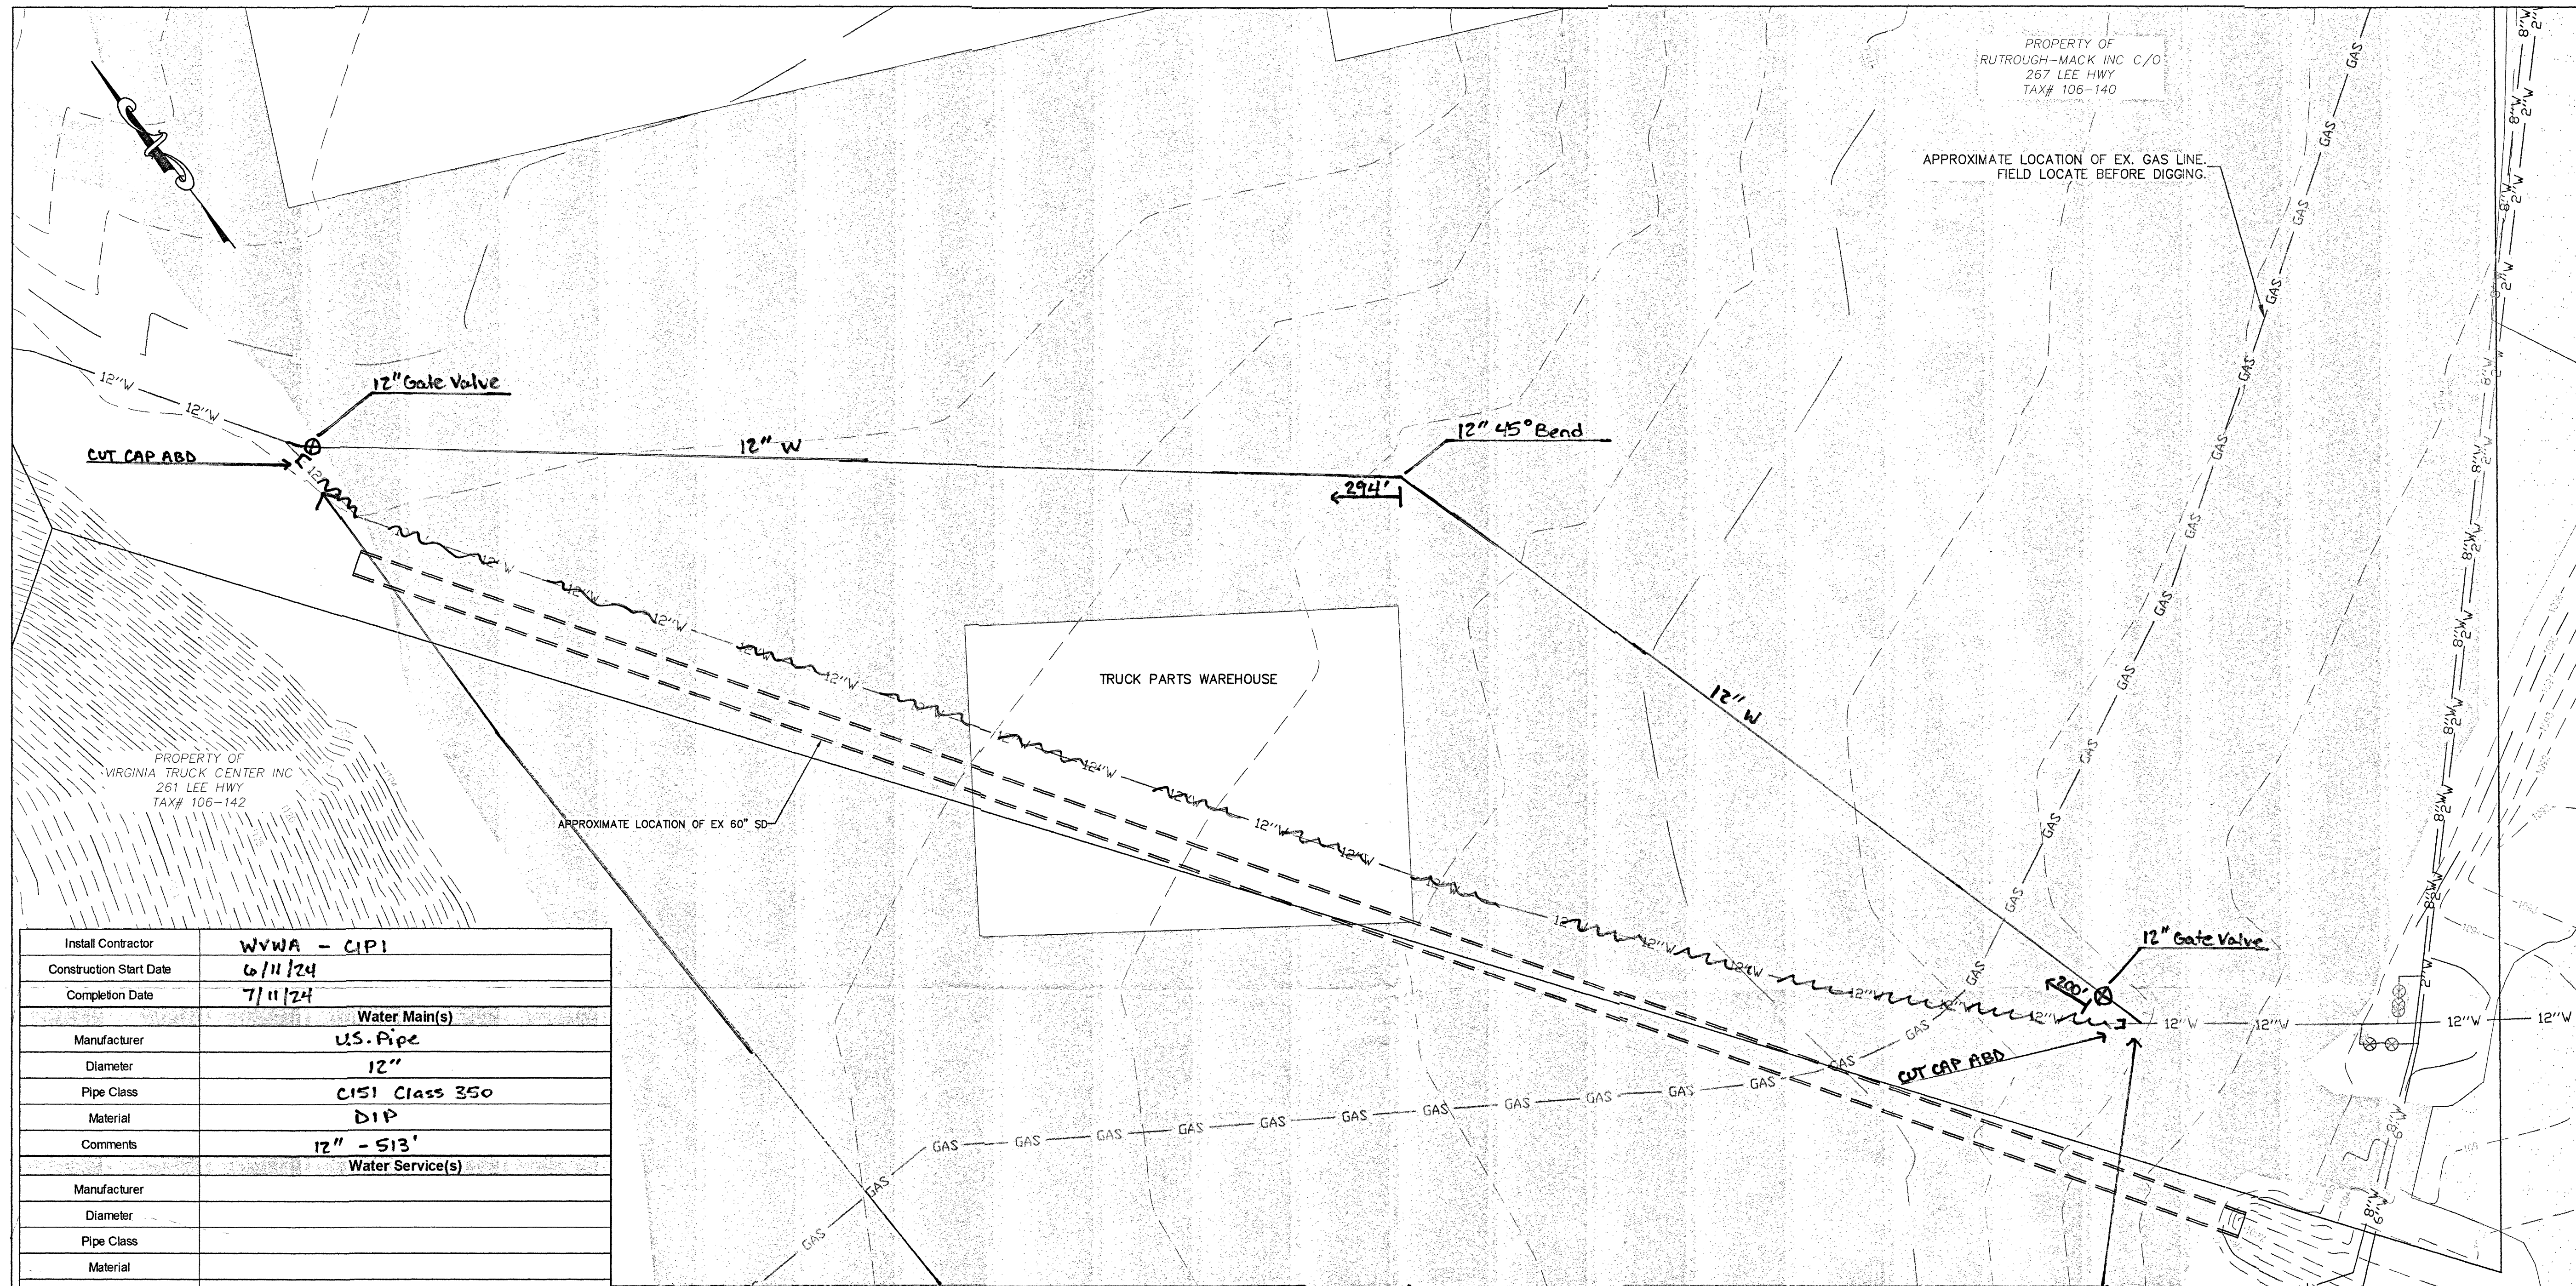

Install Contractor	WVWA - CIP1	
Construction Start Date	6/11/24	
Completion Date	7/11/24	
Water Main(s)		
Manufacturer	U.S. Pipe	
Diameter	12"	
Pipe Class	C151 Class 350	
Material	DIP	
Comments	12" - 513'	
Water Service(s)		
Manufacturer		
Diameter		
Pipe Class		
Material		
Comments		
Water Valve(s) 1		Water Valve(s) 2
Manufacturer	AFC	
Valve Type	Gate	
Diameter	12"	
Direction to Open / Turns to Close	Right to Close	
Comments	2 - 12" GV	
Water Valve(s) 3		Water Valve(s) 4
Manufacturer		
Valve Type		
Diameter		
Direction to Close / Turns to Close		
Comments		
Hydrant(s)		
Authority ID #		
Manufacturer		
Model		
Cast Date		
Static Pressure		
Comments		

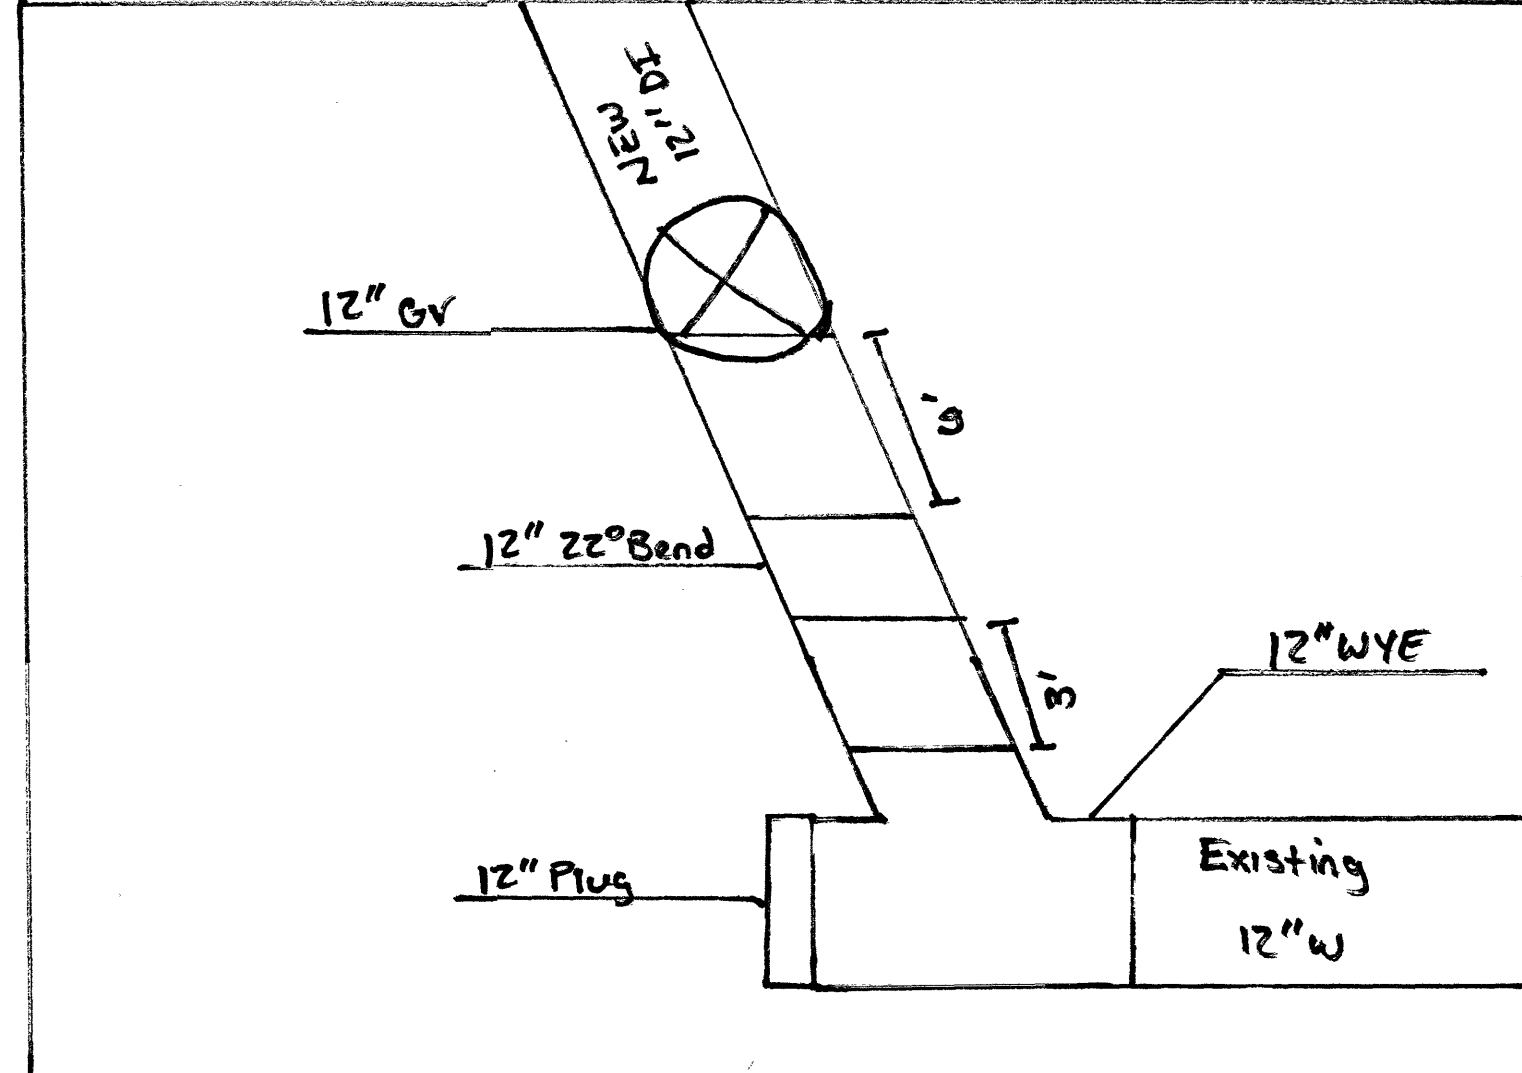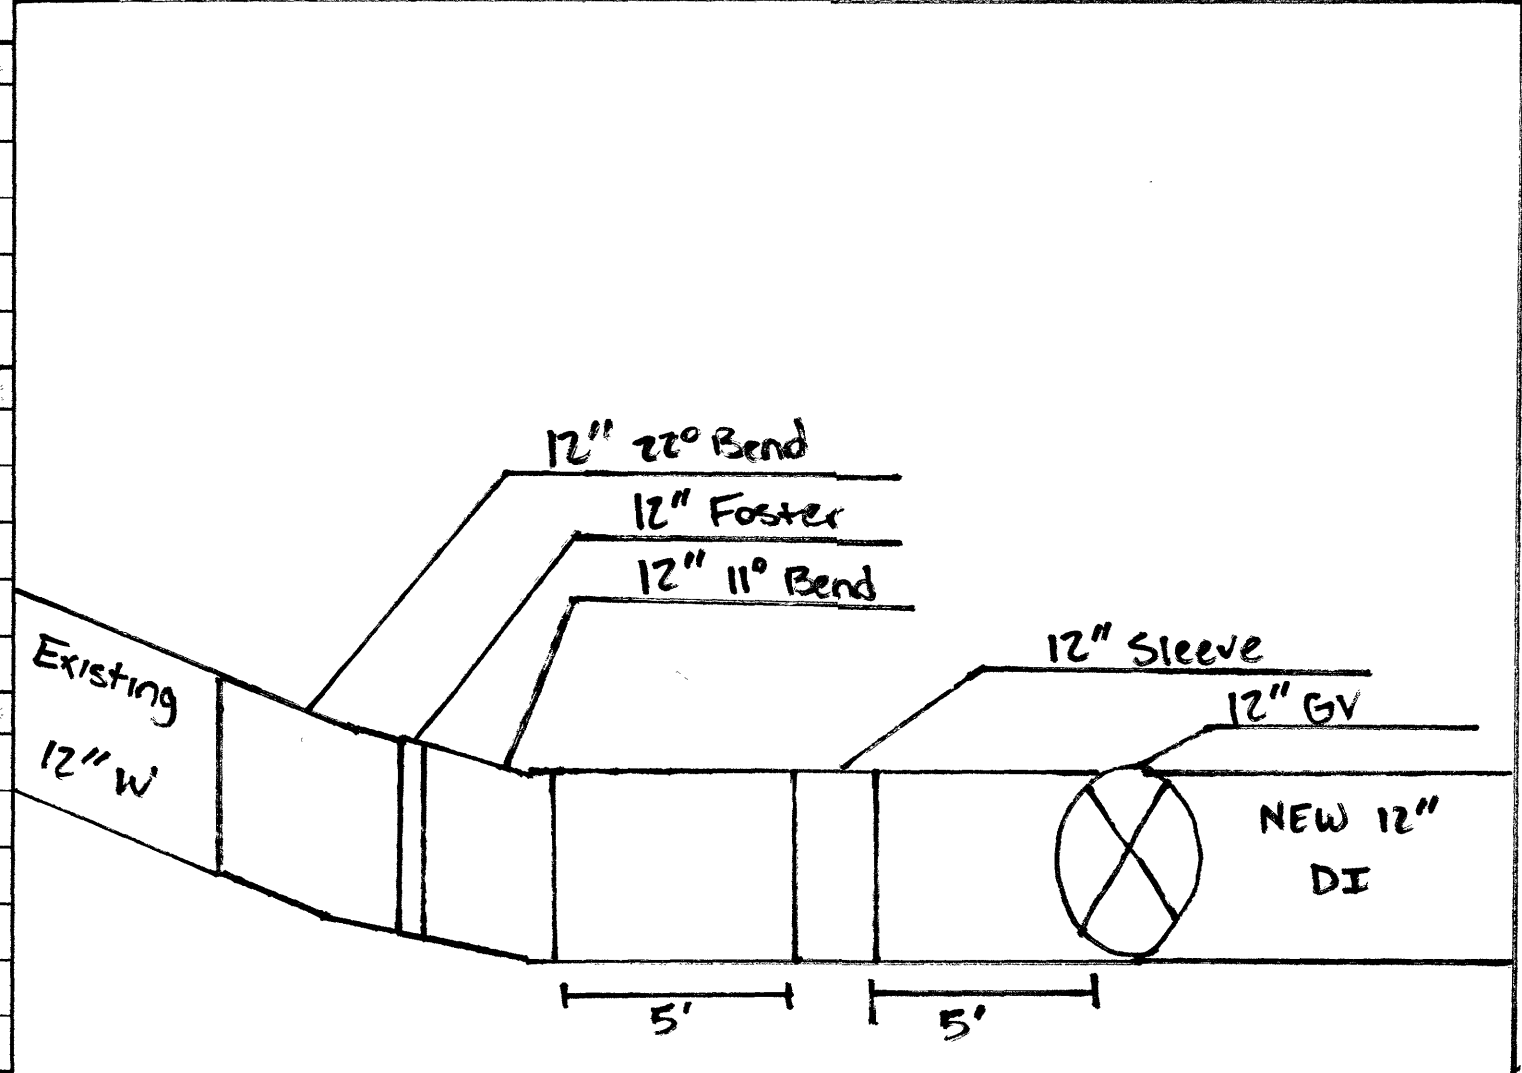

GENERAL NOTES:
1. PROPERTY LINES SHOWN ON THIS PAGE ARE BASED ON GIS DATA AND HAVE NOT BEEN FIELD SURVEYED.
2. ANY FIELD CHANGES THAT AFFECT A DESIGN STANDARD SHALL BE APPROVED BY THE ENGINEER OF RECORD.