


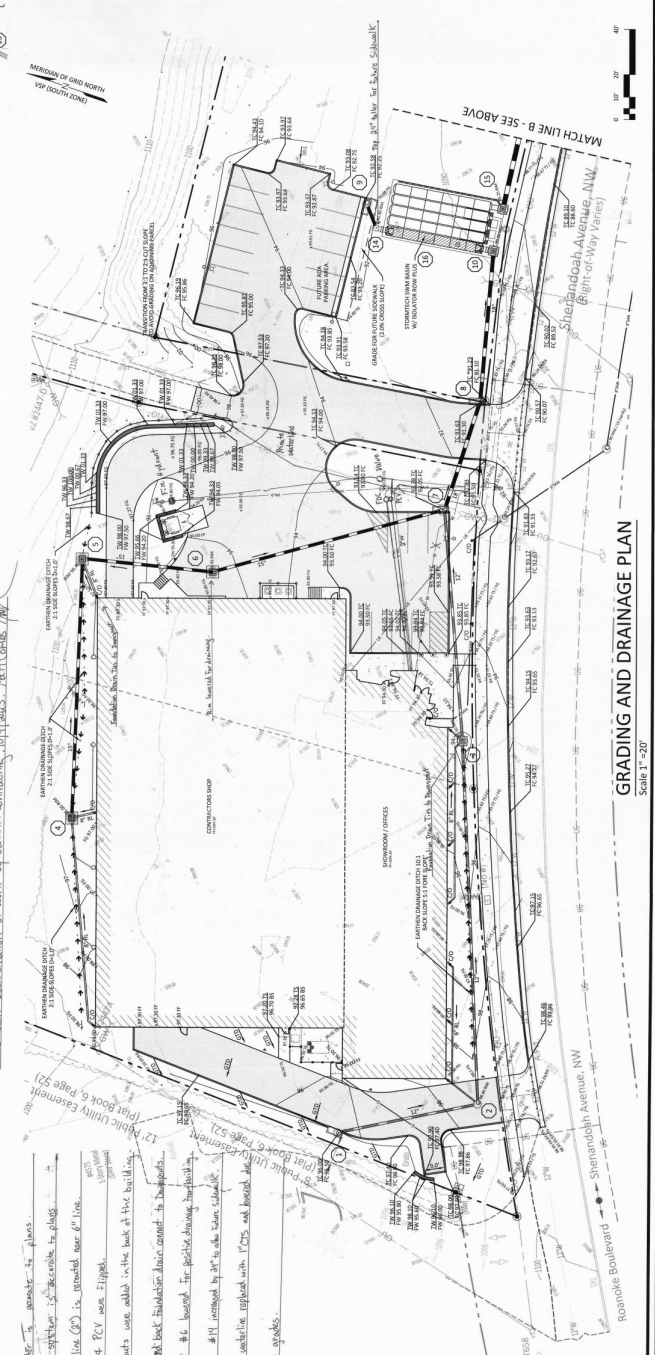

10. It is desired to place
 a section of the existing 16" dia.
 line (C-2) is oriented near the line
 at P.C. was flipped
 and
 the back foundation drain cannot be installed
 as it is required by 34" to the drain calculated
 the line approach with 1" CTS and located the
 grades.

[illegible]