





As-Built Sanitary Sewer Table					
LINE	STRUCTURE	MANHOLE	MANHOLE	MANHOLE	MANHOLE
1	Sanitary Sewer Manhole	1094.69	1093.00	1091.94	1091.94
2	Sanitary Sewer Manhole	1094.69	1093.00	1091.94	1091.94
3	Sanitary Sewer Manhole	1094.69	1093.00	1091.94	1091.94
4	Sanitary Sewer Manhole	1094.69	1093.00	1091.94	1091.94
5	Sanitary Sewer Manhole	1094.69	1093.00	1091.94	1091.94
6	Sanitary Sewer Manhole	1094.69	1093.00	1091.94	1091.94
7	Sanitary Sewer Manhole	1094.69	1093.00	1091.94	1091.94
8	Sanitary Sewer Manhole	1094.69	1093.00	1091.94	1091.94
9	Sanitary Sewer Manhole	1094.69	1093.00	1091.94	1091.94
10	Sanitary Sewer Manhole	1094.69	1093.00	1091.94	1091.94

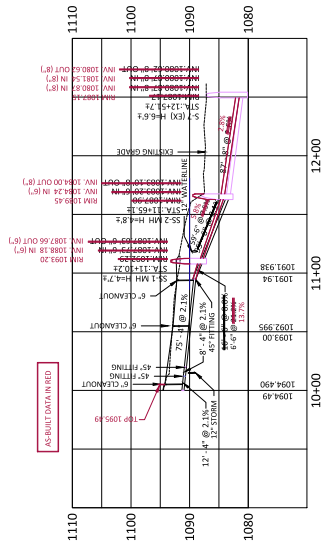

WATER AND SANITARY SEWER AS-BUILT

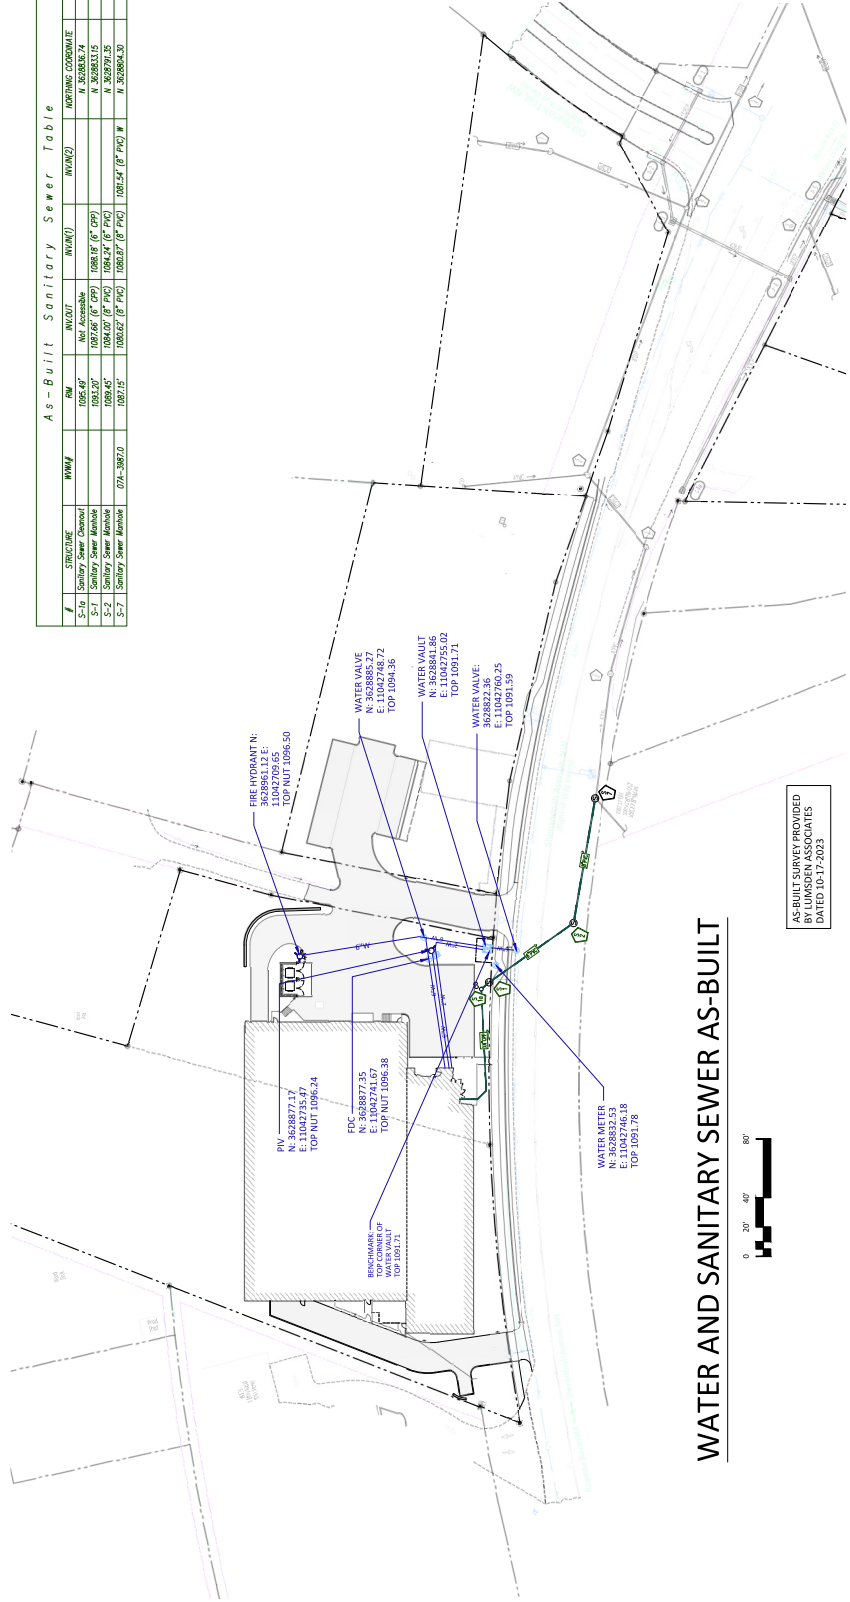

AS-BUILT SURVEY PROVIDED
BY LUMSDEN ASSOCIATES
DATED 10-17-2023