


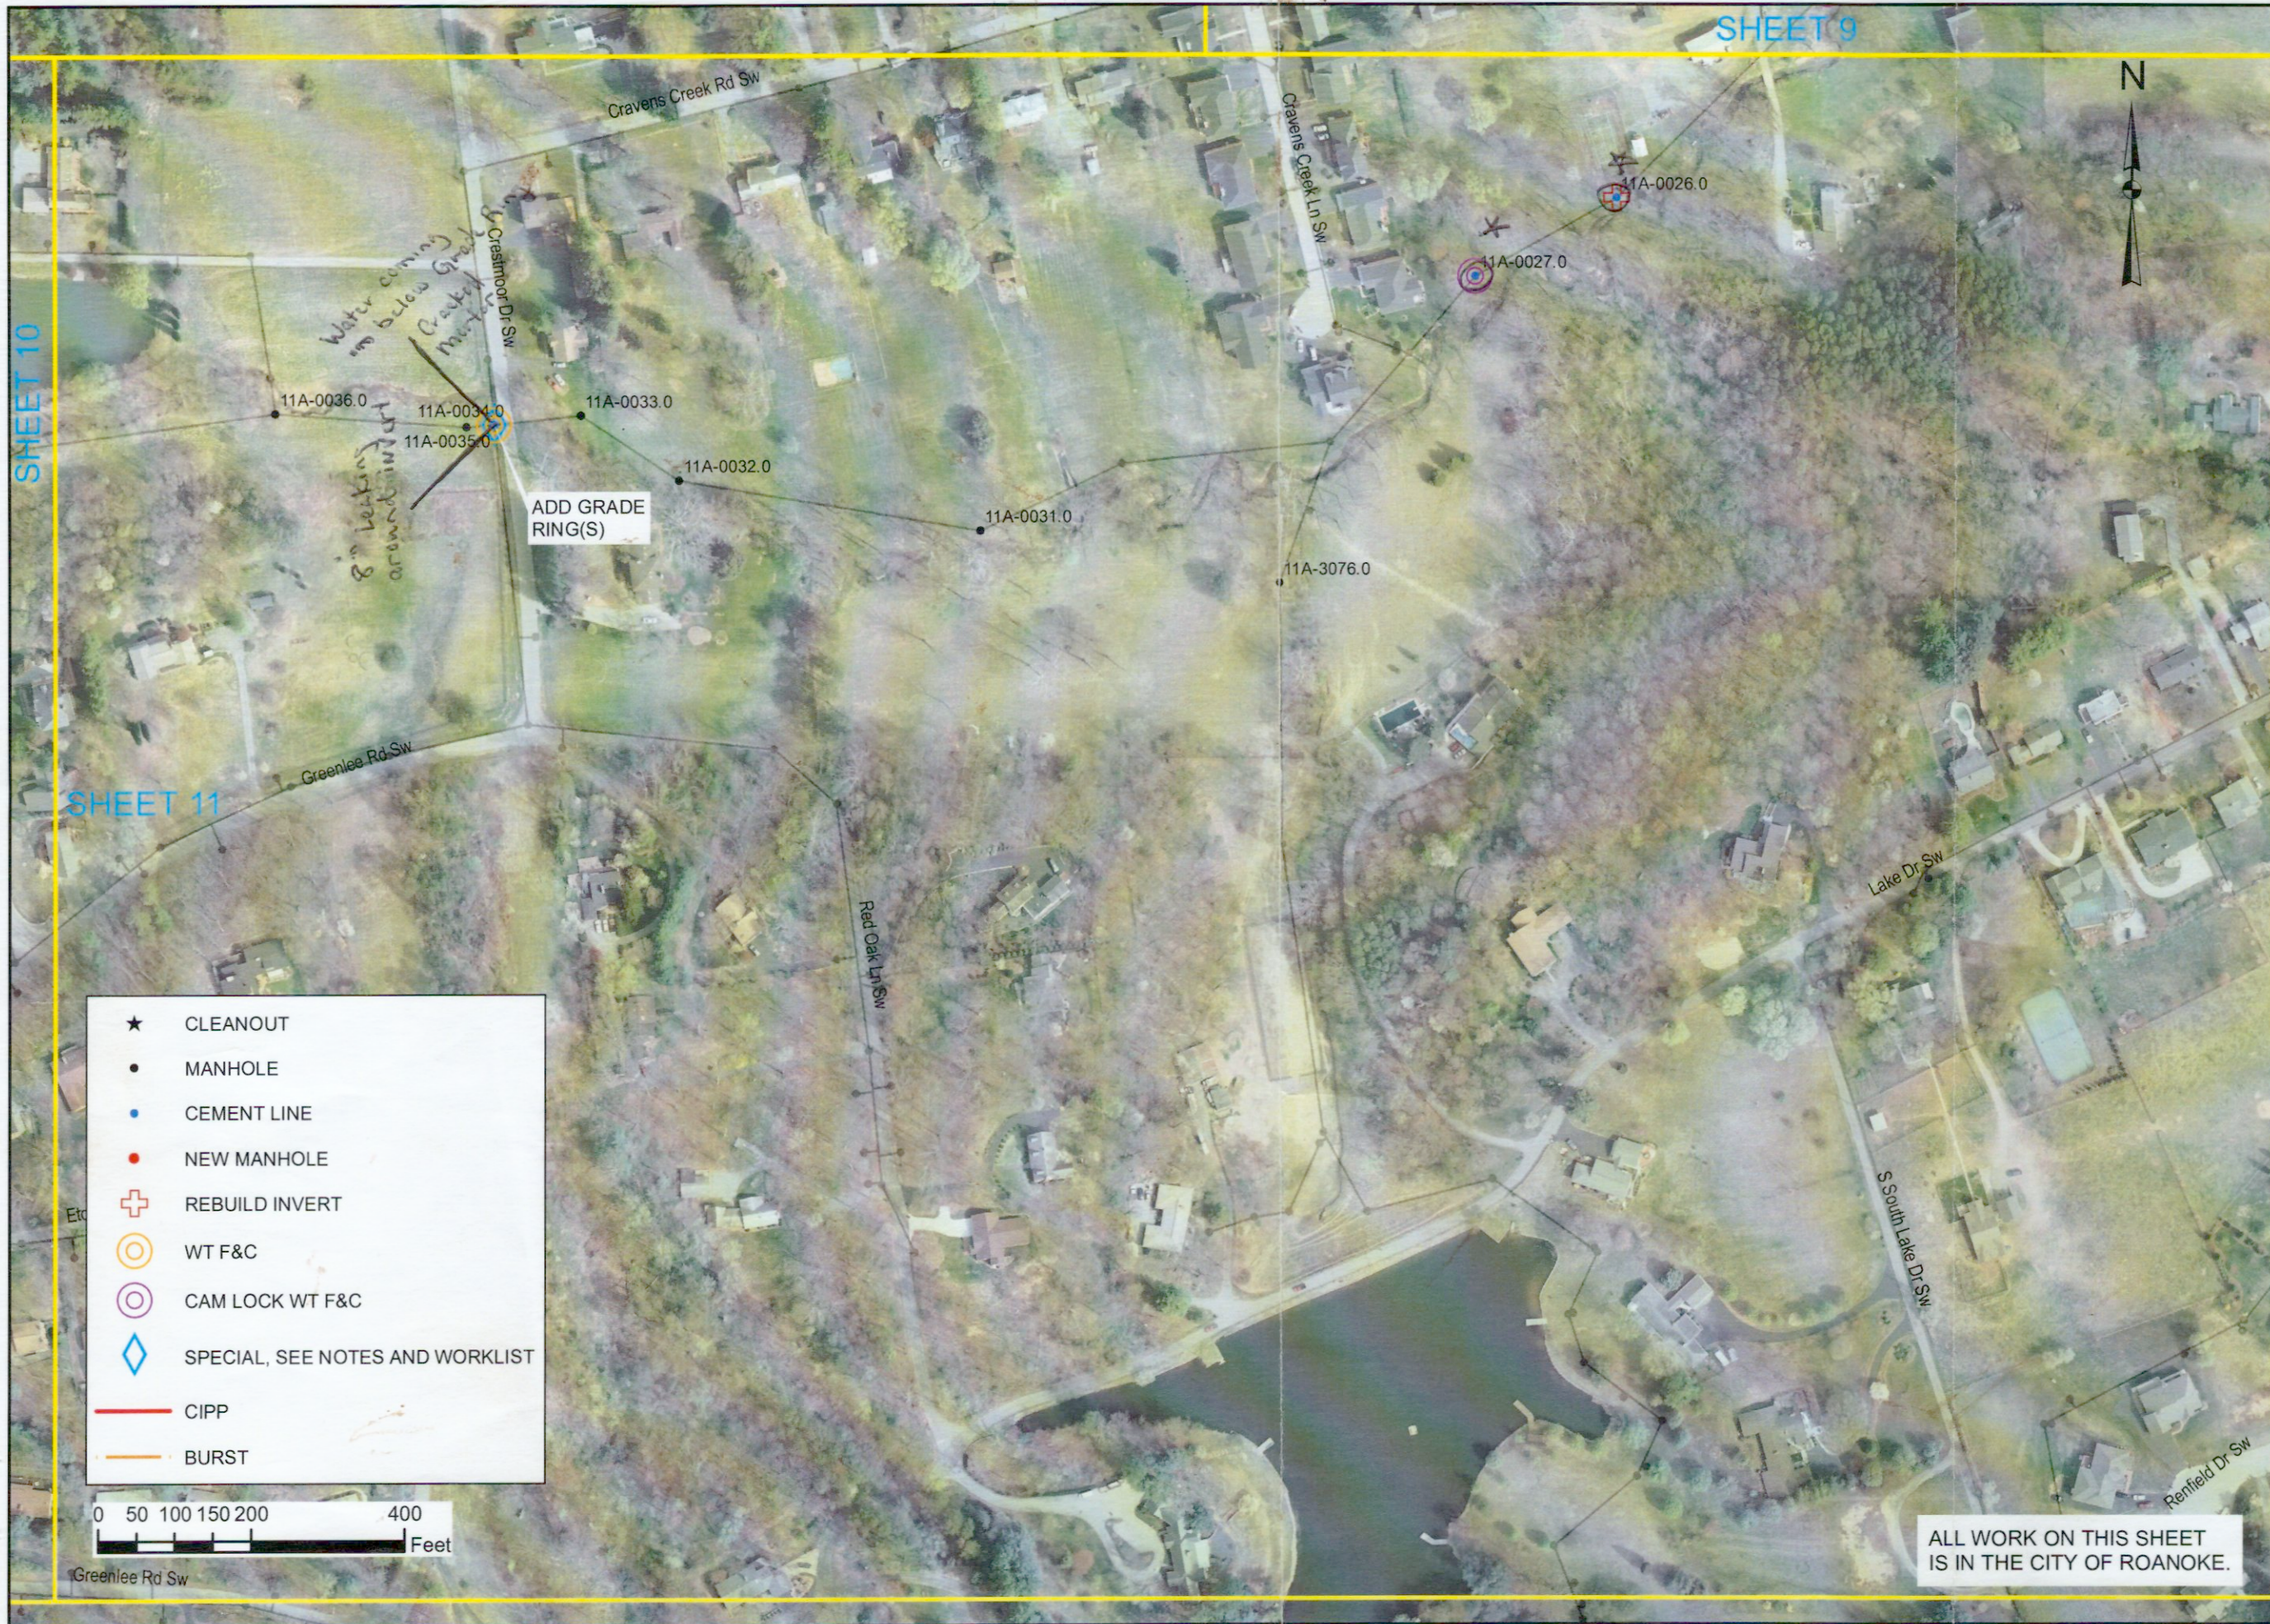

CREEK CROSSING MANHOLES
WESTERN VIRGINIA
WATER AUTHORITY
FY2011 VCWRLF COLLECTION
SYSTEM PROJECTS
CONTRACTS 1A & 1B REHABILITATION

DESIGNED BY:	JSB
DRAWN BY:	CDH
CHECKED BY:	DBH
SCALE:	AS SHOWN
DATE:	FEB 2012
PROJECT NUMBER:	23184

SHEET 11

Drawing Copyright © 2011

CIA

1116 South Main Street • Blacksburg, VA 24060-5548
Main: (540) 552-5548 • www.ciacompanies.com

Draper Aden Associates

Engineering • Surveying • Environmental Services

Blacksburg, VA
2206 South Main Street
Blacksburg, VA 24060
540-552-0444 • Fax: 540-552-0391
www.daa.com

Richmond, VA
Charlottesville, VA
Hampton Roads, VA