


- ★ CLEANOUT
- MANHOLE
- CEMENT LINE
- NEW MANHOLE
- + REBUILD INVERT
- WT F&C
- CAM LOCK WT F&C
- ◇ SPECIAL, SEE NOTES AND WORKLIST
- CIPP
- BURST

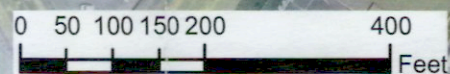

LATERALS TO BE REINSTATED OR GROUTED ARE NOT SHOWN ON THE PLANS. ALL WORK ON THIS SHEET IS IN THE CITY OF ROANOKE.

Drawing Copyright © 2011
CIA
1116 South Main Street • Blacksburg, VA 24060-5548
Main: (540) 552-5548 • www.chacompanies.com

Draper Aden Associates
Engineering • Surveying • Environmental Services
Blacksburg, VA
2206 South Main Street
Blacksburg, VA 24060-5548
Main: (540) 552-5548 • www.daa.com

COLONIAL AVENUE
WESTERN VIRGINIA
WATER AUTHORITY
FY2011 VCWRLF COLLECTION
SYSTEM PROJECTS
CONTRACTS 1A & 1B REHABILITATION

DESIGNED BY:
JSB
DRAWN BY:
CDH
CHECKED BY:
DBH
SCALE:
AS SHOWN
DATE:
FEB 2012
PROJECT NUMBER:
23184

SHEET 15