




SHEET 10

- ★ CLEANOUT
- MANHOLE
- CEMENT LINE
- NEW MANHOLE
- + REBUILD INVERT
- WT F&C
- CAM LOCK WT F&C
- ◇ SPECIAL, SEE NOTES AND WORKLIST
- CIPP
- BURST

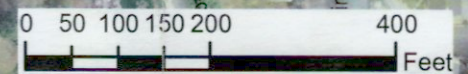

ALL WORK ON THIS SHEET IS IN THE CITY OF ROANOKE.

Drawing Copyright © 2011
CLWA
1119 South Main Street • Blacksburg, VA 24060-5548
Main: (540) 552-5548 • www.clwacompanies.com

Draper Aden Associates
Engineering • Surveying • Environmental Services
Blacksburg, VA
1000 South Main Street
Blacksburg, VA 24060
540-552-0444 Fax: 540-552-0281
www.daa.com

Richmond, VA
Charlottesville, VA
Hampton Roads, VA

CREEK CROSSING MANHOLES
**WESTERN VIRGINIA
WATER AUTHORITY**
**FY2011 VCWRLF COLLECTION
SYSTEM PROJECTS**
CONTRACTS 1A & 1B REHABILITATION

DESIGNED BY:
JSB

DRAWN BY:
CDH

CHECKED BY:
DBH

SCALE:
AS SHOWN

DATE:
FEB 2012

PROJECT NUMBER:
23184

SHEET 16