



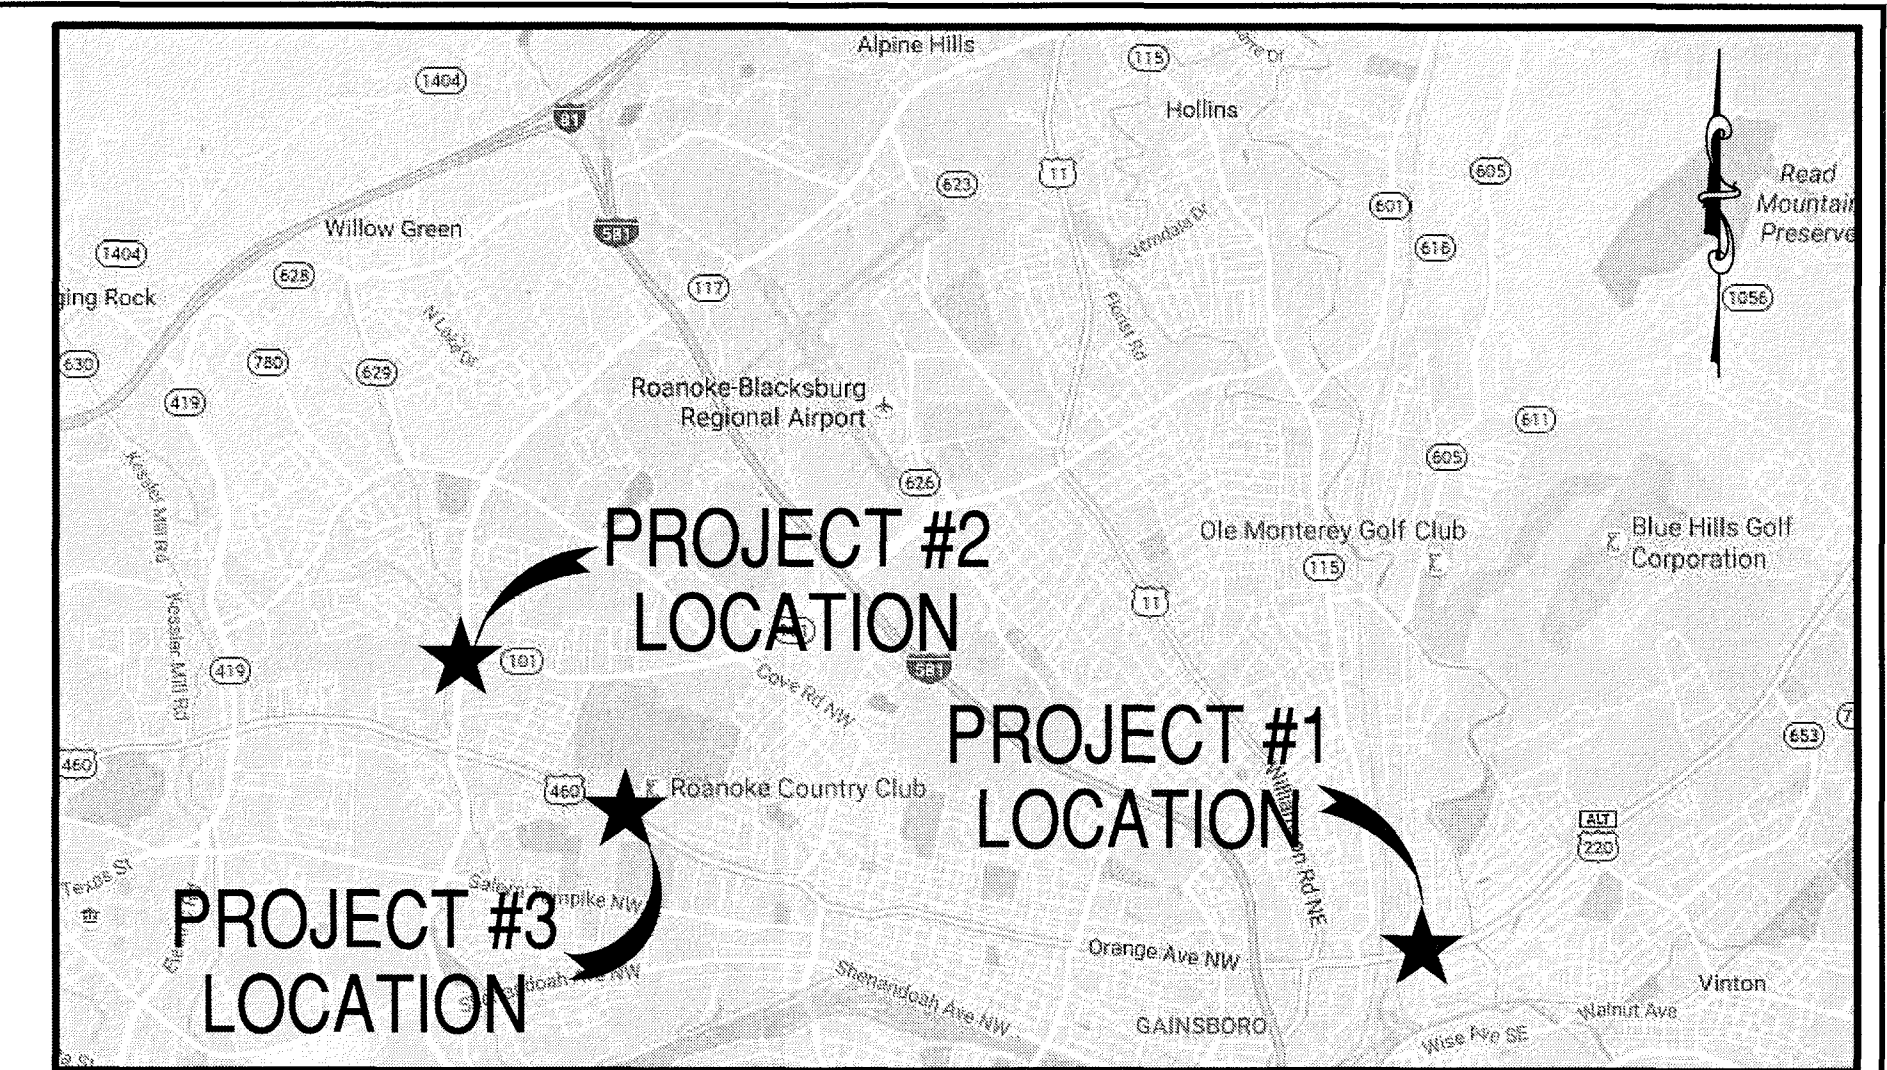

LOCATION PLAN

NO SCALE

1. ORANGE AVENUE (11TH STREET TO 13TH STREET)
2. PETERS CREEK ROAD & HERSHBERGER ROAD
3. MELROSE AVENUE & COUNTRY CLUB DRIVE

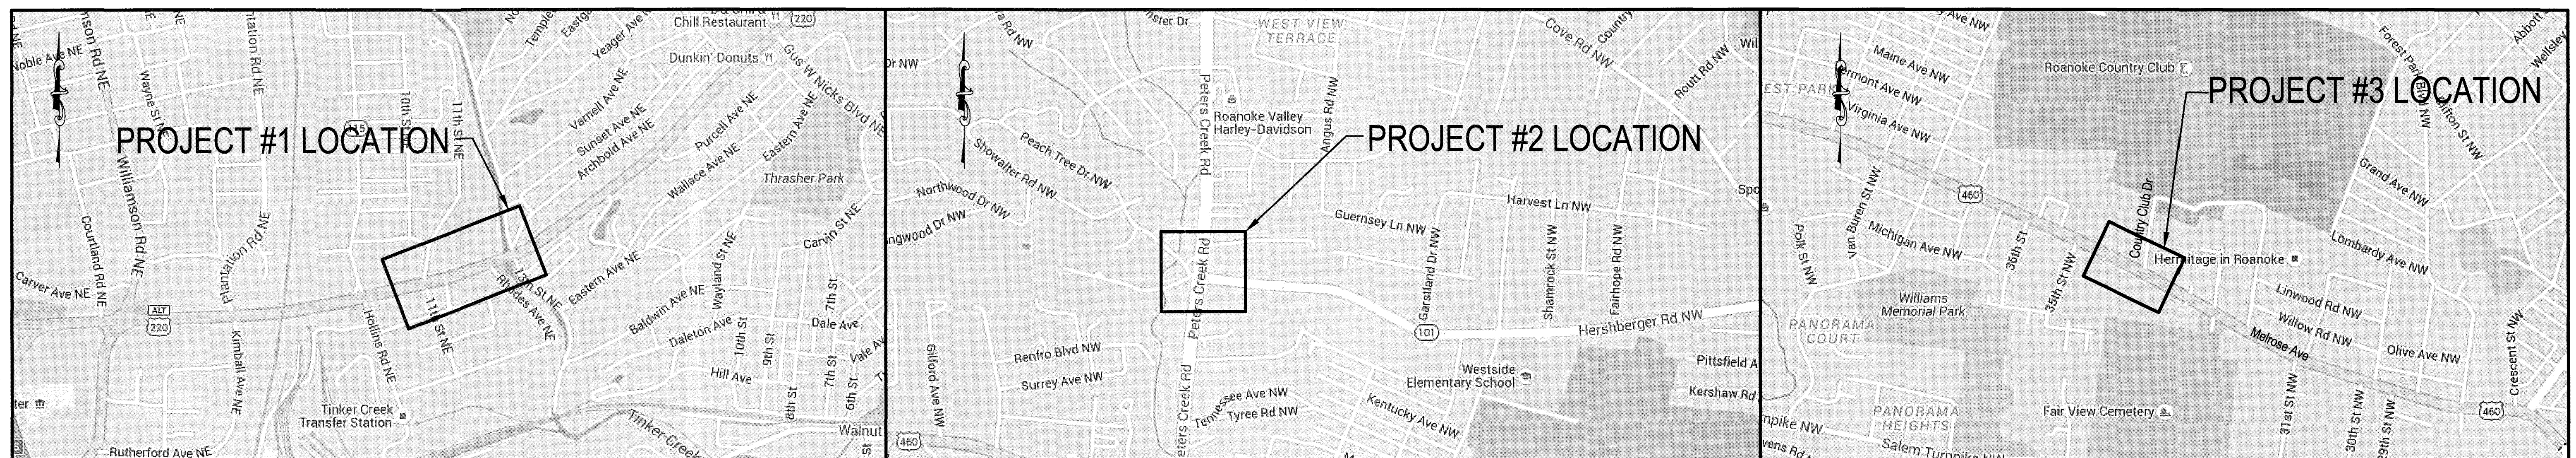

Contractor: E.C. PACE
Inspector: Brian Whitenuck

Materials: 12" HOPE - Flying "W" 4" DIP - US Pipe
Pipe → 12" DIP - US Pipe
 8" DIP - US Pipe
 6" DIP - US Pipe

Hydrants - ^{model} ADV-B84B-5

Services - 1" Blue poly Endot
3/4" Blue poly Endot

Valves - 12" - AFC - Right handed - 36 Turns
8" - AFC - Right handed - 24 Turns
6" - AFC - Right handed - 18 Turns
4" - AFC - Right handed - 12 Turns

VICINITY MAPS


NO SCALE

OCTOBER 2016

AS-Built

Earl Smith

APPROVED FOR CONSTRUCTION

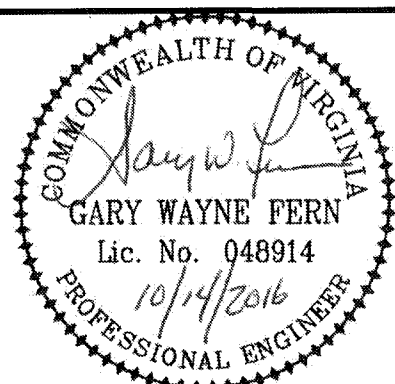

Whitman, Requardt & Associates, LLP
1700 Kraft Dr. Suite 1200, Blacksburg, VA 24060

WESTERN VIRGINIA WATER AUTHORITY
601 South Jefferson Street, Suite 300
Roanoke, Virginia 24011

DES:	PJM
DRAWN:	JES
CHECK:	GWF
DATE:	10/14/16

SCALE:	N/A
HORIZ:	N/A
VERT:	N/A

2016 12-INCH WATER MAIN REPLACEMENTS

1. ORANGE AVENUE (11TH STREET TO 13TH STREET)
2. PETERS CREEK ROAD & HERSHBERGER ROAD
3. MELROSE AVENUE & COUNTRY CLUB DRIVE

COVER SHEET

REV	DATE	DESCRIPTION
	DRAWING	SHEET
	G-1	1

Inspector: Brian Whitehurst

2016 12" WATERMAIN Replacements/Earl Smith