



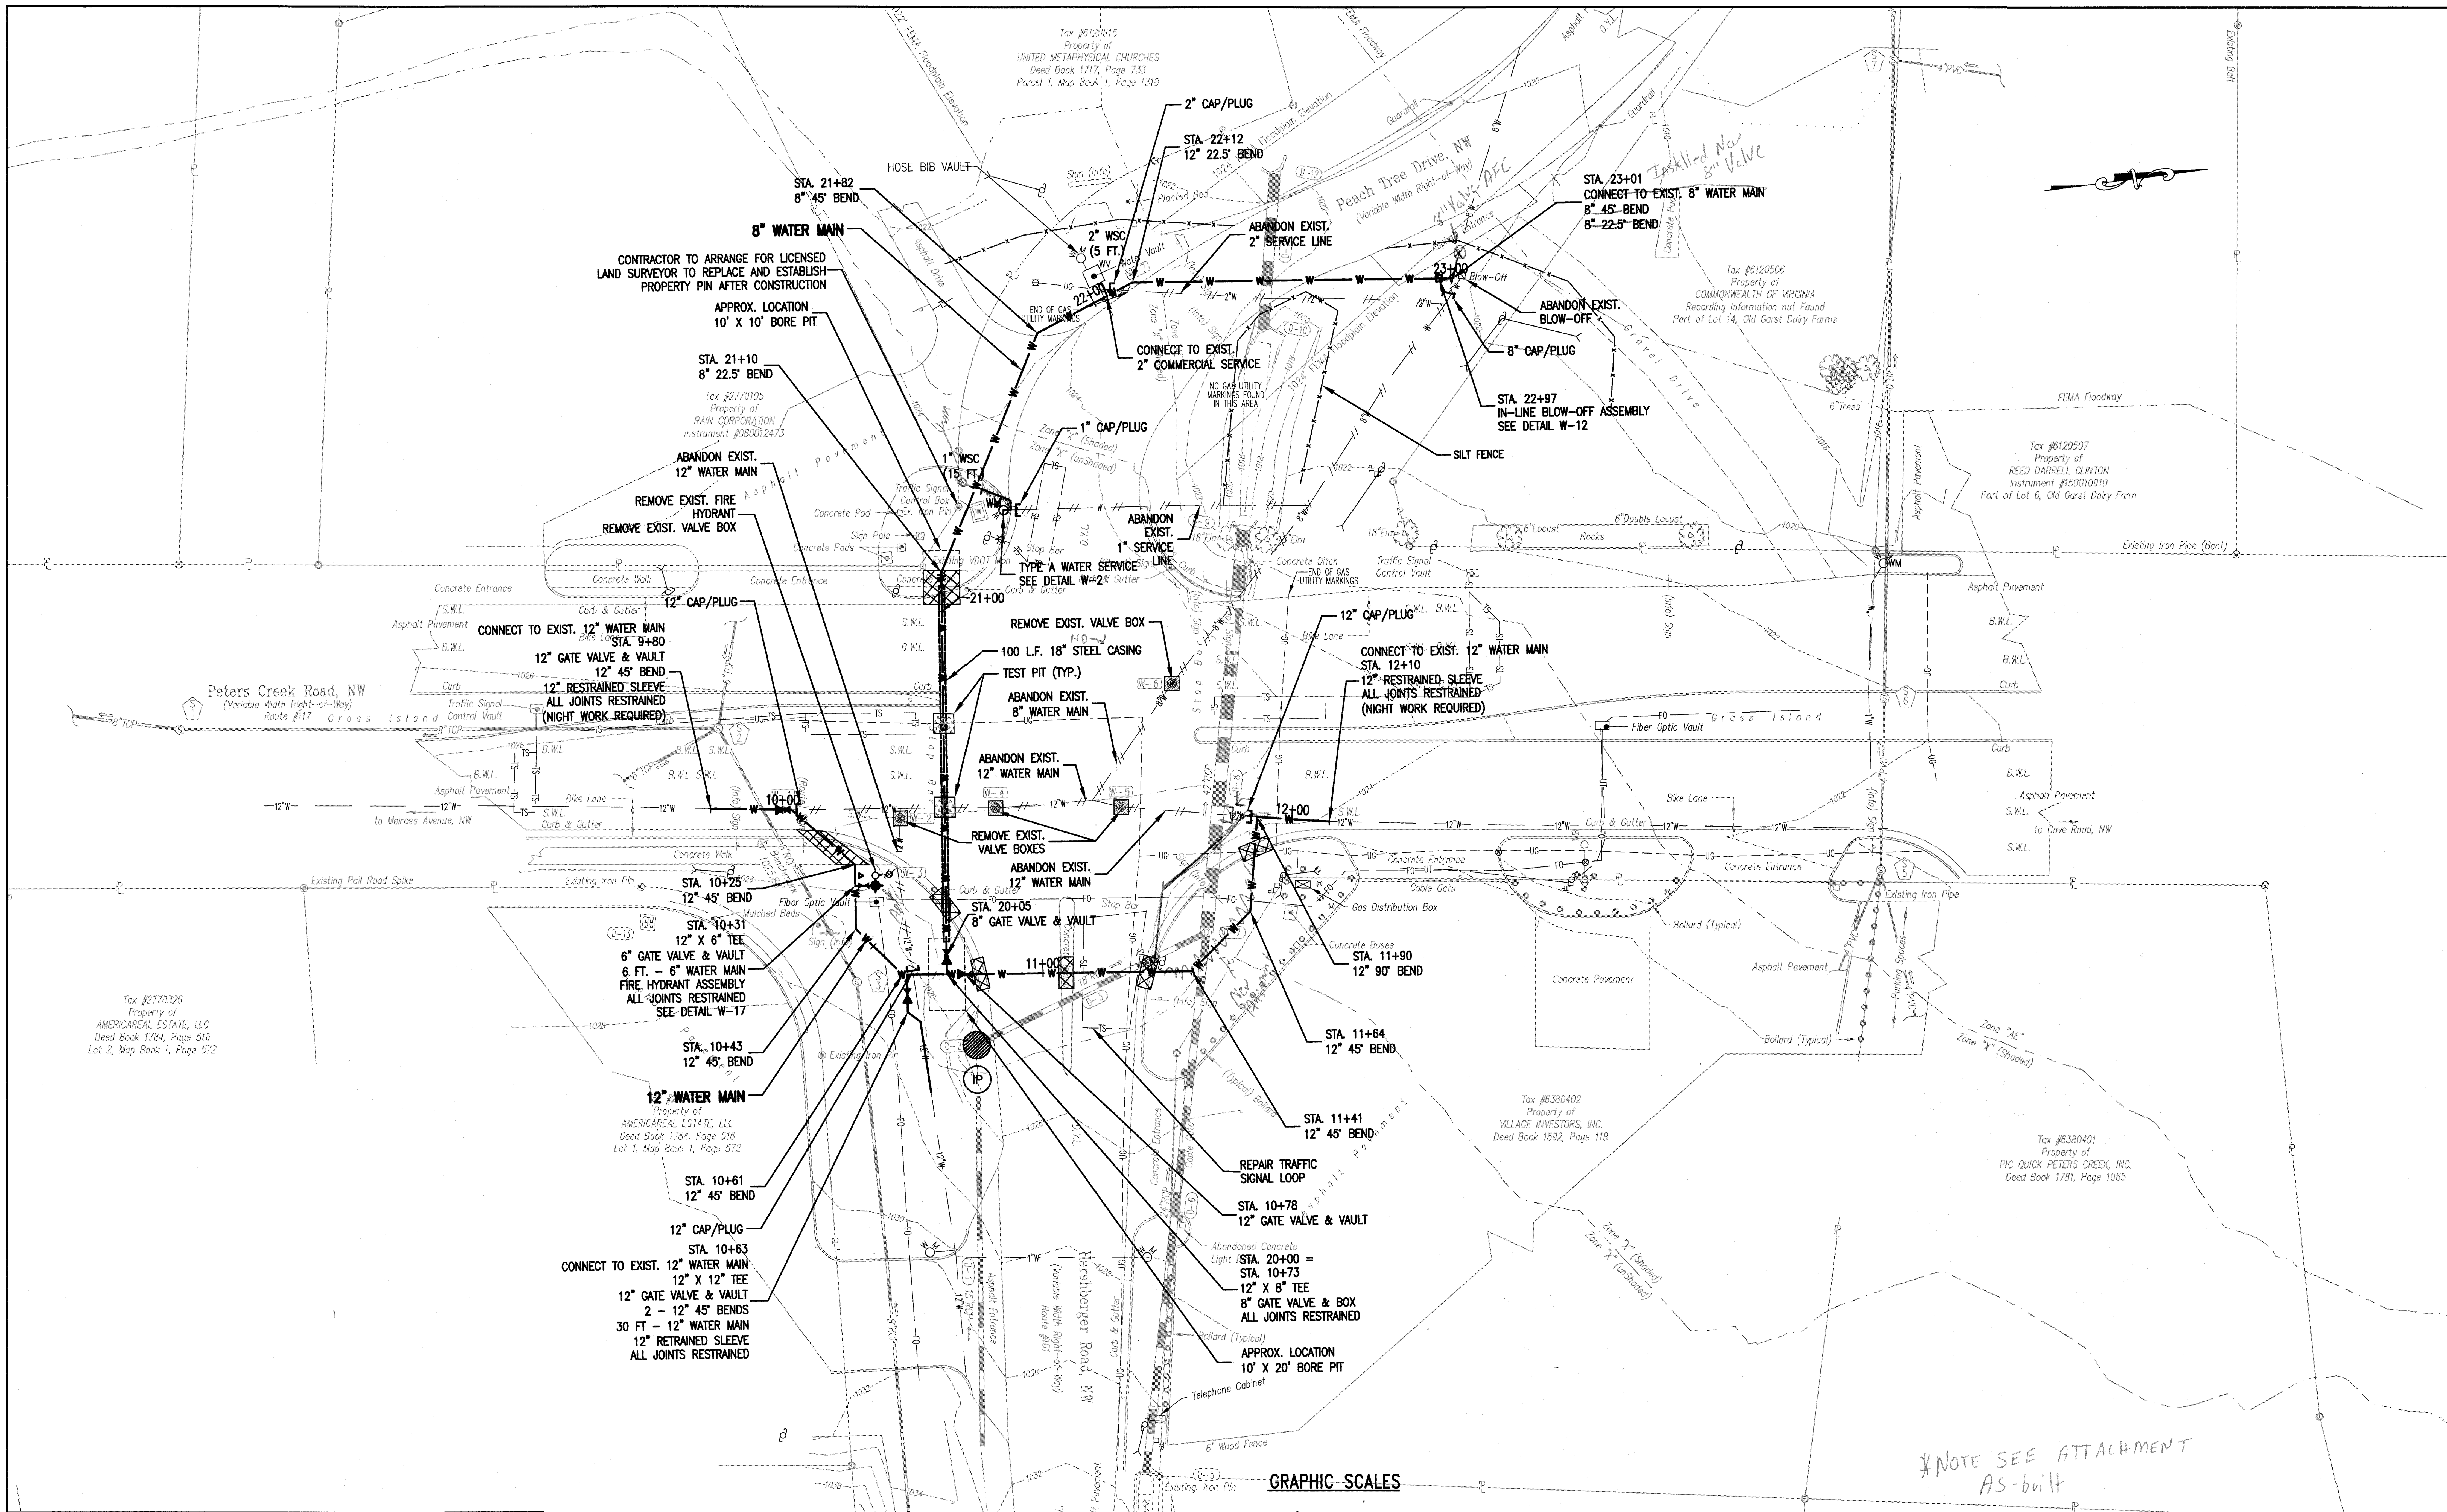

*NOTE SEE ATTACHMENT
AS-BUILT

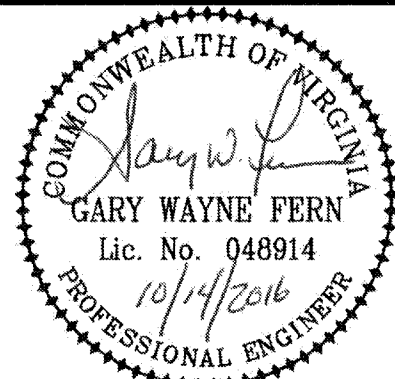

WESTERN VIRGINIA WATER AUTHORITY
601 South Jefferson Street, Suite 300
Roanoke, Virginia 24011

DES: PJM
DRAWN: JES
CHECK: GWF
DATE: 10/14/16

SCALE: AS SHOWN
HORIZ: 1" = 20'
VERT: N/A

2016 12-INCH WATER MAIN REPLACEMENTS
1. ORANGE AVENUE (11TH STREET TO 13TH STREET)
2. PETERS CREEK ROAD & HERSHERBERGER ROAD
3. MELROSE AVENUE & COUNTRY CLUB DRIVE

2. PETERS CREEK ROAD & HERSHERBERGER ROAD
PROPOSED WATER MAIN PLAN

DRAWING
2-2

SHEET
12

REV	DATE	DESCRIPTION