

# CONTRACT 1 - 2016 SANITARY SEWER REHABILITATION

WESTERN VIRGINIA WATER AUTHORITY  
ROANOKE, VA

DRAWING COPYRIGHT 2016


**CHIA**




WESTERN VIRGINIA  
WATER AUTHORITY

WESTERN VIRGINIA  
WATER AUTHORITY

ROANOKE, VIRGINIA

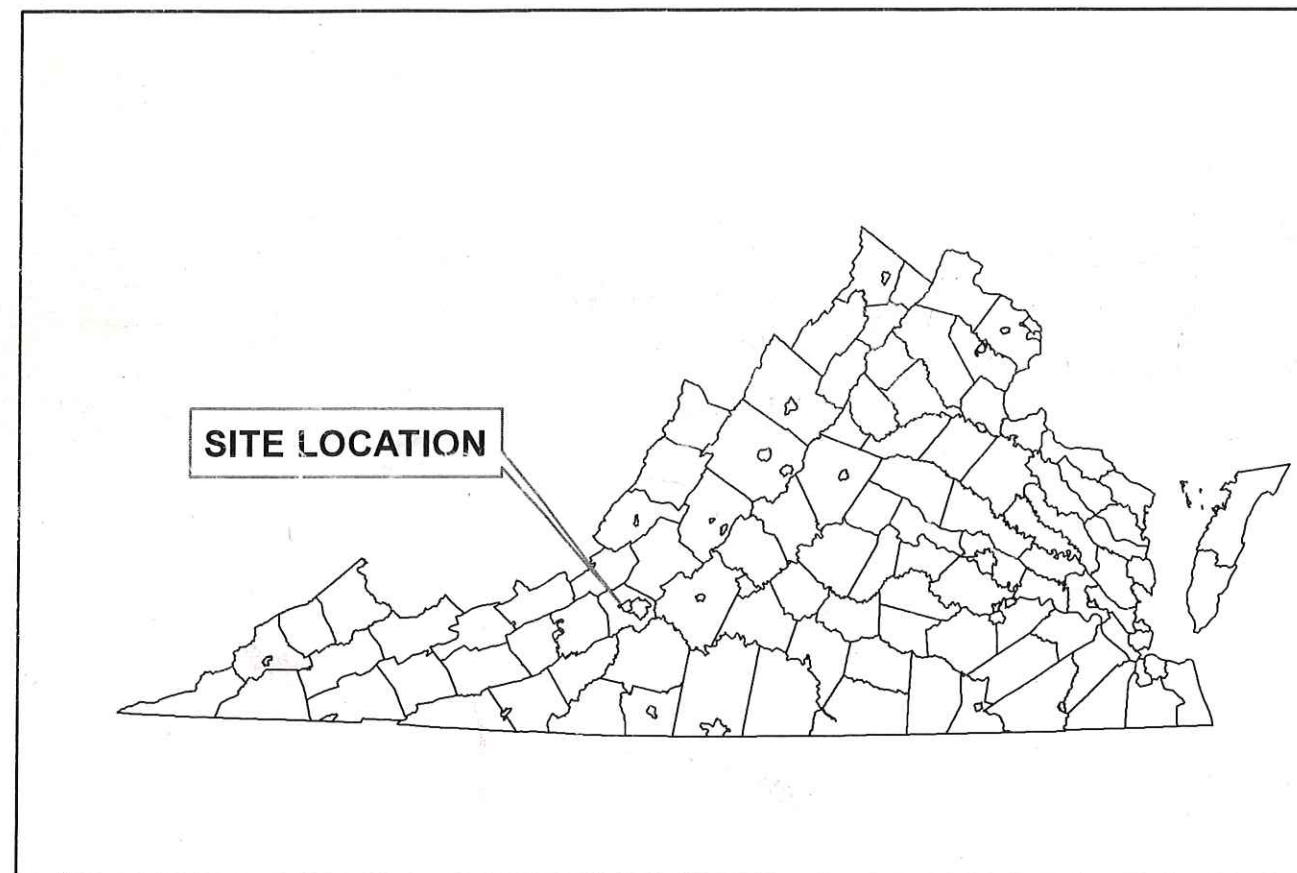

**VICINITY MAP**  
SCALE: NOT TO SCALE

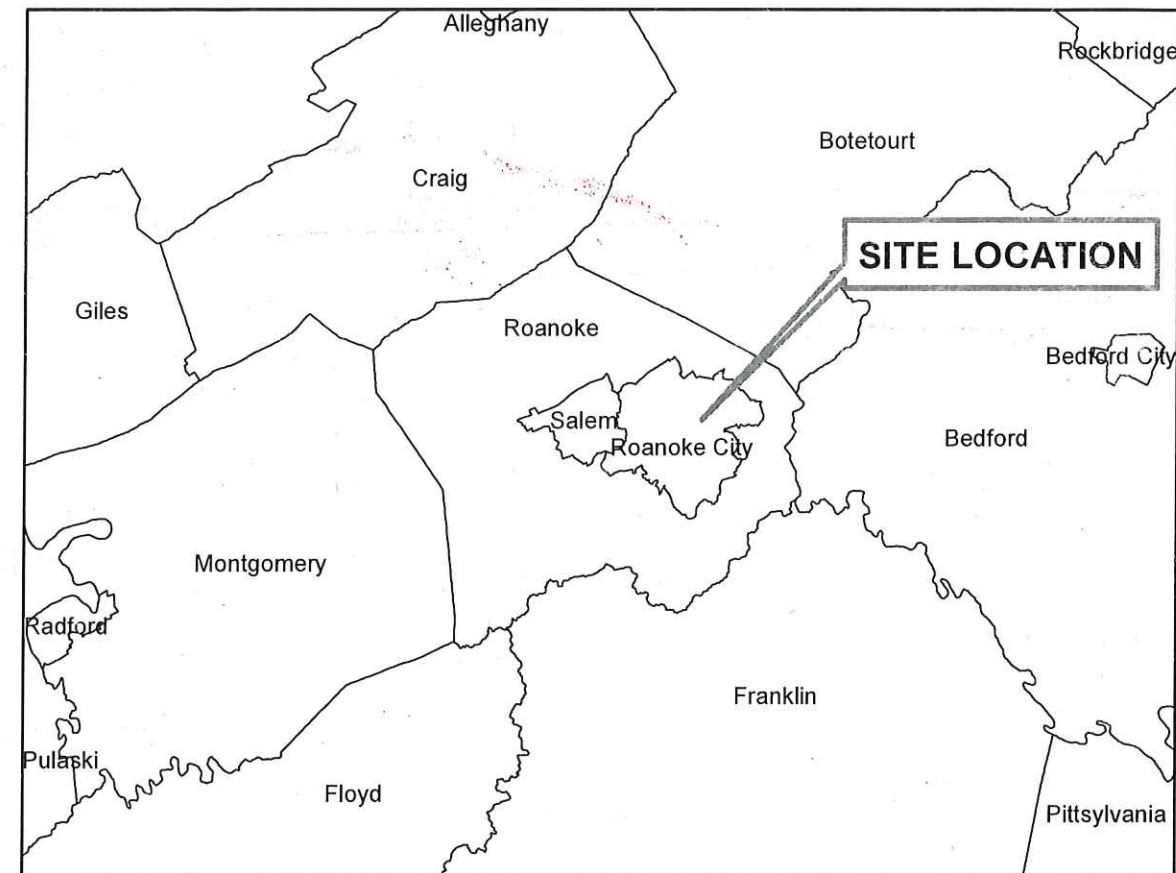

**LOCATION MAP**  
SCALE: NOT TO SCALE



THIS SEAL IS VALID FOR THE PERSON WHOSE NAME IS HEREIN SET FORTH. IT IS THE DUTY OF THE ENGINEER TO MAINTAIN THE SEAL IN GOOD STANDING. THE SEAL IS THE PROPERTY OF THE BOARD OF PROFESSIONAL ENGINEERS AND SURVEYORS OF THE STATE OF VIRGINIA. IT IS ILLEGAL TO REUSE OR ALTER THE SEAL IN ANY MANNER. THE SEAL IS VALID FOR THE PERSON WHOSE NAME IS HEREIN SET FORTH. IT IS THE DUTY OF THE ENGINEER TO MAINTAIN THE SEAL IN GOOD STANDING. THE SEAL IS THE PROPERTY OF THE BOARD OF PROFESSIONAL ENGINEERS AND SURVEYORS OF THE STATE OF VIRGINIA. IT IS ILLEGAL TO REUSE OR ALTER THE SEAL IN ANY MANNER.

| No. | Submittal/Revision | App'd. | By  | Date     |
|-----|--------------------|--------|-----|----------|
|     |                    |        |     |          |
|     |                    |        |     |          |
|     |                    |        |     |          |
|     |                    |        |     |          |
| -   | Bid Issue          | DBH    | KJV | 10/07/16 |
| A   | 50% Submission     | DBH    | KJV | 05/12/16 |

CONTRACT 1 -  
2016 SANITARY SEWER REHABILITATION

COVER

|                     |                             |              |
|---------------------|-----------------------------|--------------|
| Designed By:<br>KJV | Project No:<br>31237        | Drawing No.: |
| Drawn By:<br>KJV    | Scale:<br>AS SHOWN          | <b>G-001</b> |
| Checked By:<br>DBH  | Issue Date:<br>October 2016 |              |

As-Builts 6.29.18 K. Winslow