

WESTERN VIRGINIA WATER AUTHORITY CONTRACT 3 - FY17 SANITARY SEWER REPLACEMENTS

PATTERSON AVE NORTH & SOUTH, KENWOOD BLVD, GREENBRIER AVE,
EPPERLEY AVE, EMBASSY DR, SMH-07A-0005.0




VICINITY MAP
1" = 5000'

ASBUILTS
By KH/DAB

PREPARED FOR:
WESTERN VIRGINIA WATER AUTHORITY
601 S. JEFFERSON ST
ROANOKE, VA 24011
TELEPHONE: 540-853-5700
FAX: 540-283-8217

PREPARED BY:
CHA CONSULTING
1901 INNOVATION DR, SUITE 2100
BLACKSBURG, VIRGINIA 24060
TELEPHONE: 540-552-5548
FAX: 540-552-5577

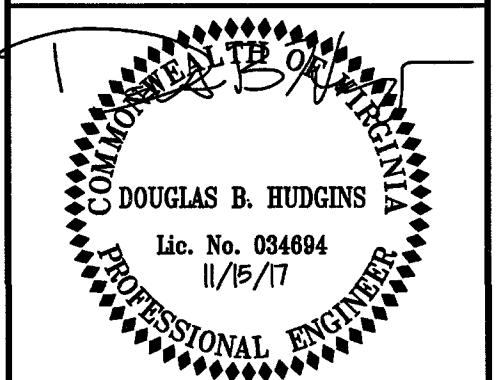

IT IS A VIOLATION OF LAW FOR ANY PERSON, UNLESS THEY ARE ACTING UNDER THE DIRECTION OF A LICENSED PROFESSIONAL ENGINEER, ARCHITECT, LANDSCAPE ARCHITECT OR LAND SURVEYOR TO ALTER IN ANY MANNER THE SEALING, STAMPING OR SIGNATURE OF A LICENSED PROFESSIONAL ENGINEER, ARCHITECT, LANDSCAPE ARCHITECT OR LAND SURVEYOR. ANY PERSON WHO VIOLATES THIS SECTION SHALL BE SUBJECT TO THE DISCIPLINARY ACTION OF THE BOARD OF PROFESSIONAL ENGINEERS, ARCHITECTS, LANDSCAPE ARCHITECTS AND LAND SURVEYORS. ANY PERSON WHO VIOLATES THIS SECTION SHALL BE SUBJECT TO THE DISCIPLINARY ACTION OF THE BOARD OF PROFESSIONAL ENGINEERS, ARCHITECTS, LANDSCAPE ARCHITECTS AND LAND SURVEYORS.

WESTERN VIRGINIA
WATER AUTHORITY
CONTRACT 3 - FY17
SANITARY SEWER
REPLACEMENT

No.	Submittal / Revision	App'd.	By	Date
1	50% SUBMITTAL		DBH	11/28/16
2	100% CLIENT SUBMITTAL		DBH	10/23/17
3	BID ISSUE		DBH	11/15/17
6	CONSTRUCTION ISSUE		DBH	03/02/18

TITLE SHEET

Designed By: JRM	Drawn By: GLM	Checked By: DBH
Issue Date: 10-23-17	Project No.: 31237	Scale: AS NOTED

Drawing No.:

G-001

AS-BUILTS
CHARLES CRUSH
06-06-19