




FAIRCRESS & BELLVIEW
COOPER HOMES AM COOPER
WATER ASBUILTS

BO TO 8'6V 1# IS 28'
 1'8'6V TO DI 2 IS 4.3 FROM SAME DI 2 TO BO IS 28'
 FROM 8'6V 2 TO 8'6V 3 IS 12'
 FROM FH 4 TO 8'6V 2 IS 41.2
 11 11 11 8'6V 3 IS 52.8
 FROM 8'6V 4 TO 8'6V 5 IS 14'
 FROM FH 5 TO 8'6V 4 IS 7
 11 11 11 8'6V 5 IS 15'
 FROM 6V 6 TO 6V 7 IS 12.8
 FROM LEFT FRONT CORNER OF DI 11 TO 8'6V 6 IS 14.2
 11 11 11 11 11 TO 8'6V 7 IS 18.2
 FROM 8'6V 8 TO 8'6V 9 IS 4' FROM STAKE WATER METER ON LOT 1
 TO 6V 8 IS 13' AND TO 9 IS 10.4
 ON FIRE HYDRANTS 2, 2, 4, IS 2' FROM FH TO 6V AND 2'
 FROM 6V TO TEE
 ON FIRE HYDRANT 3 IS 2' FROM TEE TO 6V AND
 FROM 6V TO FH IS 12.7
 FROM 8'6V 10 TO 8'6V 11 IS 7'
 FROM BACK LEFT CORNER OF DI 12 TO 8'6V 11 IS 12.3
 11 11 11 DI 19 TO 8'6V 10 IS 13'
 FROM 8'6V 10 UP HILL TO BERKELEY IS 45 BEND IT IS 20'
 FROM TAPPING VAULT OUT PASSED PRI VAULT TO 45 IS 32'
 FROM 8'6V 11 BACK TO INTERSECTION IS 13.6 TO 45 BEND
 FROM 8'6V 9 DOWN HILL TOWARD CALDERA TO 8" PEPPER COPPING
 IS 30'

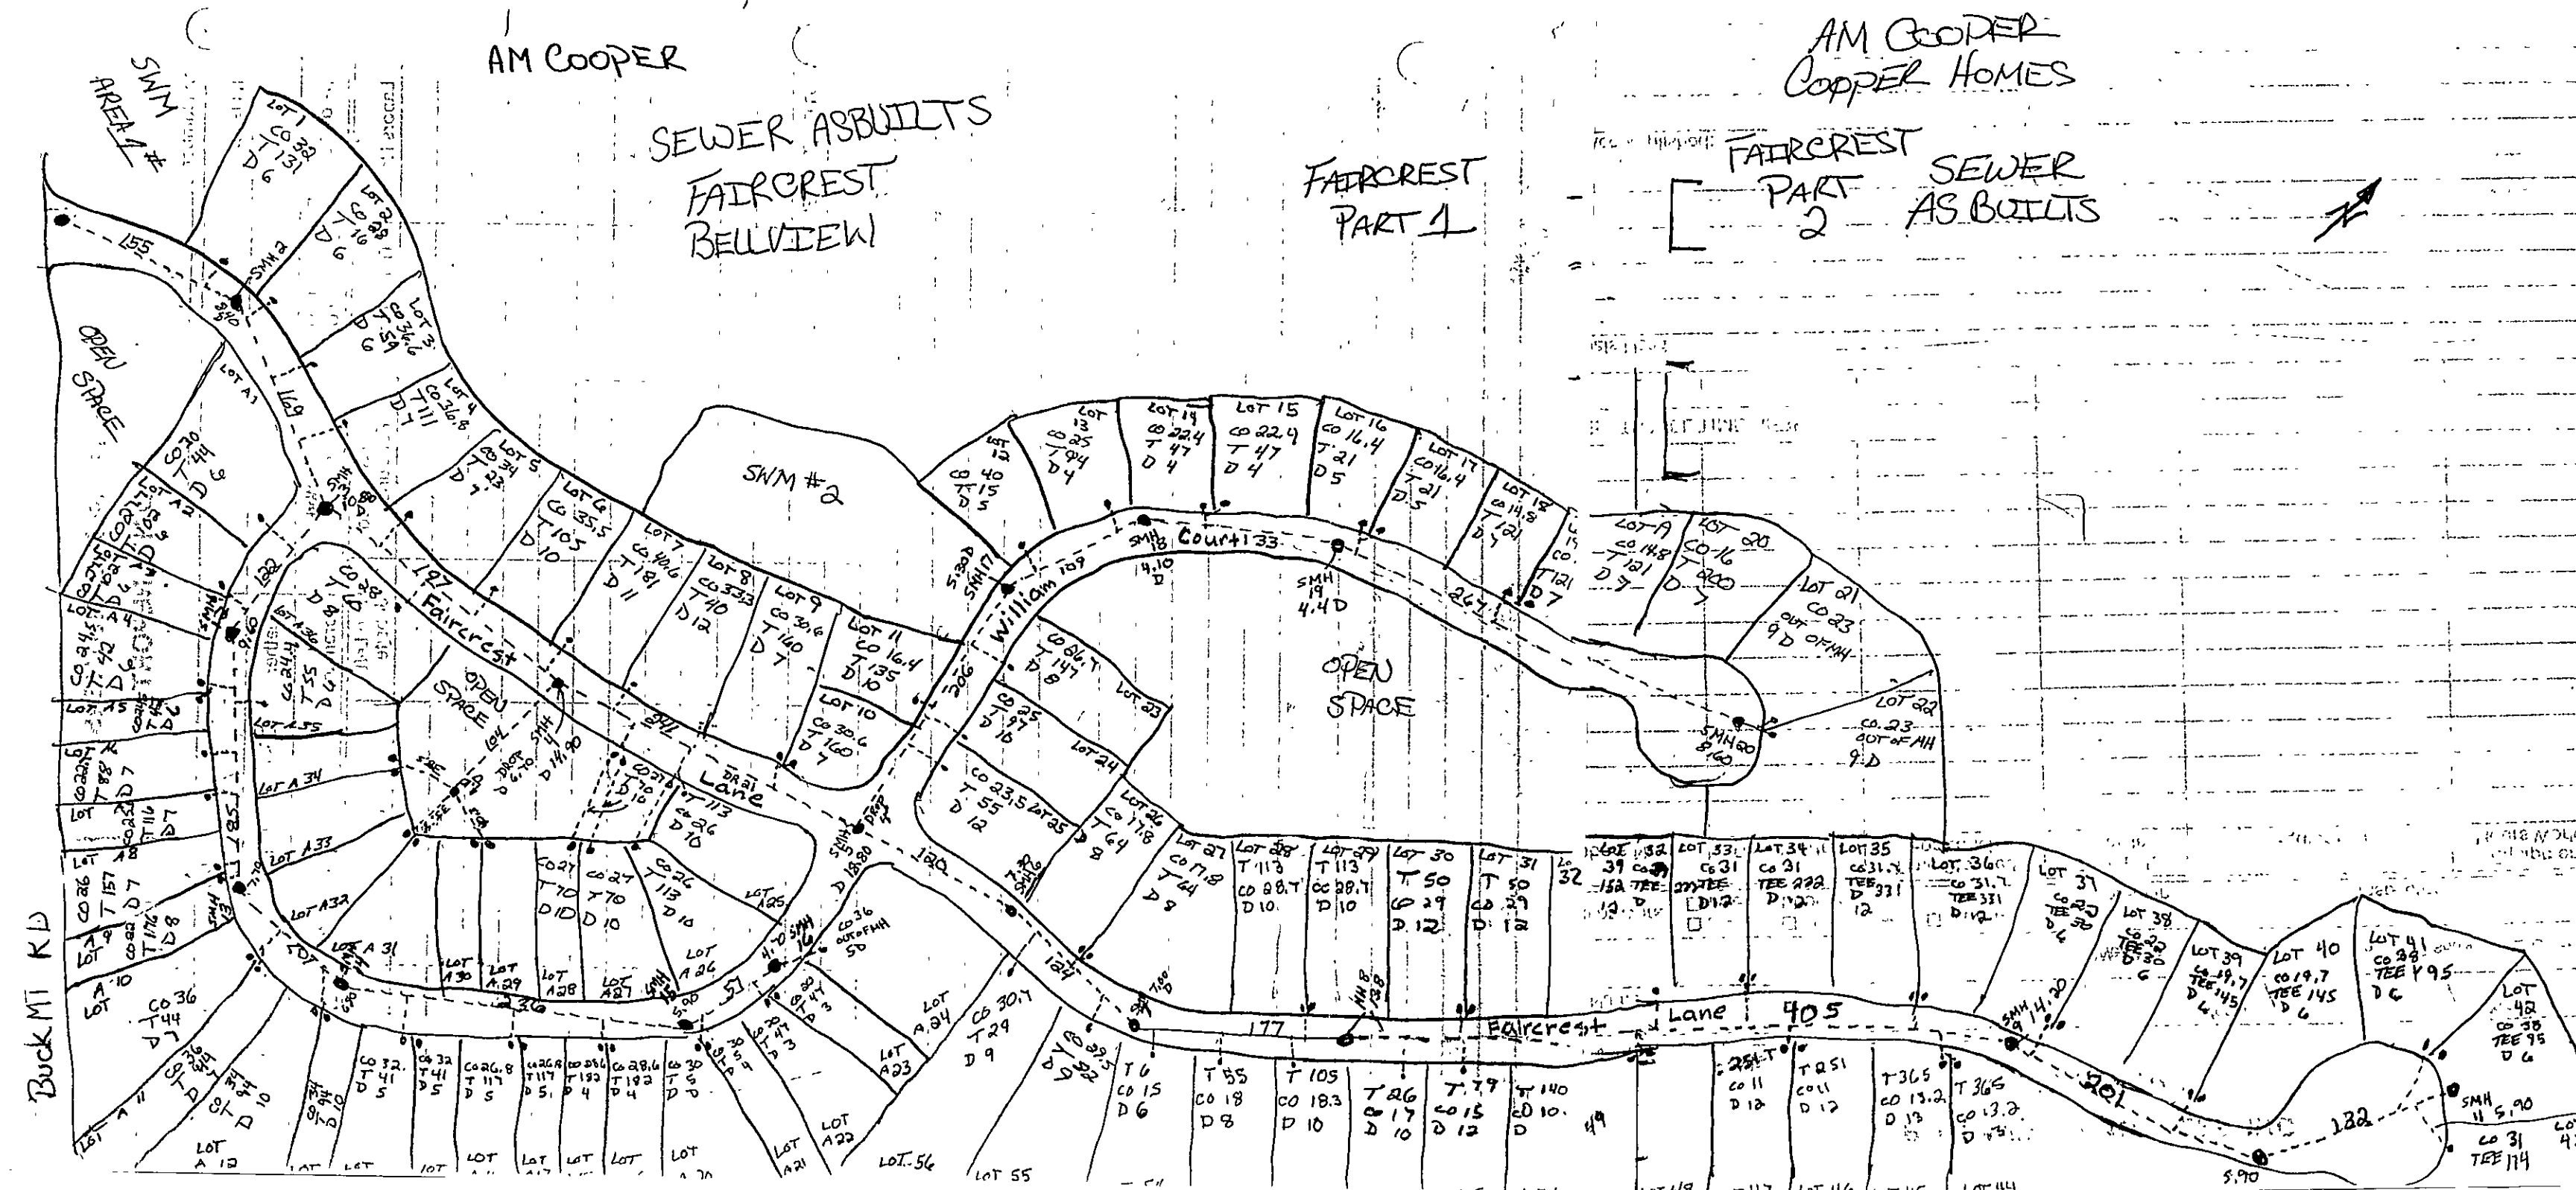