


AS-BUILT - THE FAIRFAX
04-13-2007

04226comp ss revision-layout1

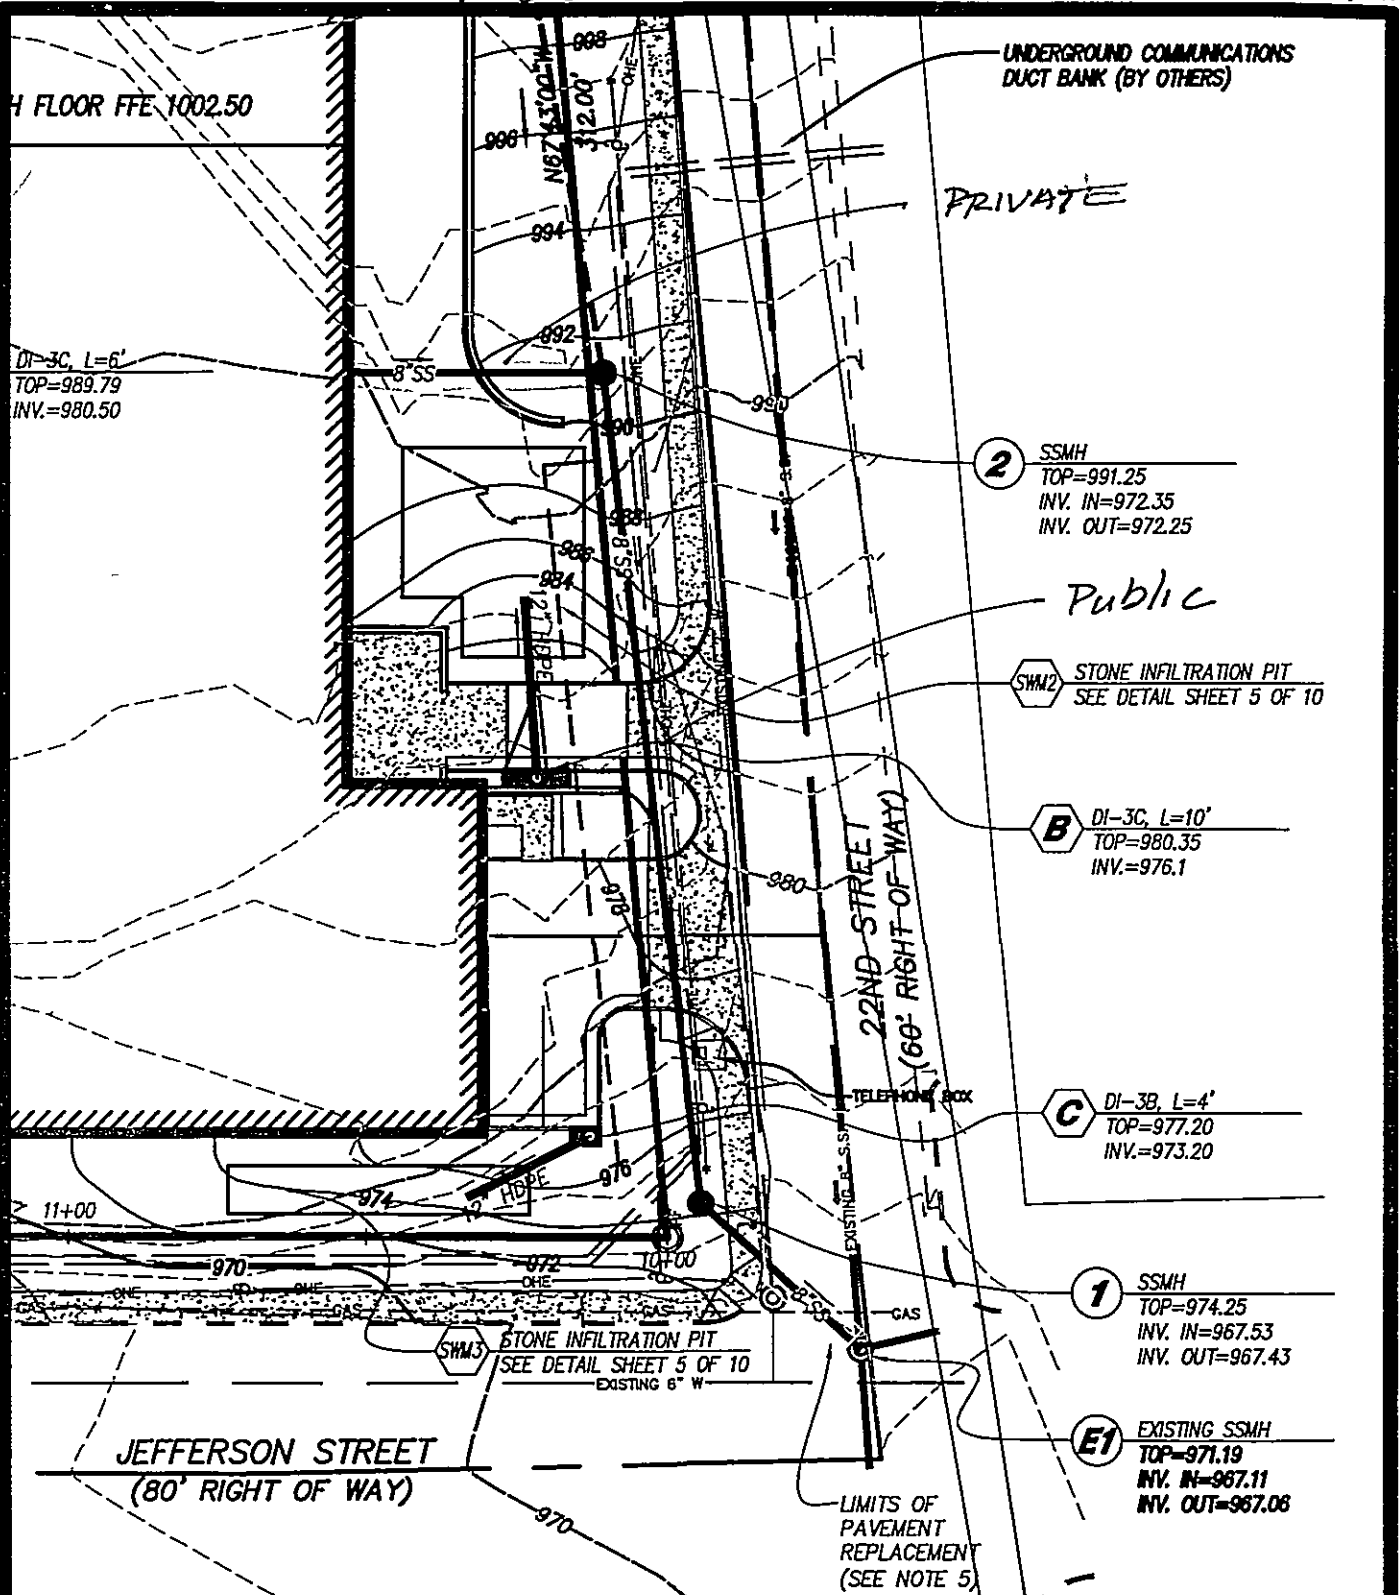

DATE: May 22, 2006

SCALE: 1" = 30'

COMM. NO.: 04-226



LUMSDEN ASSOCIATES, P.C.
ENGINEERS-SURVEYORS-PLANNERS
ROANOKE, VIRGINIA

4664 BRAMBLETON AVENUE
P.O. BOX 20669
ROANOKE, VIRGINIA 24018

PHONE: (540) 774-4411
FAX: (540) 772-9445
E-MAIL: MAIL@LUMSDENPC.COM

w:\drawings\2004\04226\eng\04226comp ss revision.dwg

File = 22nd St.

TAF 7.13.07