


FAIRHOPE ROAD SEWER EXTENSION RECORD DRAWING

Site Map

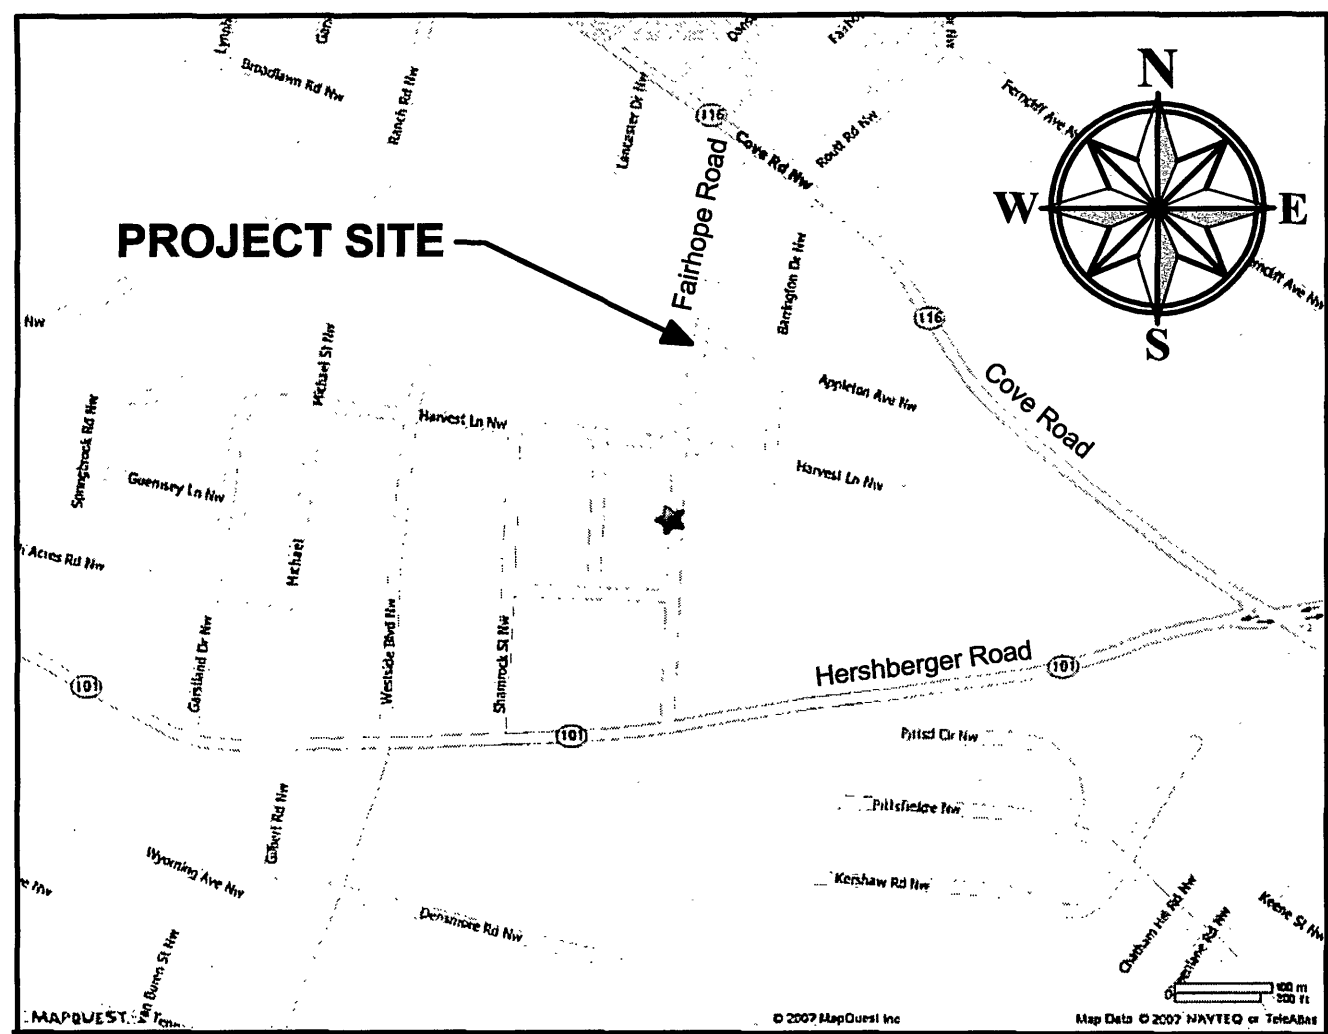

INDEX OF ABBREVIATIONS

ABAN	ABANDONED	FIG	FIGURE	PVC	POINT OF VERTICAL
AC	ACRES	FIN	FINISH	PVI	POINT OF VERTICAL
ADJ	ADJACENT	FLG	FLANGE		INTERSECTION
AGGR	AGGREGATE	FM	FORCE MAIN	PVMT	PAVEMENT
ALUM	ALUMINUM	FT	FOOT, FEET	R	RADIUS
ANC	ANCHOR	FTG	FOOTING	R/W	RIGHT OF WAY
BC	BACK OF CURB	FUT	FUTURE	RCP	REINFORCED CONCRETE PIPE
BEG	BEGINNING	GAL	GALLON	RD	ROAD
BIT	BITUMINOUS	GALV	GALVANIZED	RDCR	REDUCER
BJ	BELL JOINT	GAR	GARAGE	REF	REFERENCE
BL	BASE LINE	GND	GROUND	REINF	REINFORCEMENT
BLDG	BUILDING	GOVT	GOVERNMENT	REL	RELOCATED
BM	BENCH MARK	GPD	GALLONS PER DAY	REQD	REQUIRED
BO	BLOW-OFF VALVE	GPM	GALLONS PER MINUTE	REV	REVISION
BSP	BLACK STEEL PIPE	GR	GRAVEL	RR	RAILROAD
BY	BUTTERFLY VALVE	GRG	GRATING	RTE	ROUTE
BVCE	BEGIN VERTICAL CURVE ELEVATION	GV	GATE VALVE	SW	SIDEWALK
BVCS	BEGIN VERTICAL CURVE STATION	H&T	HUB AND TAC	SAN	SANITARY
C&G	CURB AND GUTTER	H&T	HUB AND TAC	SBL	SOUTHBOUND LANE
CB	CATCH BASIN	H&T	HUB AND TAC	SD	STORM DRAIN
CI	CAST IRON	H&T	HUB AND TAC	SE	SLOPE EASEMENT
CL	CENTER LINE	H&T	HUB AND TAC	SEC	SECTION
CMR	CORRUGATED METAL PIPE	H&T	HUB AND TAC	SF	SQUARE FEET
CMU	CONCRETE MASONRY UNITS	H&T	HUB AND TAC	SH	SHEET
CO	CLEANOUT	H&T	HUB AND TAC	SIM	SIMILAR
COE	U.S. ARMY CORPS OF ENGINEERS	H&T	HUB AND TAC	SMH	SEWER MANHOLE
COL	COLUMN	H&T	HUB AND TAC	SPEC	SPECIFICATION
COMB	COMBINATION	H&T	HUB AND TAC	SQ	SQUARE
CONC	CONCRETE	H&T	HUB AND TAC	SS	SANITARY SEWER
CONST	CONSTRUCTION	H&T	HUB AND TAC	SSSD	SAFE STOPPING SIGHT
CONV	CONVEYOR	H&T	HUB AND TAC		DISTANCE
COR	CORNER	H&T	HUB AND TAC	ST	STREET
CTR	CENTER	H&T	HUB AND TAC	STA	STATION
CTV	CABLE TELEVISION	H&T	HUB AND TAC	STD	STANDARD
CULV	CULVERT	H&T	HUB AND TAC	SUR	SURVEY
D	DEPTH	H&T	HUB AND TAC	SVC	SERVICE
D/W	DRIVEWAY	H&T	HUB AND TAC	TEL	TELEPHONE
DE	DRAINAGE EASEMENT	H&T	HUB AND TAC	TEMP	TEMPORARY
DEQ	VIRGINIA DEPARTMENT OF	H&T	HUB AND TAC	TP	TELEPHONE POLE
ENVIRONMENTAL	QUALITY	H&T	HUB AND TAC	TRTD	TREATED
DI	DROP INLET	H&T	HUB AND TAC	TW	TOP OF WALL
DIA, Ø	DIAMETER	H&T	HUB AND TAC	TYP	TYPICAL
DIM	DIMENSION	H&T	HUB AND TAC	UE	UNDERGROUND ELECTRIC
DIP	DUCTILE IRON PIPE	H&T	HUB AND TAC	UG	UNDERGROUND GAS
DISC	DISCONNECT	H&T	HUB AND TAC	UGD	UNDERGROUND
DMS	DROP MANHOLE	H&T	HUB AND TAC	UL	UNDERWRITERS LABORATORY
DOC	DEGREE OF CURVE	H&T	HUB AND TAC	UN	UNLESS OTHERWISE NOTED
DTL	DETAIL	H&T	HUB AND TAC	USGS	U.S. GEOLOGIC SURVEY
DWG	DRAWING	H&T	HUB AND TAC	UT	UNDERGROUND TELEPHONE
DWL	DWELLING	H&T	HUB AND TAC	V	VENT
EA	EACH	H&T	HUB AND TAC	VAL	VALVE
EBL	EASTBOUND LANE	H&T	HUB AND TAC	VAR	VARIABLE
EF	EACH FACE	H&T	HUB AND TAC	VC	VERTICAL CURVE
ELEC	ELECTRICAL	H&T	HUB AND TAC	VCH	VIRGINIA DEPARTMENT OF
ELEV	ELEVATION	H&T	HUB AND TAC	VDOT	VIRGINIA DEPARTMENT OF
ENGR	ENGINEER	H&T	HUB AND TAC	VERT	VERTICAL
ENTR	ENTRANCE	H&T	HUB AND TAC	VESCH	VIRGINIA EROSION AND
EOL	END OF LINE	H&T	HUB AND TAC		SEDIMENT CONTROL
EP	EDGE OF PAVEMENT	H&T	HUB AND TAC		HANDBOOK
EQ	EQUAL	H&T	HUB AND TAC	VNL	VINYL
EQPT	EQUIPMENT	H&T	HUB AND TAC	VOL	VOLUME
EVCE	END VERTICAL CURVE ELEVATION	H&T	HUB AND TAC	W	WATER
EVCS	END VERTICAL CURVE STATION	H&T	HUB AND TAC	W/O	WITHOUT
EW	EACH WAY	H&T	HUB AND TAC	WBL	WESTBOUND LANE
EXST	EXISTING	H&T	HUB AND TAC	WL	WATER LINE
EXT	EXTENSION	H&T	HUB AND TAC	WM	WATER METER
FC	FACE OF CURB	H&T	HUB AND TAC	WMH	WATER MANHOLE
FEMA	FEDERAL EMERGENCY	H&T	HUB AND TAC	WS	WATER SURFACE
MANAGEMENT AGENCY		H&T	HUB AND TAC	WT	WATER TIGHT
FES	FLARED END SECTION	H&T	HUB AND TAC	WTT	WATER TIGHT
FPE	FINISHED FLOOR ELEVATION	H&T	HUB AND TAC	WV	WATER VALVE

INDEX OF SYMBOLS

EXISTING	NEWLY INSTALLED	DESCRIPTION
		BUILDING WITH PORCH OR STOOP
		FOUNDATION ONLY
		CONTOUR, CONTOUR WITH ELEVATION
		SPOT ELEVATION
		CONCRETE CURB
		CONCRETE CURB & GUTTER
		CONCRETE WALK OR SLAB
		PAVEMENT
		UNPAVED OR GRAVEL ROAD
		TREE LINE
		TREE OR SHRUB
		FENCE (EXISTING OR PROPOSED NOTED)
		CENTERLINE CREEK, SWALE, DITCH
		PROPERTY LINE
		CENTERLINE OR BASELINE
		FIELD SURVEY TRAVERSE POINT
		GEOLOGIC BORE HOLE
		BENCH MARK (EXISTING OR SET NOTED)
		STORM DRAIN
		SANITARY SEWER
		FORCE MAIN
		GAS MAIN OR SERVICE LINE
		WATER MAIN OR SERVICE LINE
		OVERHEAD ELECTRICAL LINE
		OVERHEAD TELEPHONE LINE
		UNDERGROUND ELECTRICAL LINE
		UNDERGROUND TELEPHONE LINE
		PIPE FITTINGS
		FIRE HYDRANT
		GATE VALVE
		CLEANOUT
		MANHOLE
		DROP INLET (CURB AND GRATING TYPES)
		VM - WATER METER
		DWM - DOUBLE WATER METER
		UTILITY POLE
		LIGHT POLE
		TELEPHONE PEDESTAL
		BURIED TELEPHONE VAULT
		PAVED DITCH
		CULVERT WITH FLARED END SECTION
		AIR RELEASE VALVE / VAULT ASSEMBLY
		BLOW OFF VALVE / VAULT ASSEMBLY
		STEEL ENCASEMENT
		CONCRETE ENCASEMENT
		ABANDON OR REMOVE
		LIMITS OF DISTURBED AREA
		WATERLINE PLUG

Sheet Index

C1 Cover Sheet
C2 Sewer Plan

Design Engineer


**ACS
DESIGN**

ENGINEERING • SURVEYING
LANDSCAPE ARCHITECTURE
CONSTRUCTION MANAGEMENT

2203 PETERS CREEK ROAD
ROANOKE, VIRGINIA 24017
P 540.562.2345 F 562.2344
INFO@ACSDSIGNLLC.COM
WWW.ACSDSIGNLLC.COM

RECORD DRAWING

Rev	Description	Date	By	Designed: DME
1				Drawn: KMF
				Checked: DME
				Approved: DME
				Date: 30 NOV 2009
				Project: 07248C
				C1
				Sheet 1 of 2

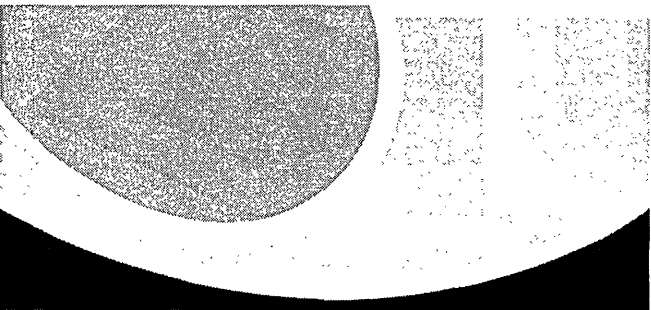

WESTERN VIRGINIA
WATER AUTHORITY

601 S. Jefferson Street
Suite 300
Roanoke, VA 24011
(540) 853-5641

